

No. 414202

3rd

Office of Register of Deeds,
State of Minnesota } ss.
County of Olmsted


I hereby certify that the within ins't.
was filed in this office, for record on the
24 day of May A.D., 1979, at
8 o'clock a M., and was duly
recorded in Book H-4 of Miss
on page 374

Law Institute
COUNTY RECORDER

Proved
Grantor
Grantee
Tracted
Pd.
Chg.
Mtg. Tax
Rev. Stamp

Deliver to Retain
Address Patterson Law

414202

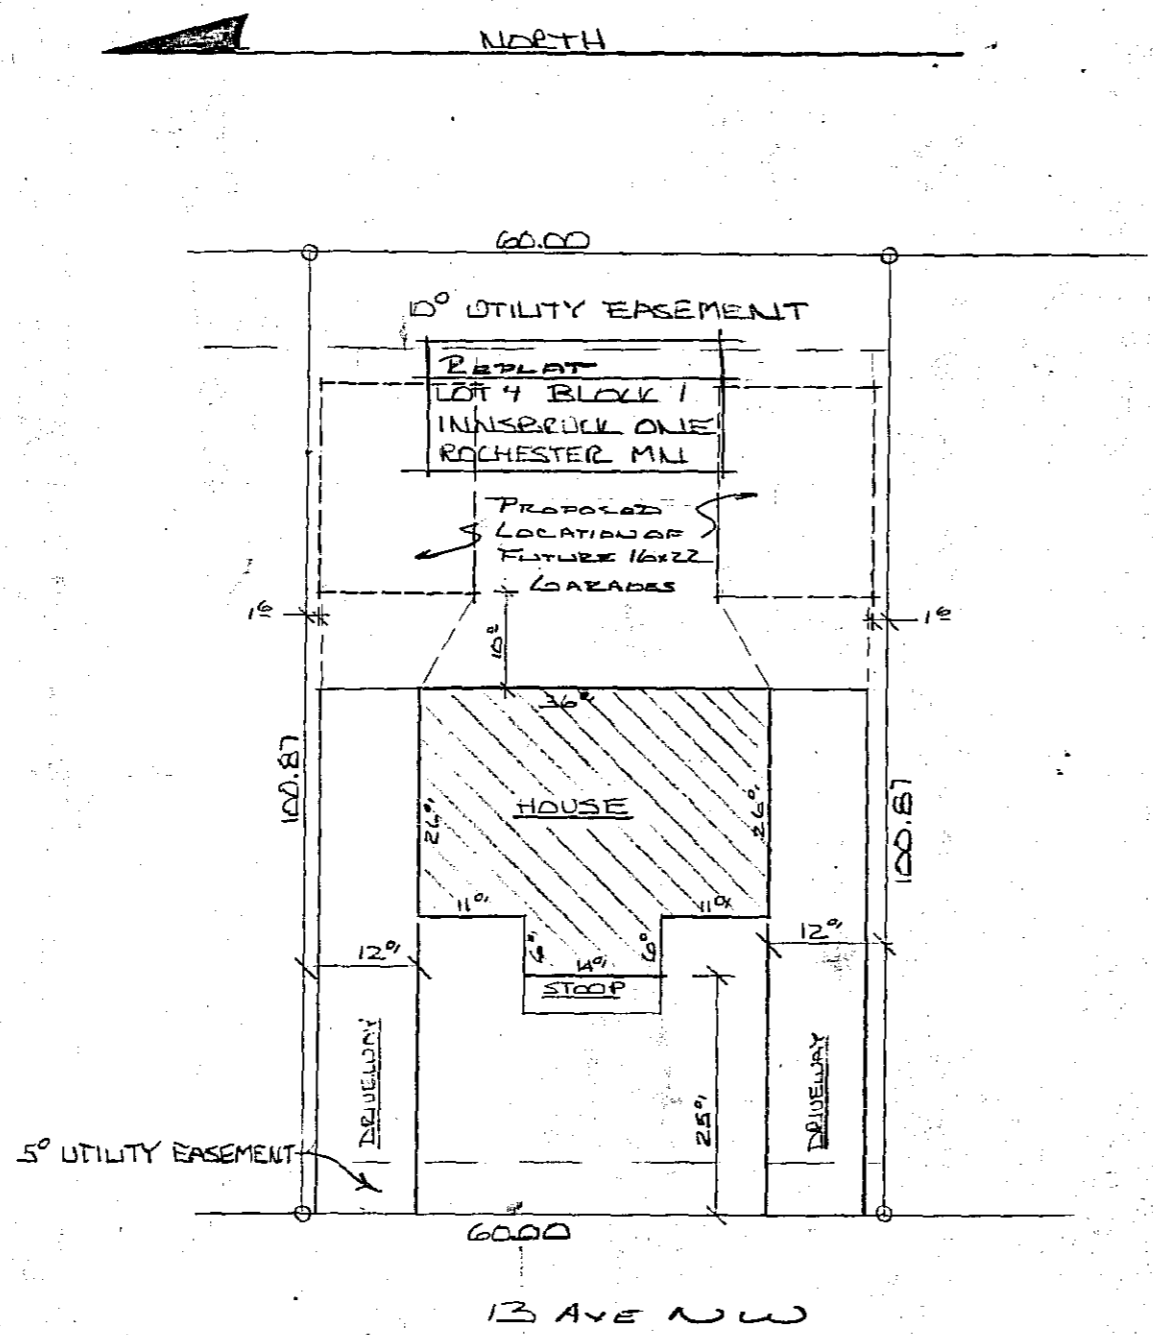


414202

CERTIFICATION

The undersigned, being a registered land surveyor, certifies that this plan is an accurate copy of portions of the plans of the building as filed with and approved by the municipal governmental subdivision having jurisdiction over the issuance of permits for the construction of buildings, and as built.

James E. Swanson
James E. Swanson
REGISTERED LAND SURVEYOR
STATE OF MINNESOTA

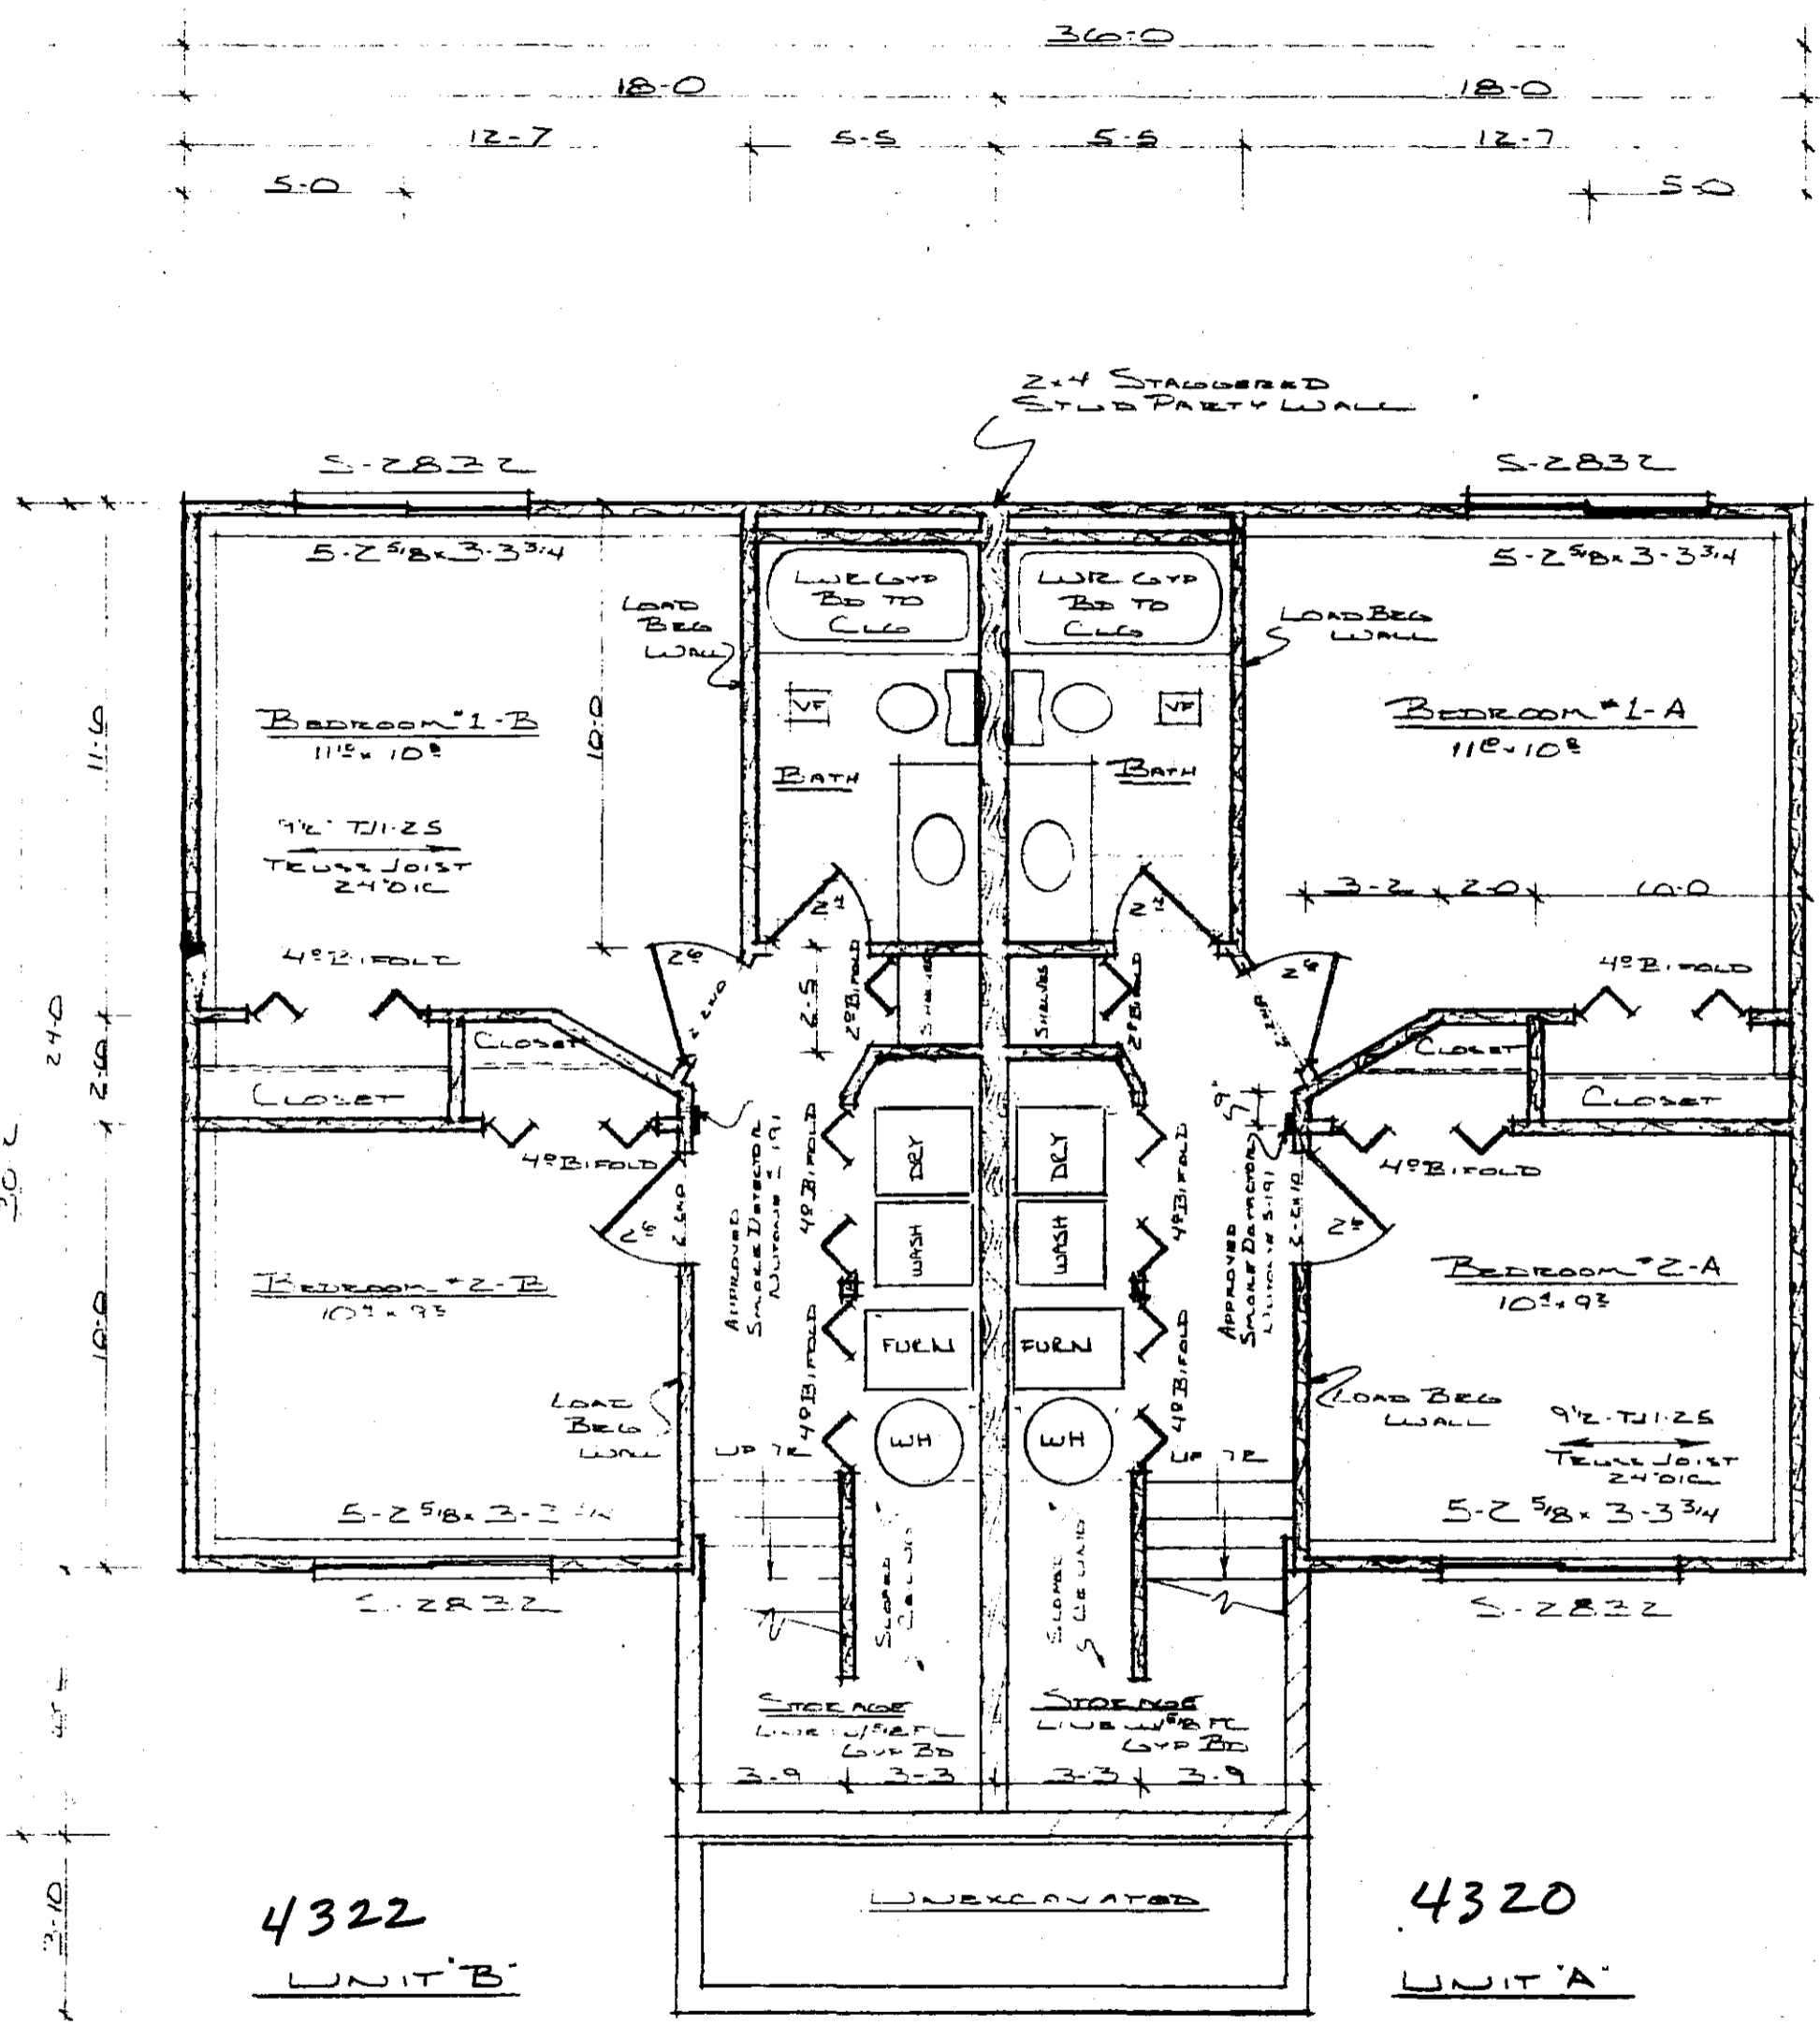


4322
UNIT B

4320
UNIT A

NOTICE
THE PLANS MUST BE ON CONSTRUCTION SITE AT ALL TIMES. CALL FOR ALL FINAL INSPECTIONS BEFORE OCCUPANCY OF BUILDING.

Each sleeping room is required to have at least one emergency window with not less than 5.7 sq. ft. operable area, with sill height not over 48 inches from floor line. Minimum clear height shall be 24". Minimum clear width shall be 20".

Sidewalks are required to be constructed within 8 months from the date of issuance of this permit, or as specified in the City Engineer. Ordinance 1543.
Permits to establish driveways or to construct curb cuts on public property are required to be obtained from the City Engineer. Ordinance 1187.

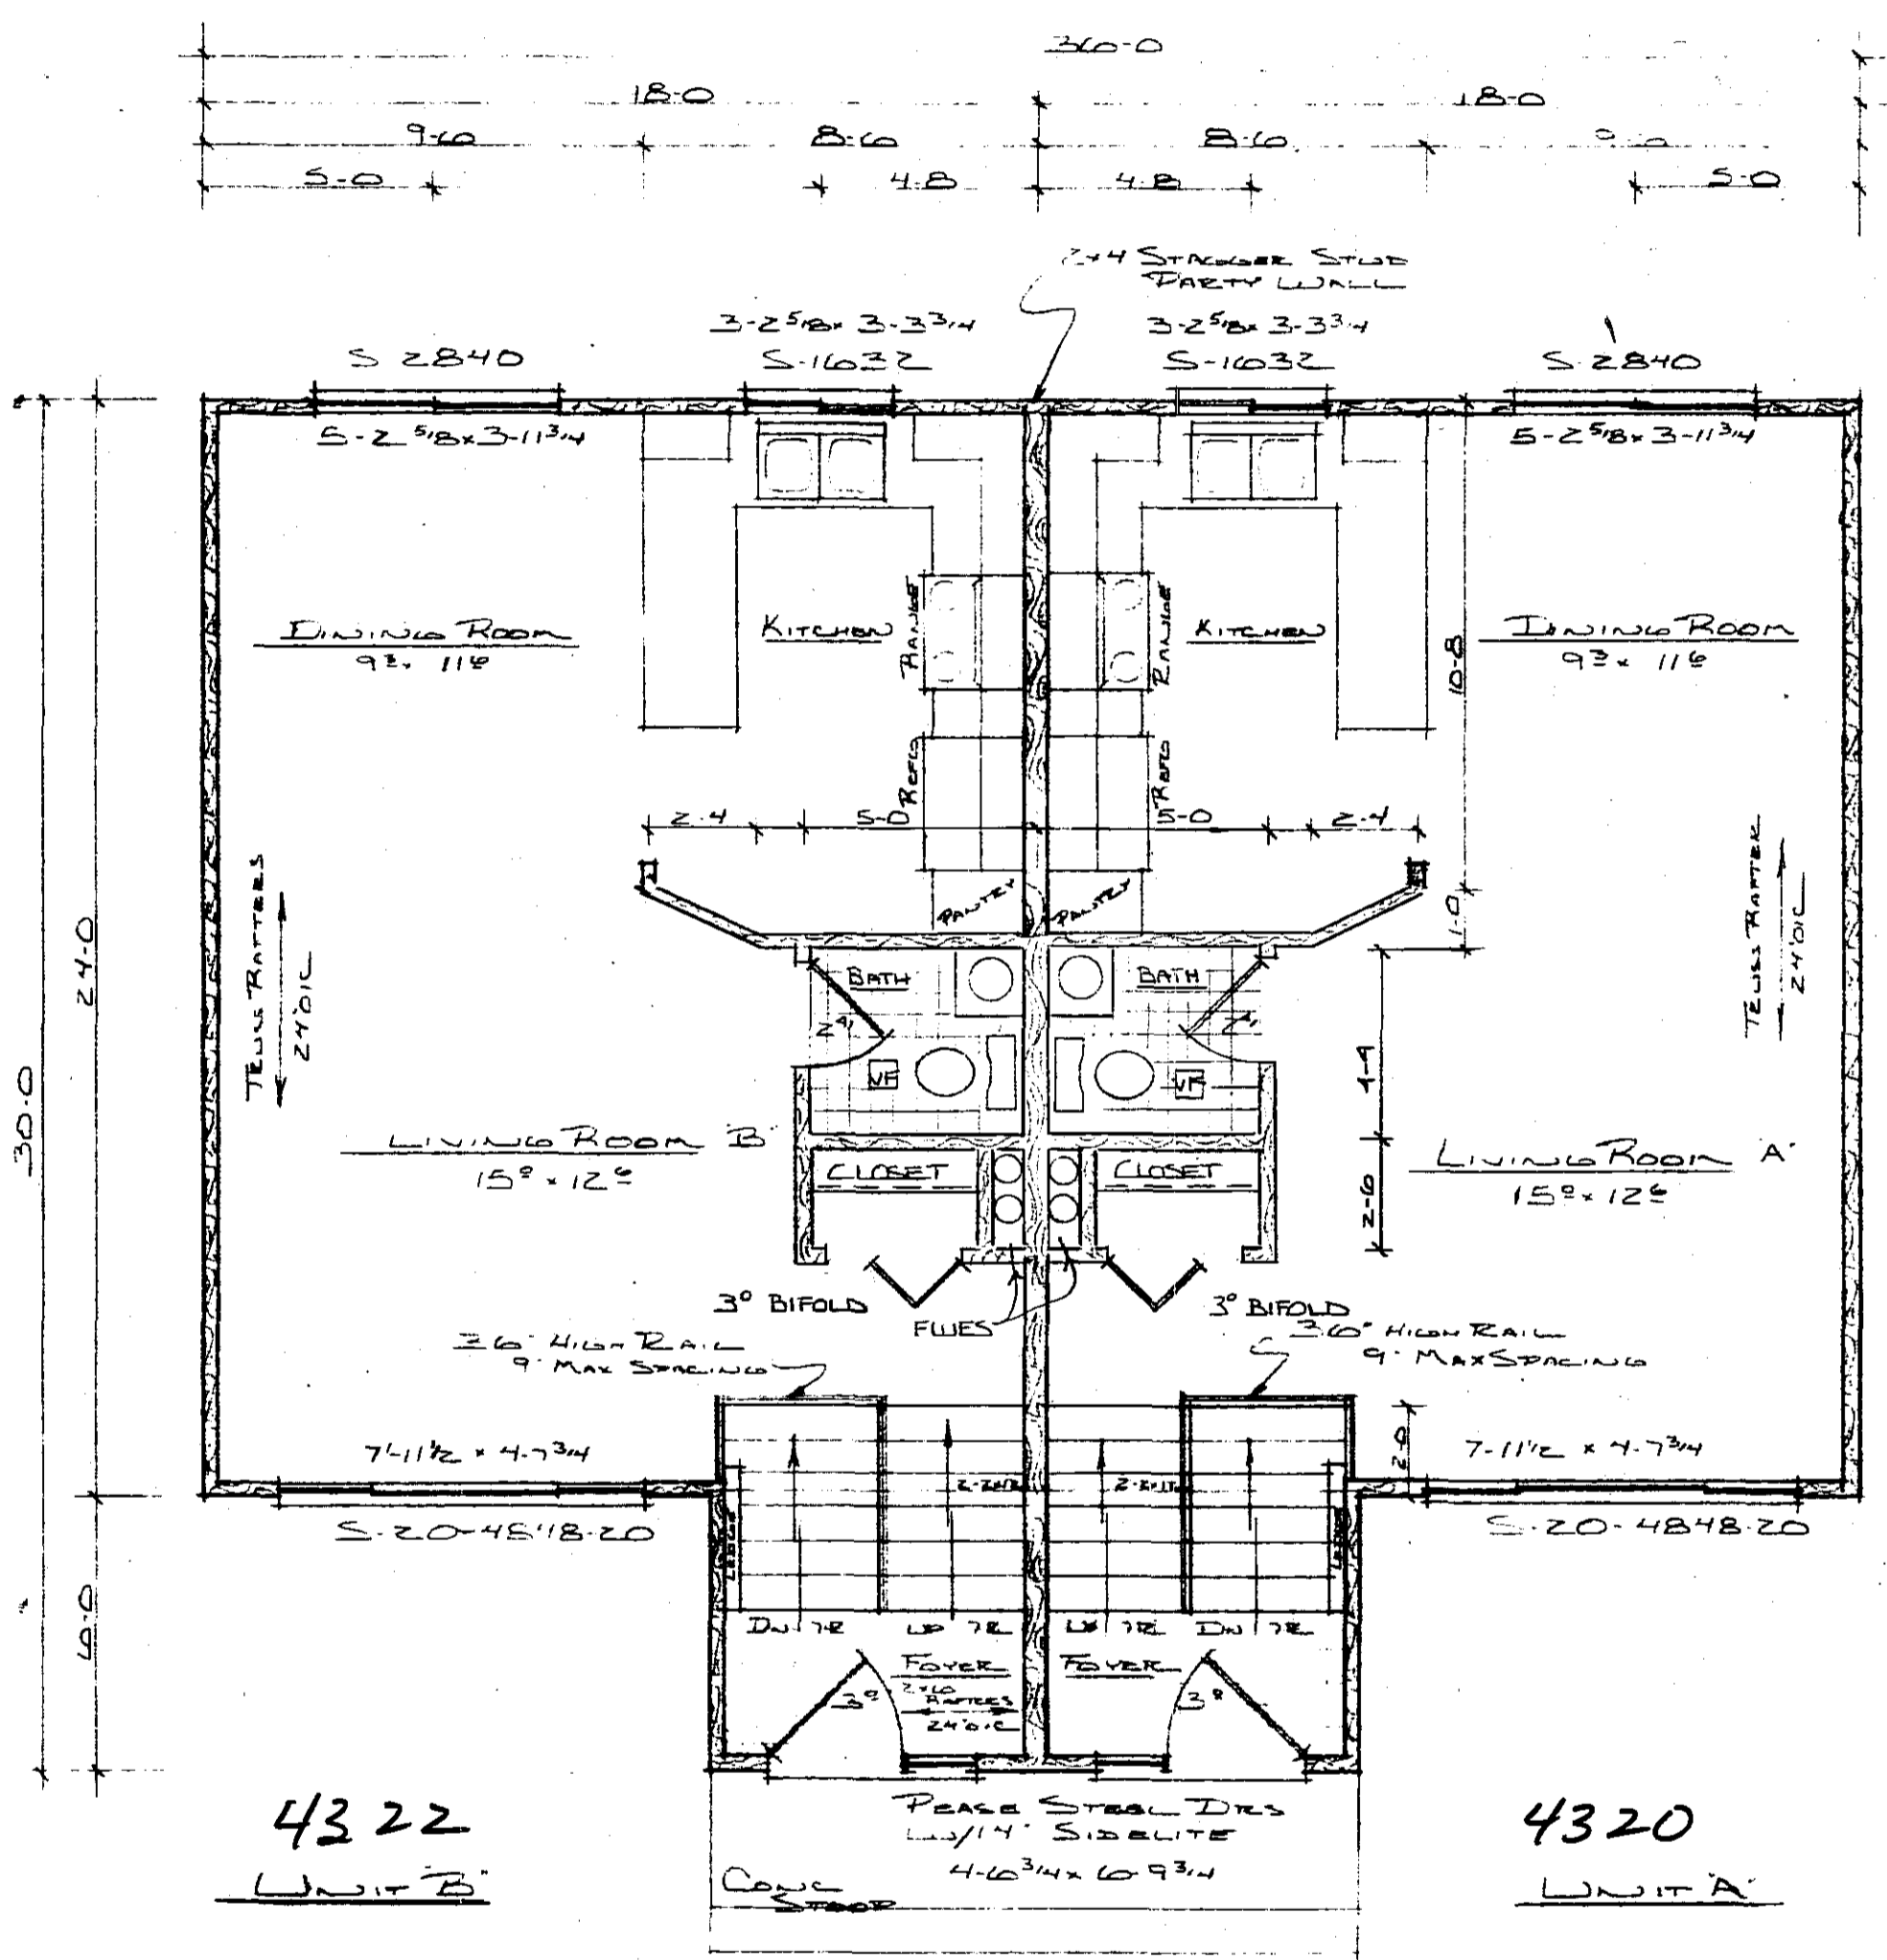

4322
UNIT B

4320
UNIT A

Identical to St. Plan #113 on file
APPROVED AS NOTED
James Olson 2/27/79

Building Name: Innsbruck II

FULLERTON'S

SCALE: As Shown	APPROVED BY:	DRAWN BY:
DATE: 11-27-78		ILLIUS
BILL BERG		DRAWING NUMBER:
		1
		BB 2020

This approval shall not be construed as a certificate or determination by the Building and Safety Dept. that these plans comply with all requirements of the building codes and ordinances of the City of Rochester and applicable State laws. The owner and his contracting agent are responsible for meeting all code, ordinance and statutory requirements and should deviations subsequently be determined or discovered, the owner and his contracting agent will be required to make necessary corrections or additions.

Provide adequate protection against Freezing for all Concrete and Masonry Work. Verify method used.



CEILING AREAS

- 1 1/4" EXT AIR FILM 1.22
- 5/8" GYP BD .45
- 10" CELLULOSE 37.00
- INSUL CUR 38.67
- 1 1/4" EXT AIR FILM 1.22
- 5/8" GYP BD .45
- 3/2" SOFTWOOD 4.48
- 6" CELLULOSE 24.00
- FRAMA CUR 30.15

WALL AREAS



- 1 1/4" EXT AIR FILM .85
- 1/2" GYP BD .45
- 3 1/2" FOAM INSUL 11.00
- 1/2" INTER STD 1.22
- SIDING .67
- INSUL WALLS 14.19
- 1 1/4" EXT AIR FILM .85
- 1/2" GYP BD .45
- 3/2" SOFTWOOD 4.48
- 1/2" INTER STD 1.22
- SIDING .67
- FRAMA CUR 7.67
- 1 1/4" EXT AIR FILM .85
- 3 1/2" FOAM INSUL 11.00
- 3/8" PLYWOOD .47
- 1/2" INTER STD 1.22
- SIDING .67
- Box END 19.21
- 1 1/4" EXT AIR FILM .85
- 1/2" GYP BD .45
- 1 1/2" FOAM-BD 5.35
- 8" BLOCK 1.11
- Block Walls 7.76

PARTY WALL DETAIL
- 1 1/2" x 10" -

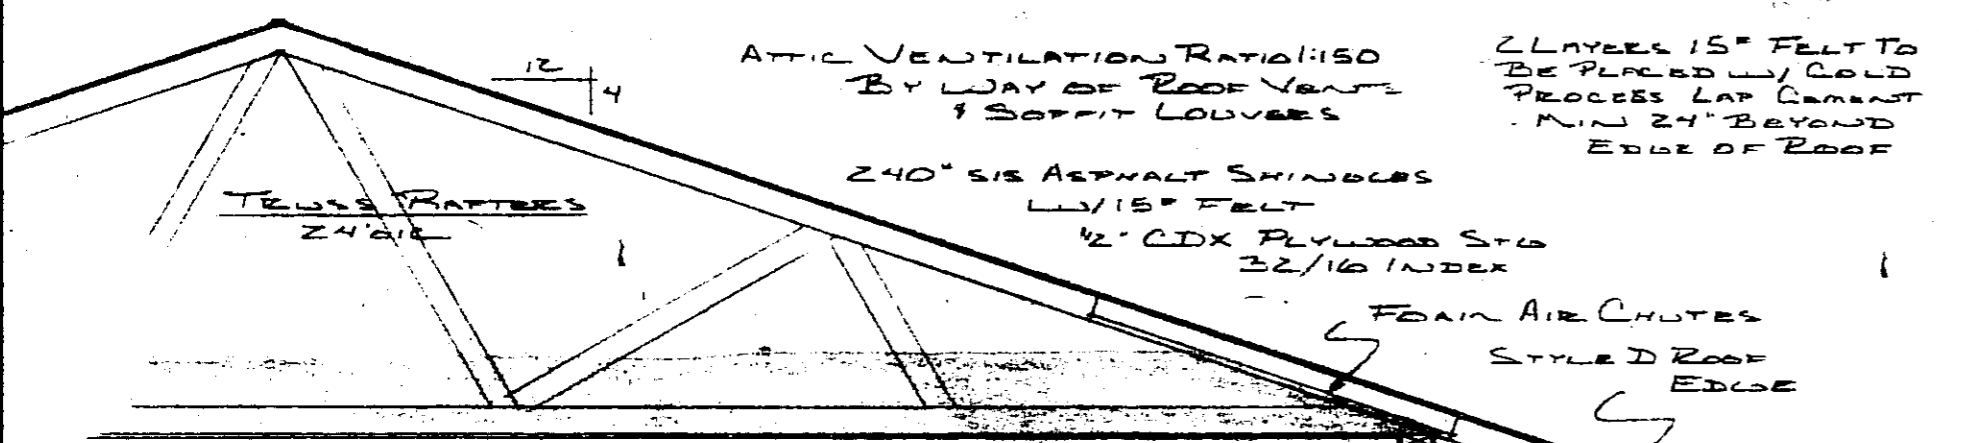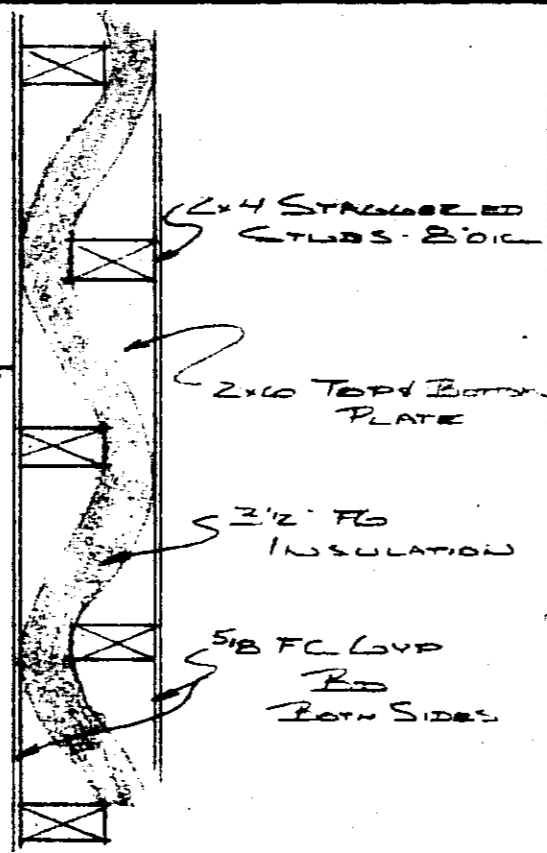


- 10" BLOWN CELLULOSE CEILING INSUL
- 3 1/2" FOAM INSULATION WALLS & BOX END
- VAPOR BARRIER ON ALL EXT WALLS & CG
- 5/8" GYP BD ALL CEILING
- 1/2" GYP BD WALLS
- 8" CEILING HGT-LIPDOWN
- DAK TRIM THROUGHOUT
- 2x4 STUDS 16" O.C
- 2x4 STUDS 24" O.C
- 2x4 SILLY PLATES
- 2x4 BRACE
- 2x2 EXT WALL
- HDS LINDS NOTED OTHERWISE
- 2x1 BRDF
- DOUBLE 2x4 CORNER ON OPENINGS OVER 6"
- 1 1/2" INTERMEDIATE STD
- TEX INSULITE SIDING
- VERTICAL-FRONT
- HORIZONTAL-SIDES
- REAR

- STAIR DETAILS**
- 9" MIN TREAD
 - 8" MAX RISE
 - 3x2x10 STRINGERS
 - 30-34" HIGH
 - HANDRAIL
 - 6x6 MIN HEADROOM

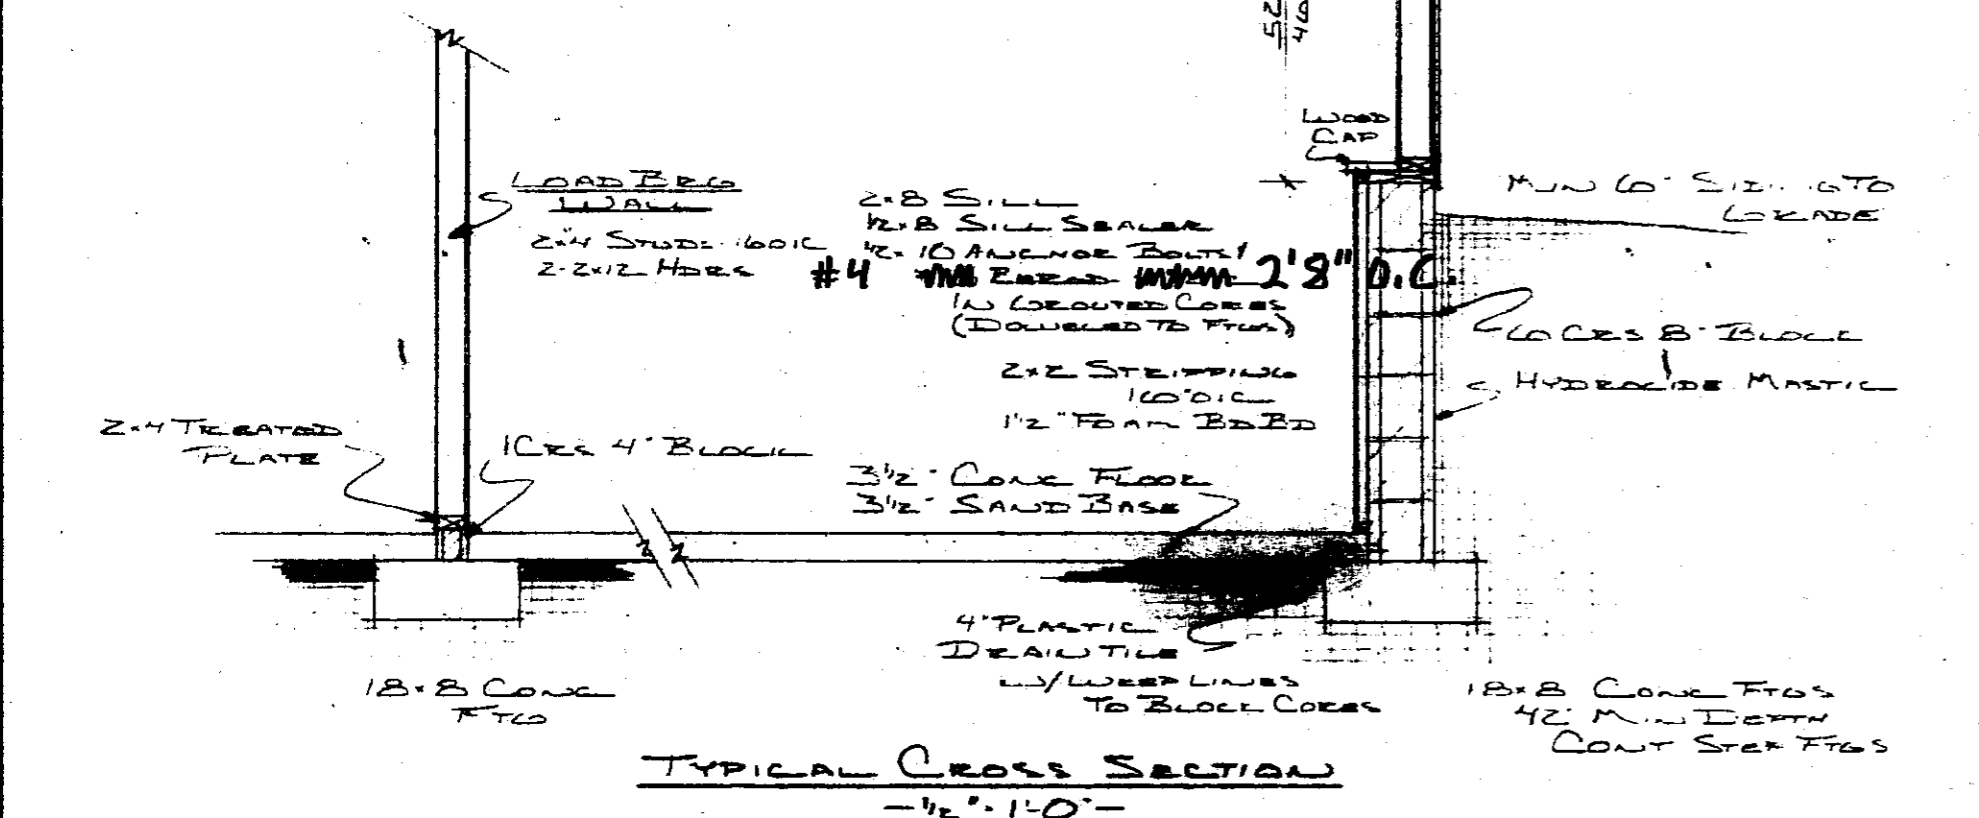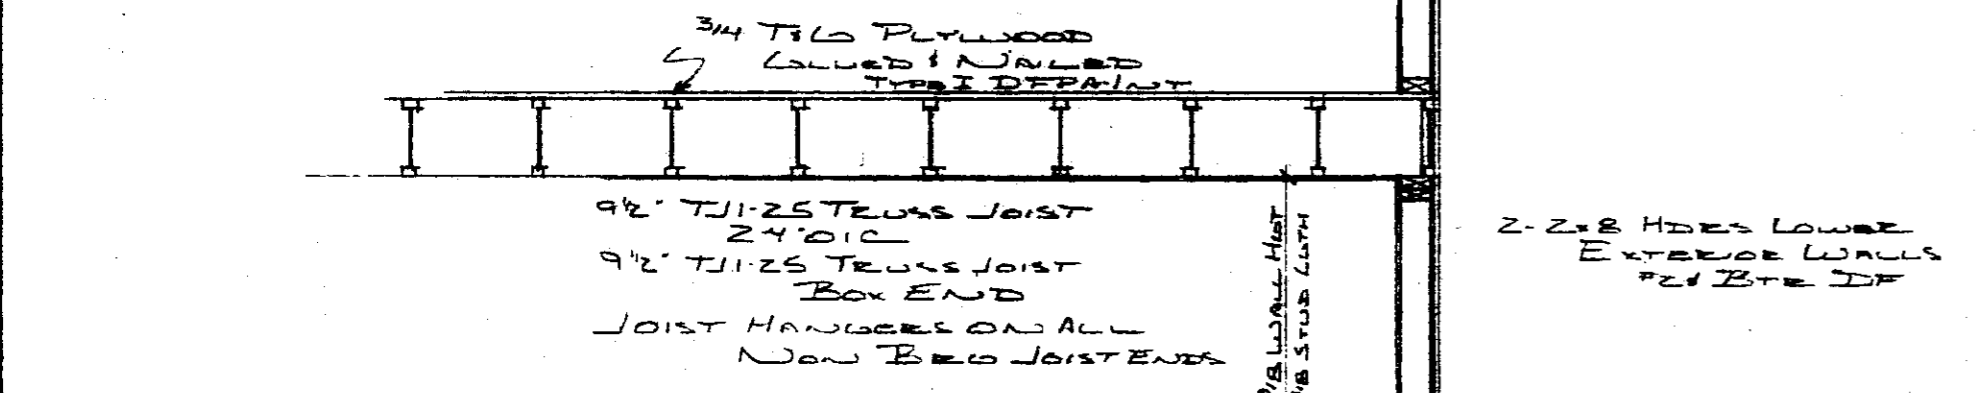


TYPICAL CROSS SECTION
- 1 1/2" x 10" -

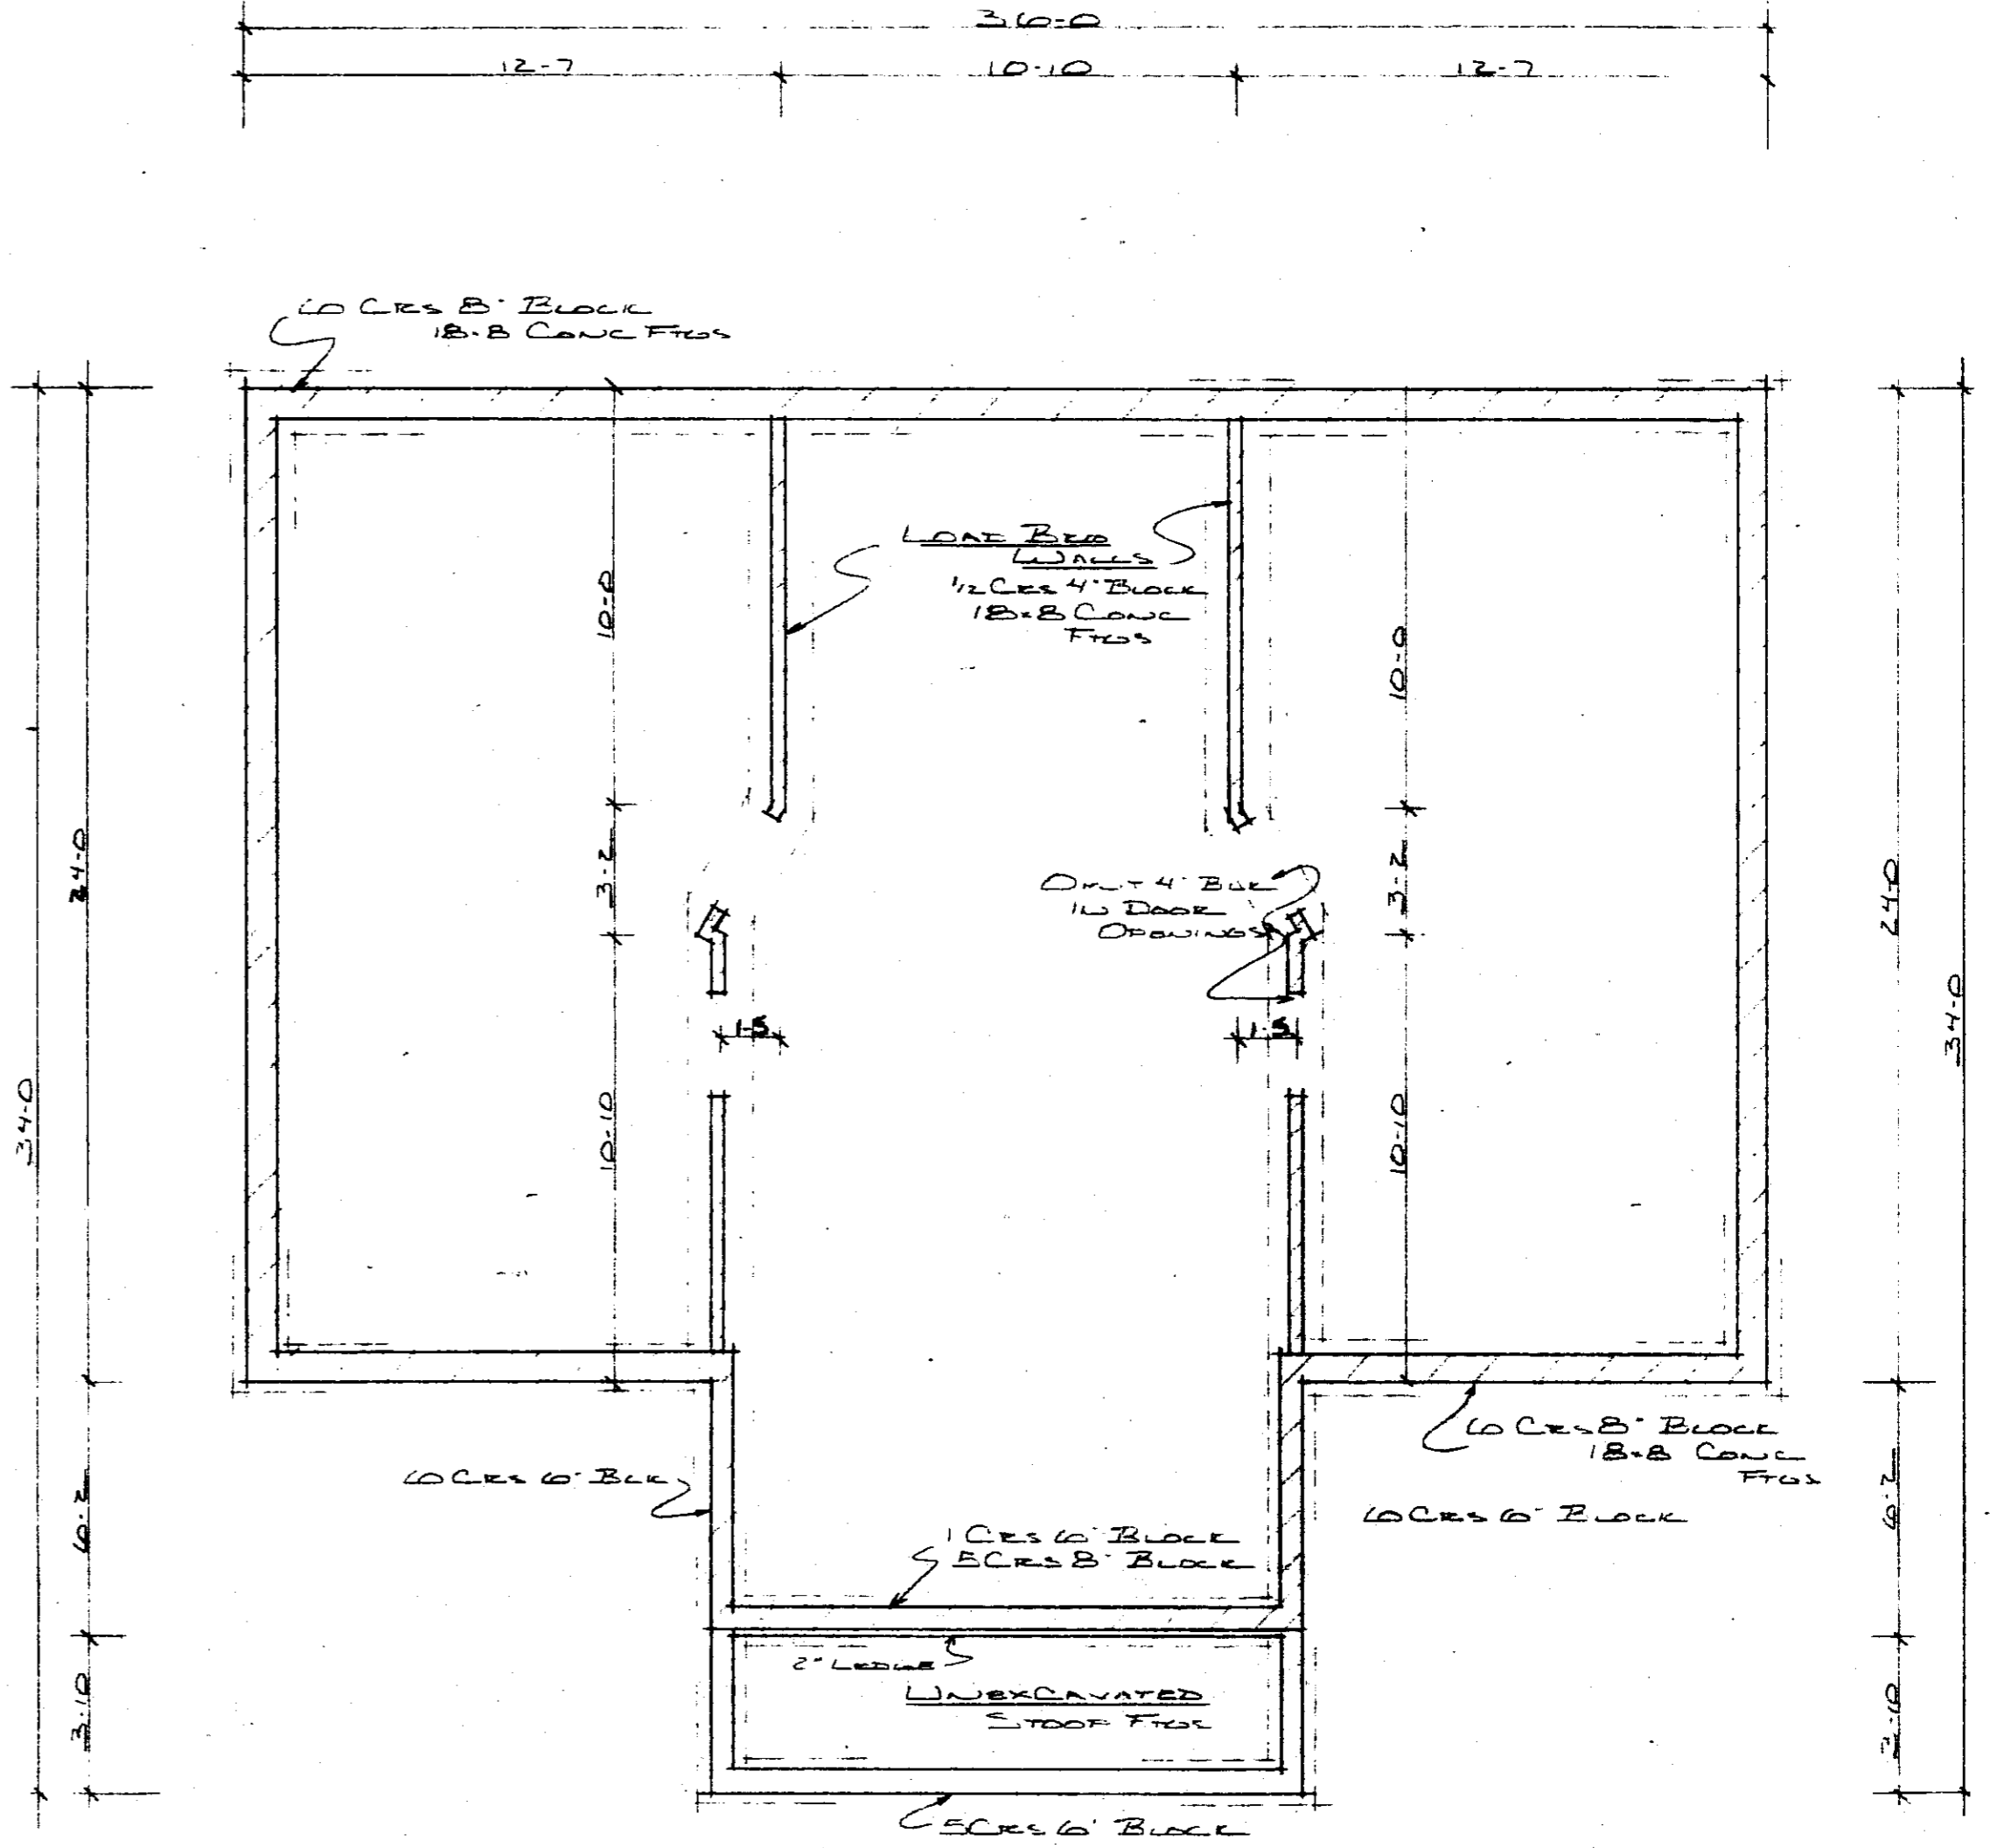


FOUNDATION PLAN
- 36' x 0' -


FULLERTON'S		
SCALE: AS NOTED	APPROVED BY	DRAWN BY
DATE: 11-27-78		JJ WERE
Bill Berg		
DRAWING NUMBER		2
33 2020		

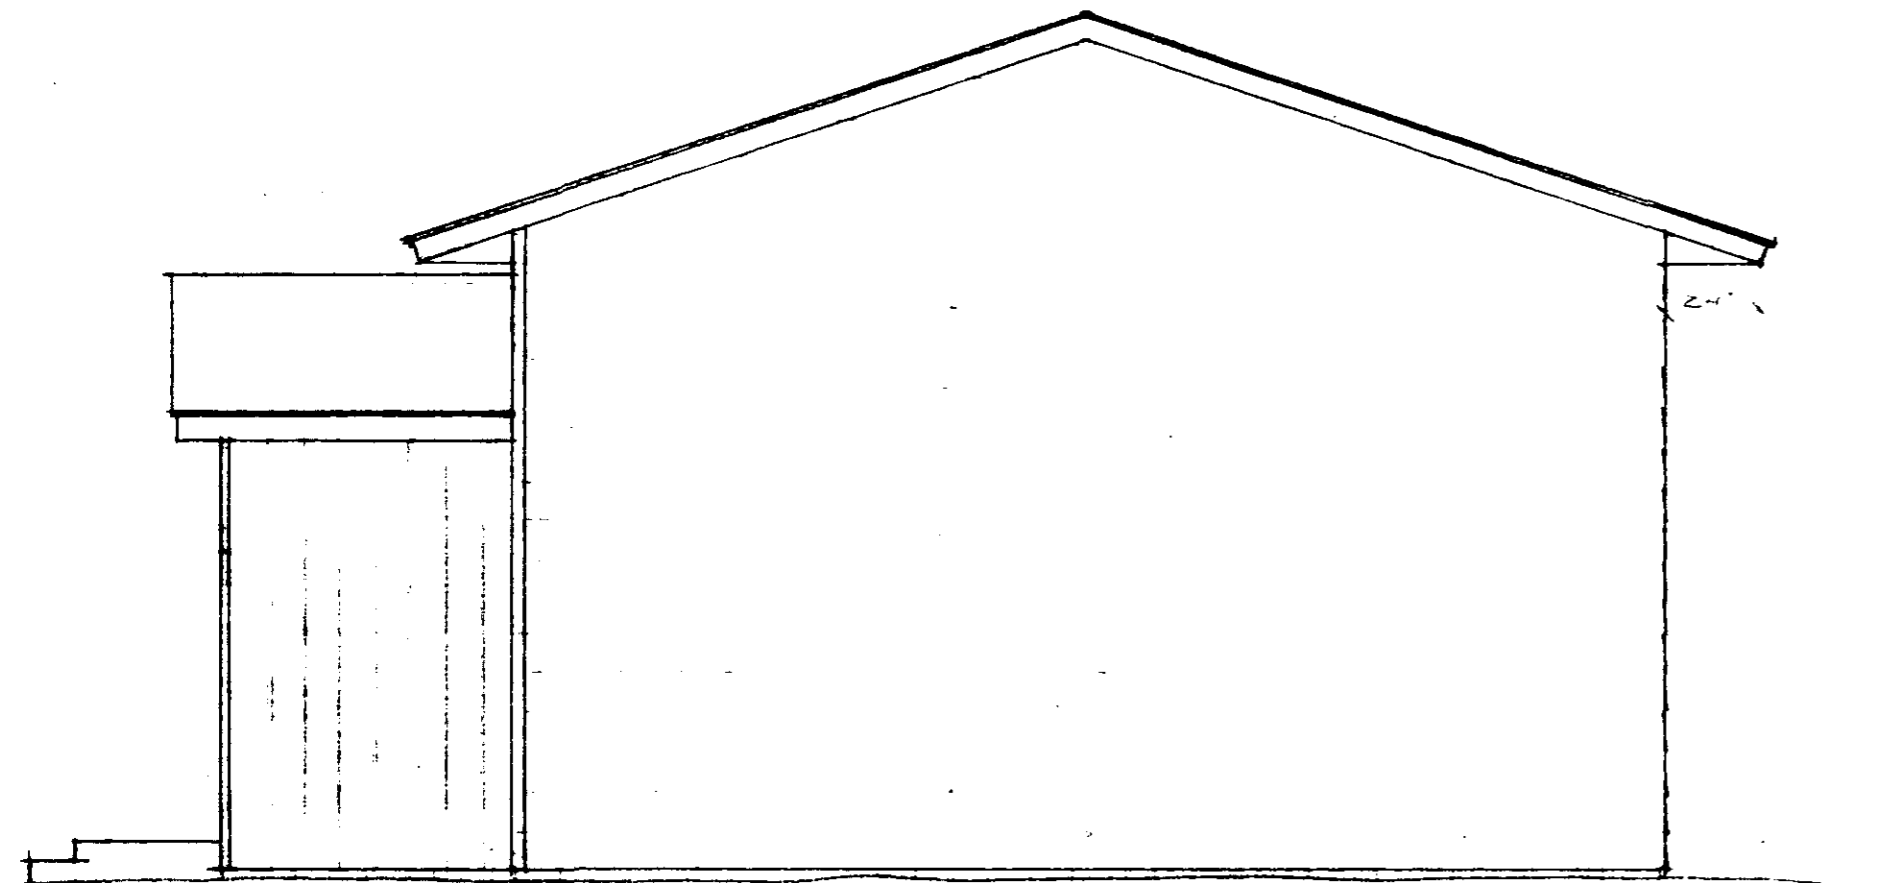

RIGHT ELEVATION
W: 11'-0"

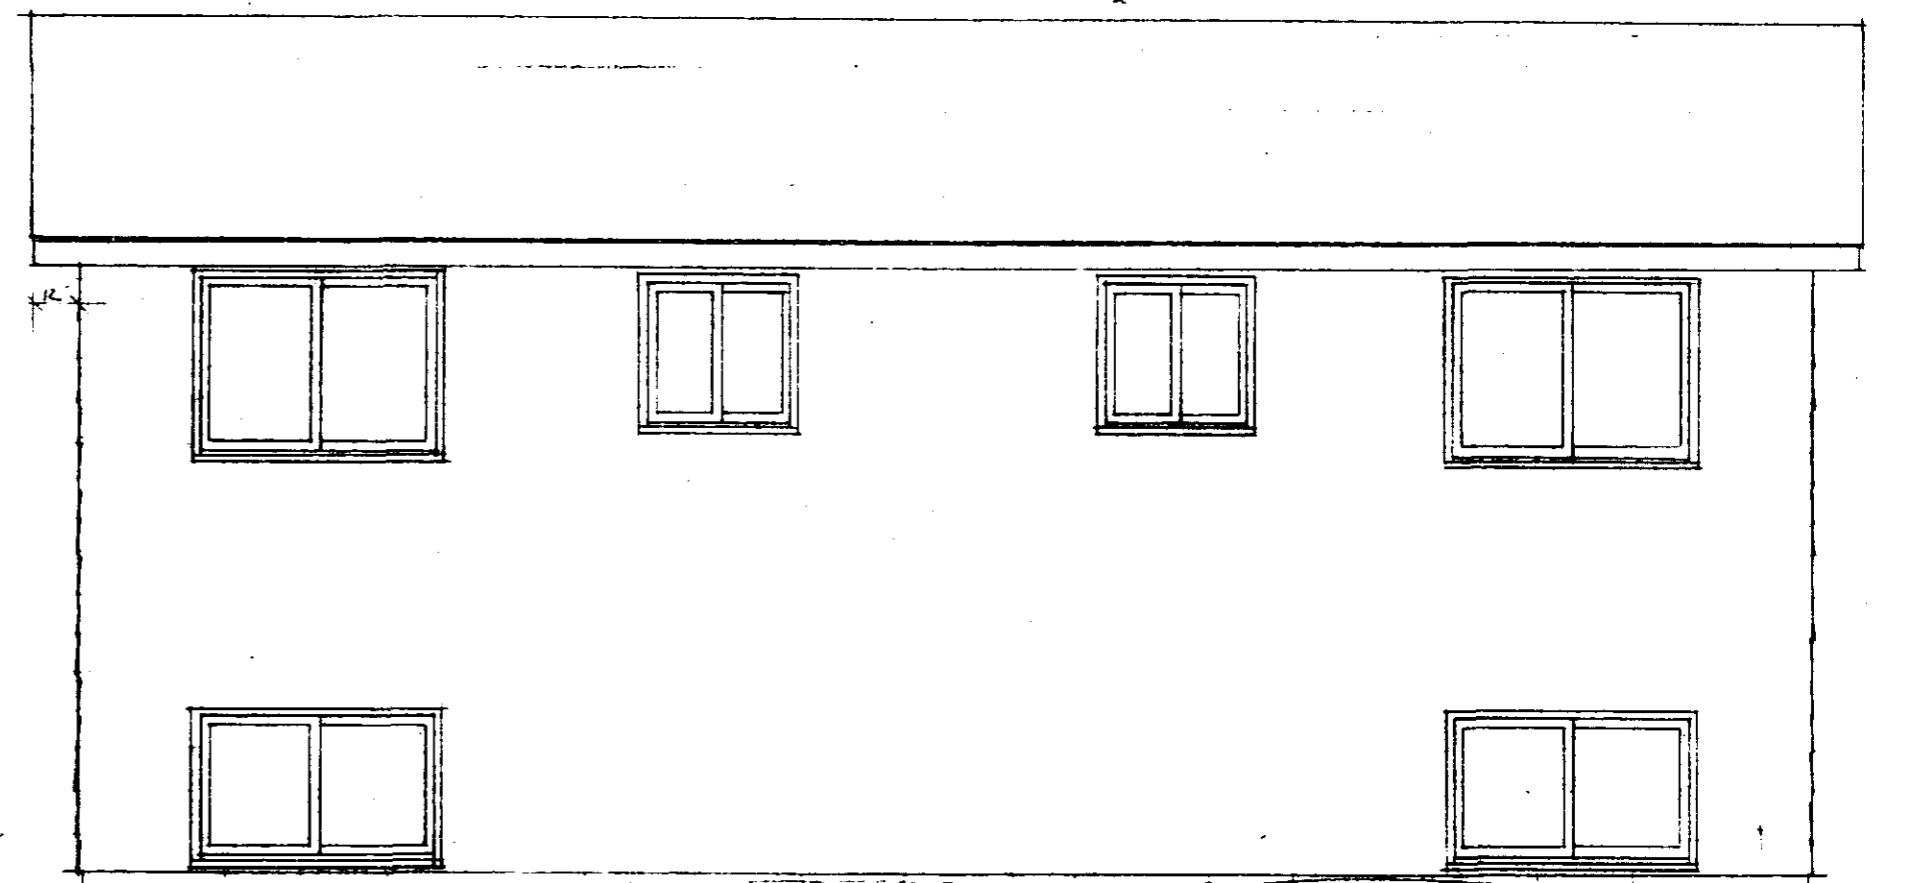


REAR ELEVATION
W: 11'-0"

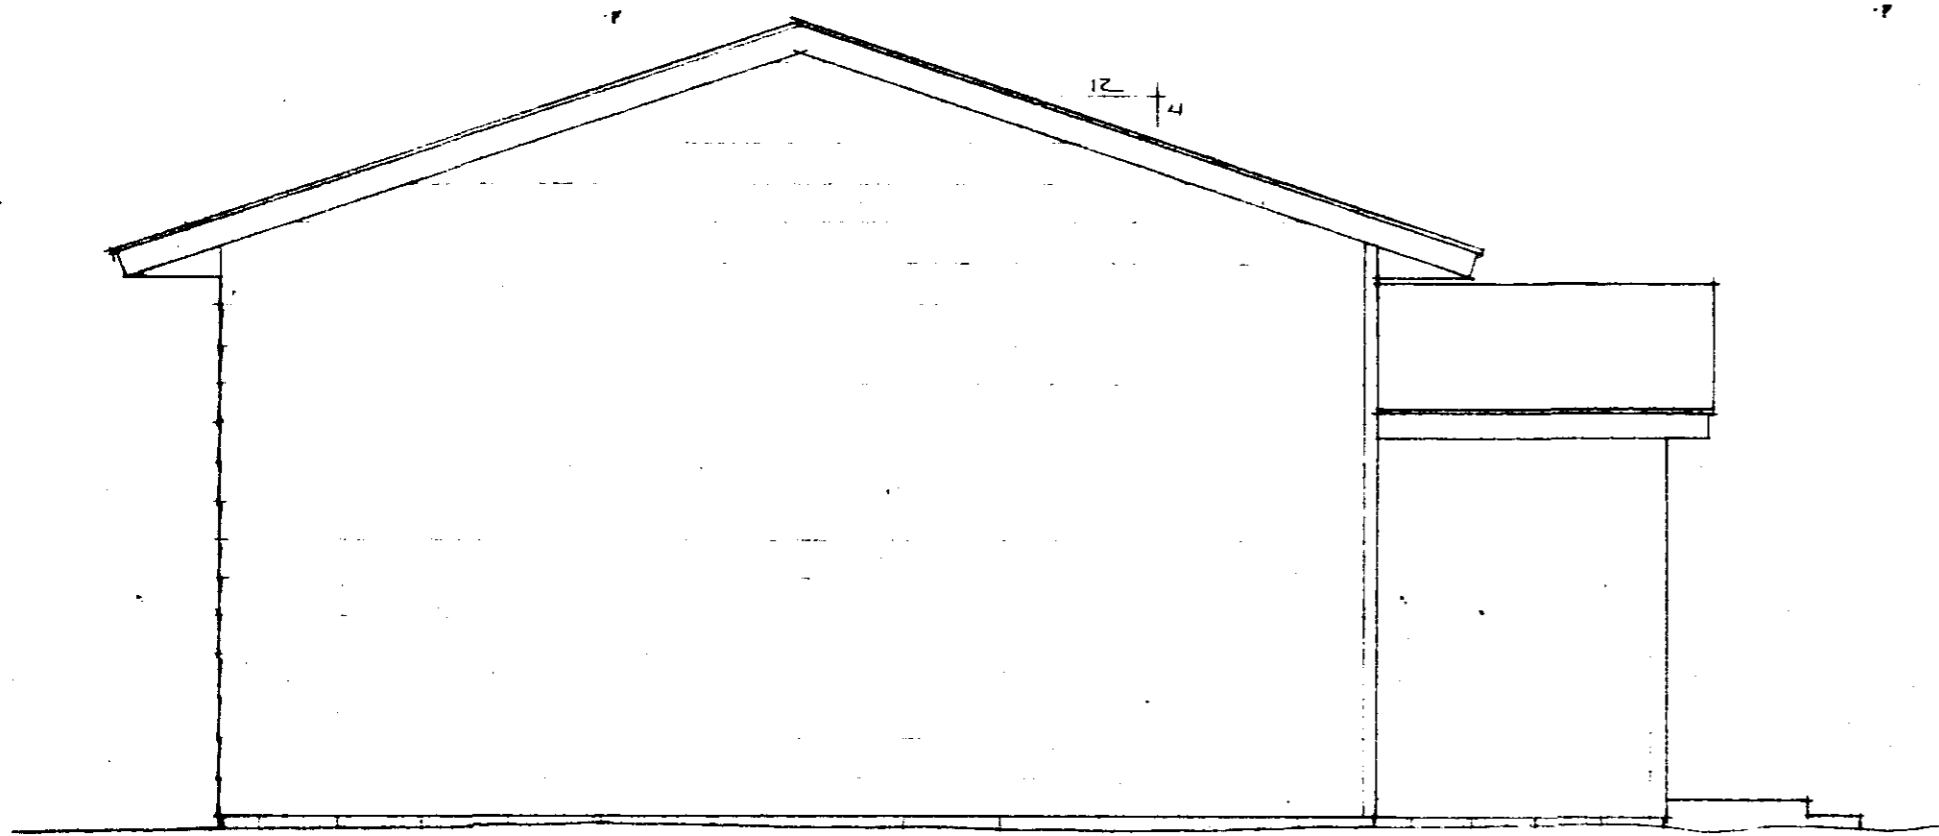

LEFT ELEVATION
W: 11'-0"

THE FRONT ENTRANCE WILL VARY.

MIN. FRONT PORCH 4'-0"

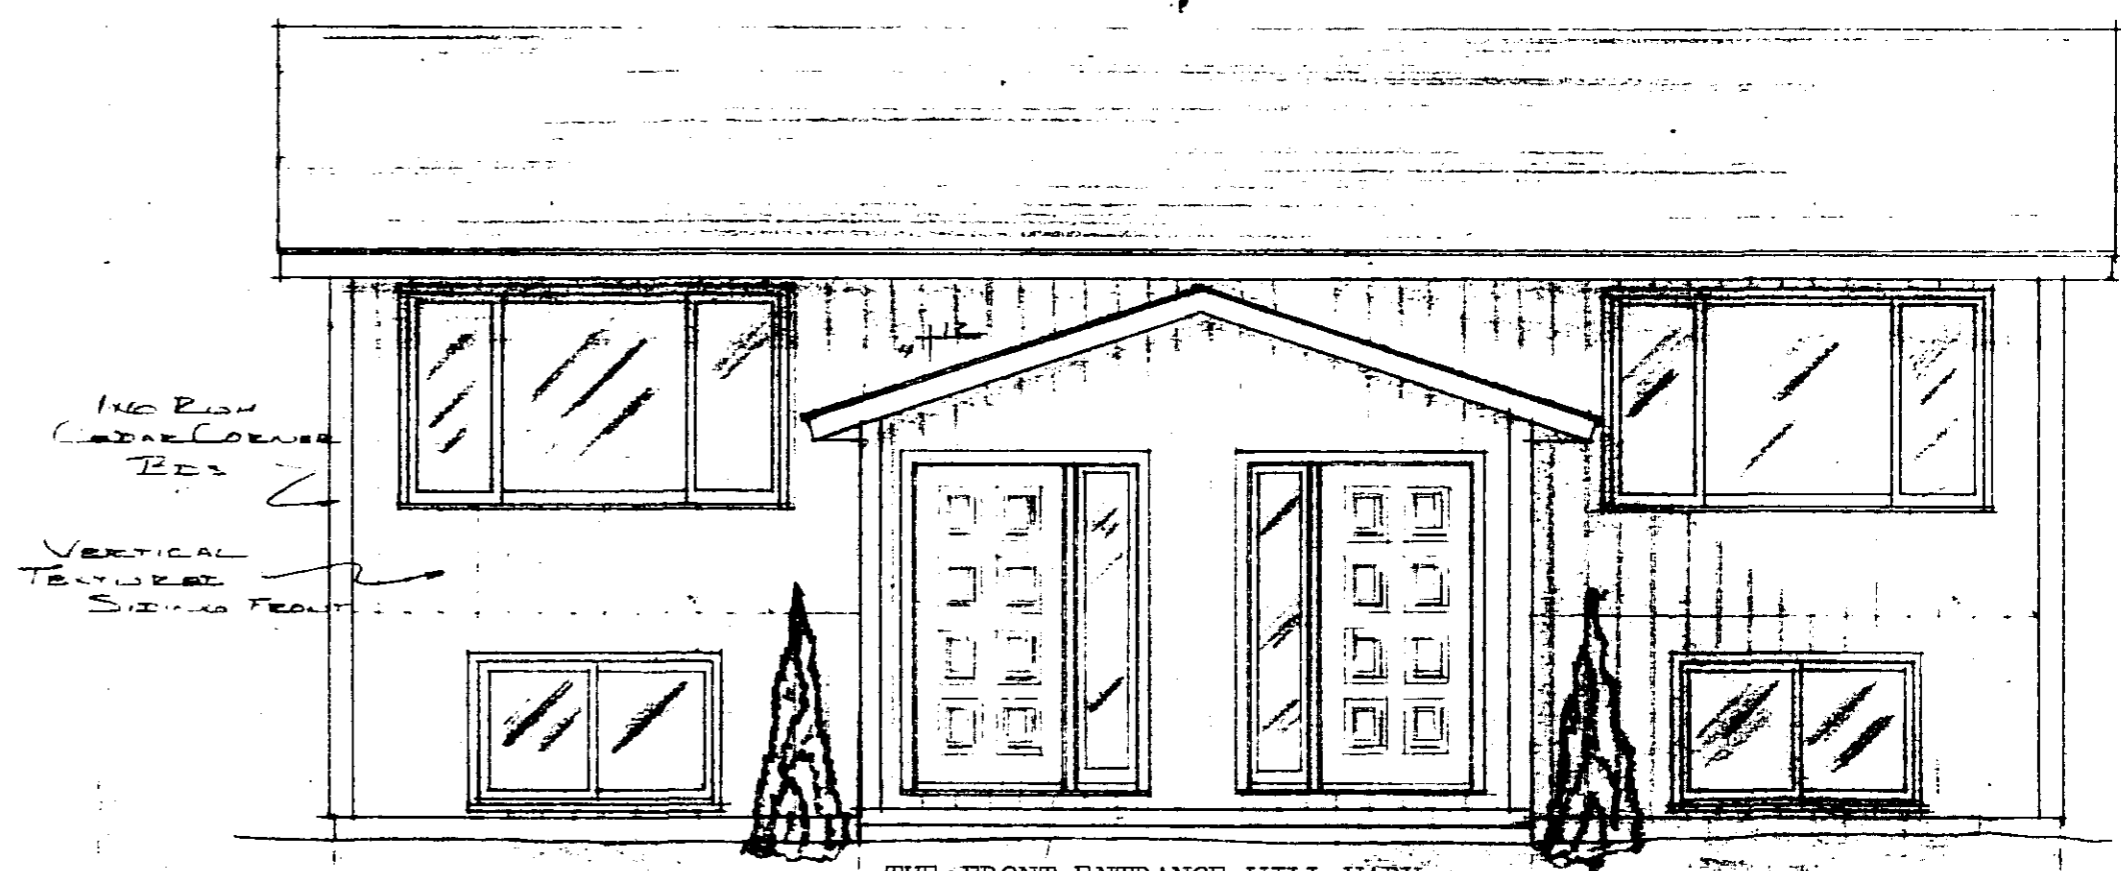

THE FRONT ENTRANCE WILL VARY.

FRONT ELEVATION
W: 11'-0"

FULLERTON'S

SCALE: AS NOTED	APPROVED BY:	DRAWN BY:
DATE: 10-26-18		J. BERG
BILL BERG		DRAWING NUMBER
		3