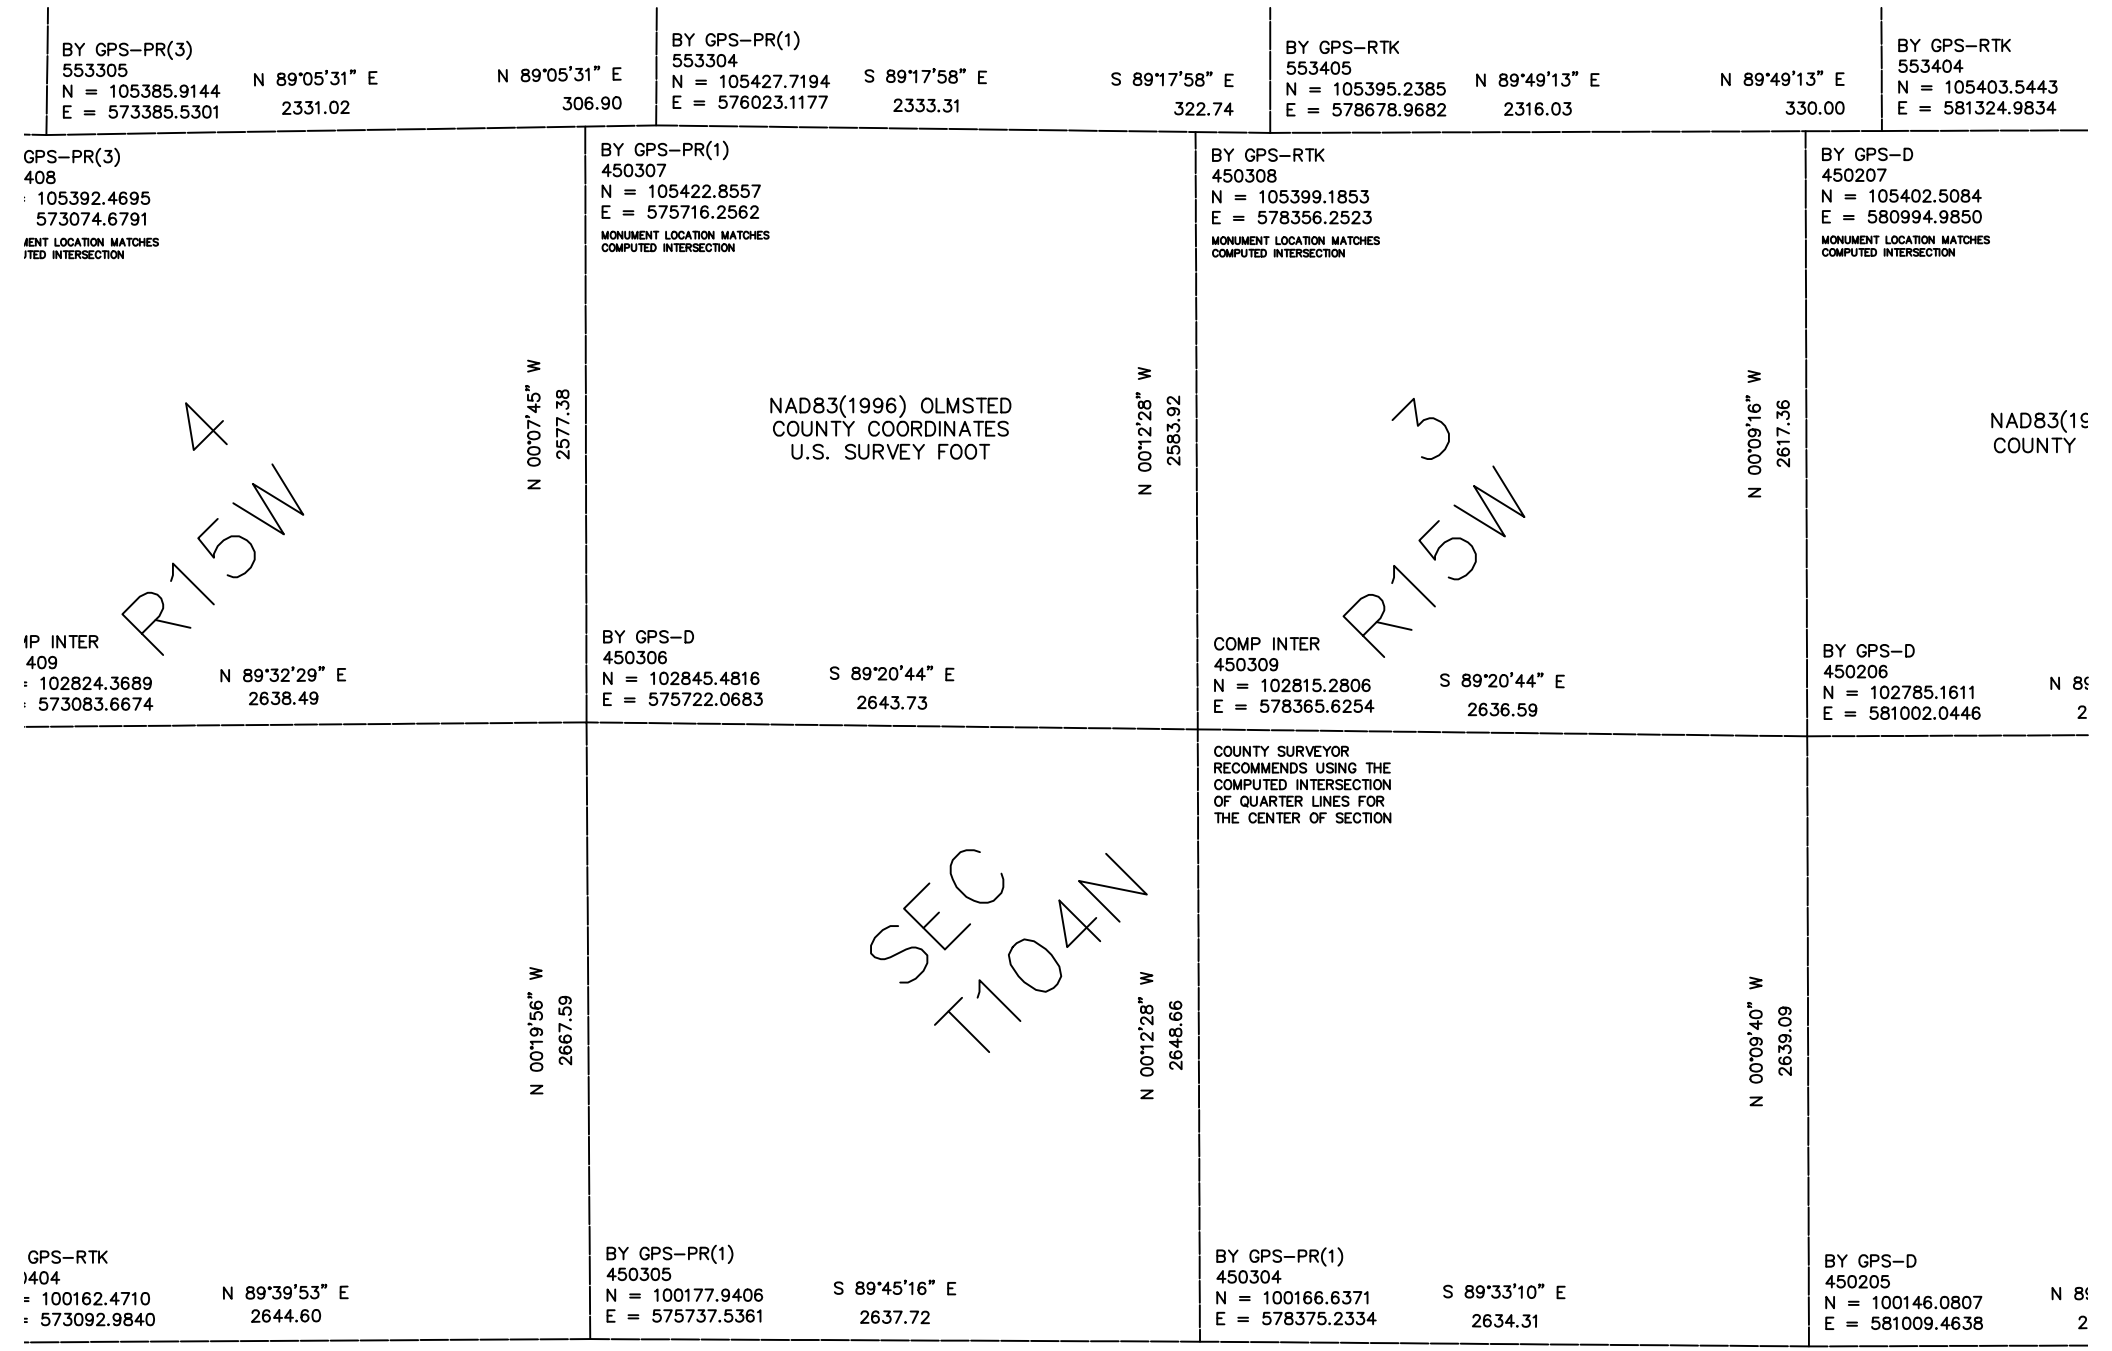

BY GPS–PR(3)
553305
N = 105385.9144
E = 573385.5301
N 89°05'31" E
2331.02
N 89°05'31" E
306.90
BY GPS–PR(1)
553304
N = 105427.7194
E = 576023.1177
S 89°17'58" E
2333.31
S 89°17'58" E
322.74
BY GPS–RTK
553405
N = 105395.2385
E = 578678.9682
N 89°49'13" E
2316.03
N 89°49'13" E
330.00
BY GPS–RTK
553404
N = 105403.5443
E = 581324.9834
GPS–PR(3)
408
105392.4695
573074.6791
MENT LOCATION MATCHES
ITED INTERSECTION
BY GPS–PR(1)
450307
N = 105422.8557
E = 575716.2562
MONUMENT LOCATION MATCHES
COMPUTED INTERSECTION
BY GPS–RTK
450308
N = 105399.1853
E = 578356.2523
MONUMENT LOCATION MATCHES
COMPUTED INTERSECTION
BY GPS–D
450207
N = 105402.5084
E = 580994.9850
MONUMENT LOCATION MATCHES
COMPUTED INTERSECTION
4
R15W
N 00°07'45" W
2577.38
NAD83(1996) OLMSTED
COUNTY COORDINATES
U.S. SURVEY FOOT
N 00°12'28" W
2583.92
3
R15W
N 00°09'16" W
2617.36
NAD83(19
COUNTY
MP INTER
409
102824.3689
573083.6674
N 89°32'29" E
2638.49
BY GPS–D
450306
N = 102845.4816
E = 575722.0683
S 89°20'44" E
2643.73
COMP INTER
450309
N = 102815.2806
E = 578365.6254
S 89°20'44" E
2636.59
BY GPS–D
450206
N = 102785.1611
E = 581002.0446
N 89
2
N 00°19'56" W
2667.59
SEC
T104N
N 00°12'28" W
2648.66
COUNTY SURVEYOR
RECOMMENDS USING THE
COMPUTED INTERSECTION
OF QUARTER LINES FOR
THE CENTER OF SECTION
N 00°09'40" W
2639.09
GPS–RTK
0404
100162.4710
573092.9840
N 89°39'53" E
2644.60
BY GPS–PR(1)
450305
N = 100177.9406
E = 575737.5361
S 89°45'16" E
2637.72
BY GPS–PR(1)
450304
N = 100166.6371
E = 578375.2334
S 89°33'10" E
2634.31
BY GPS–D
450205
N = 100146.0807
E = 581009.4638
N 89
2