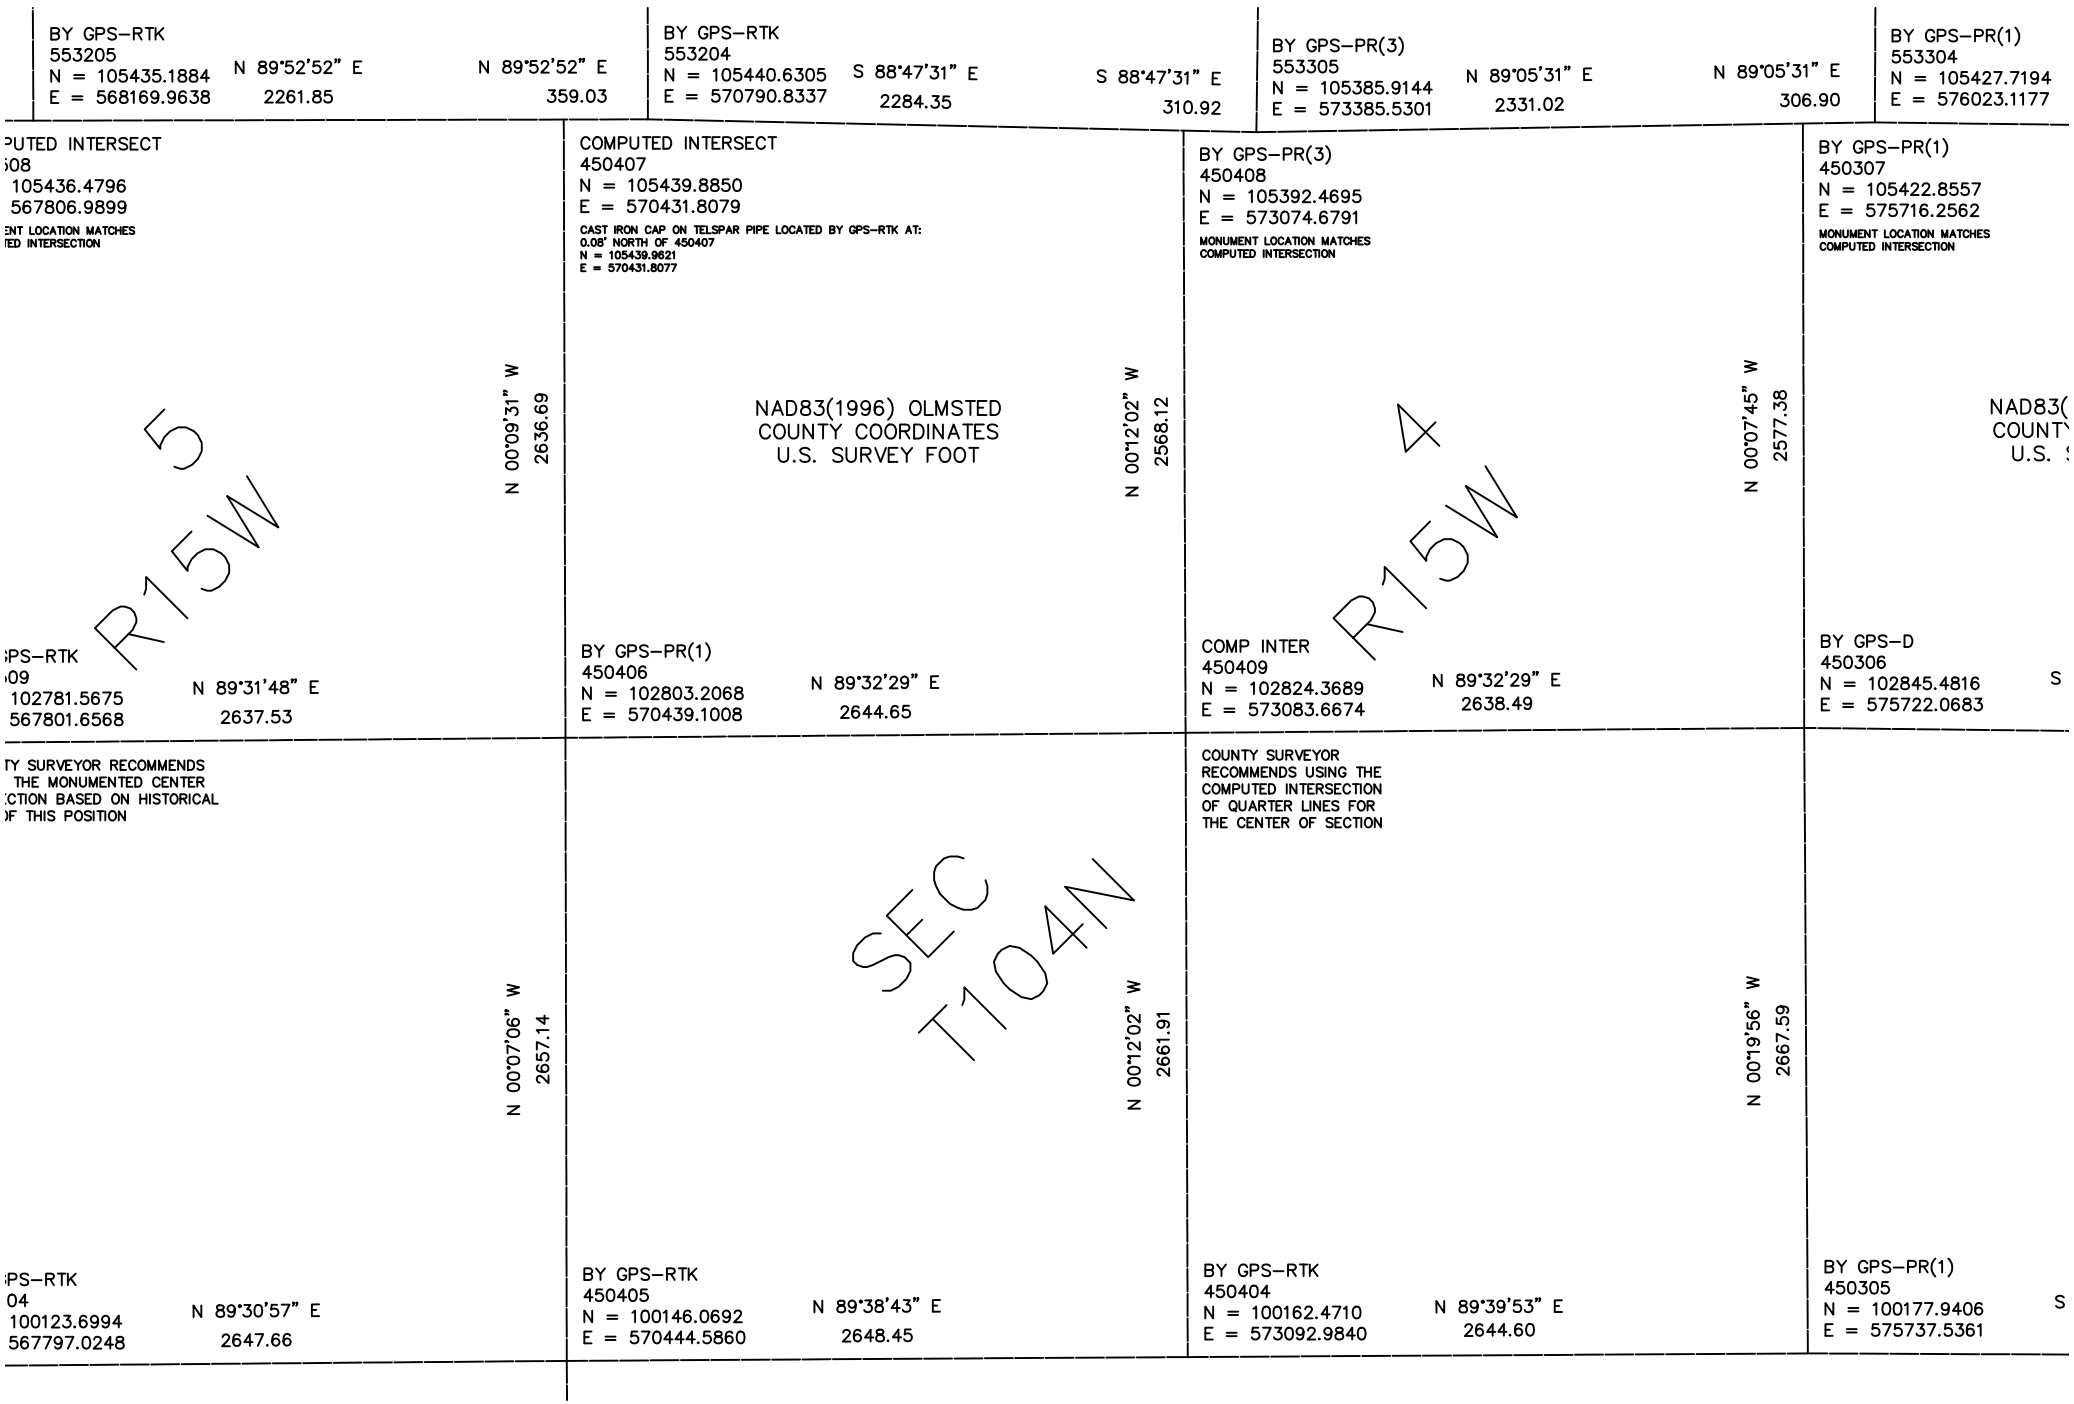

BY GPS–RTK
553205
N = 105435.1884
E = 568169.9638
N 89°52'52" E
2261.85
N 89°52'52" E
359.03
BY GPS–RTK
553204
N = 105440.6305
E = 570790.8337
S 88°47'31" E
2284.35
S 88°47'31" E
310.92
BY GPS–PR(3)
553305
N = 105385.9144
E = 573385.5301
N 89°05'31" E
2331.02
N 89°05'31" E
306.90
BY GPS–PR(1)
553304
N = 105427.7194
E = 576023.1177
PUTED INTERSECT
508
105436.4796
567806.9899
ENT LOCATION MATCHES
TED INTERSECTION
COMPUTED INTERSECT
450407
N = 105439.8850
E = 570431.8079
CAST IRON CAP ON TELSPAR PIPE LOCATED BY GPS–RTK AT:
0.08' NORTH OF 450407
N = 105439.9621
E = 570431.8077
BY GPS–PR(3)
450408
N = 105392.4695
E = 573074.6791
MONUMENT LOCATION MATCHES
COMPUTED INTERSECTION
BY GPS–PR(1)
450307
N = 105422.8557
E = 575716.2562
MONUMENT LOCATION MATCHES
COMPUTED INTERSECTION
N 00°09'31" W
2636.69
NAD83(1996) OLMSTED
COUNTY COORDINATES
U.S. SURVEY FOOT
N 00°12'02" W
2568.12
N 00°07'45" W
2577.38
NAD83(
COUNTY
U.S. S
R15W
5
R15W
4
PS–RTK
09
102781.5675
567801.6568
N 89°31'48" E
2637.53
BY GPS–PR(1)
450406
N = 102803.2068
E = 570439.1008
N 89°32'29" E
2644.65
COMP INTER
450409
N = 102824.3689
E = 573083.6674
N 89°32'29" E
2638.49
BY GPS–D
450306
N = 102845.4816
E = 575722.0683
S
TY SURVEYOR RECOMMENDS
THE MONUMENTED CENTER
CTION BASED ON HISTORICAL
OF THIS POSITION
COUNTY SURVEYOR
RECOMMENDS USING THE
COMPUTED INTERSECTION
OF QUARTER LINES FOR
THE CENTER OF SECTION
N 00°07'06" W
2657.14
SEC
T104N
N 00°12'02" W
2661.91
N 00°19'56" W
2667.59
PS–RTK
04
100123.6994
567797.0248
N 89°30'57" E
2647.66
BY GPS–RTK
450405
N = 100146.0692
E = 570444.5860
N 89°38'43" E
2648.45
BY GPS–RTK
450404
N = 100162.4710
E = 573092.9840
N 89°39'53" E
2644.60
BY GPS–PR(1)
450305
N = 100177.9406
E = 575737.5361
S