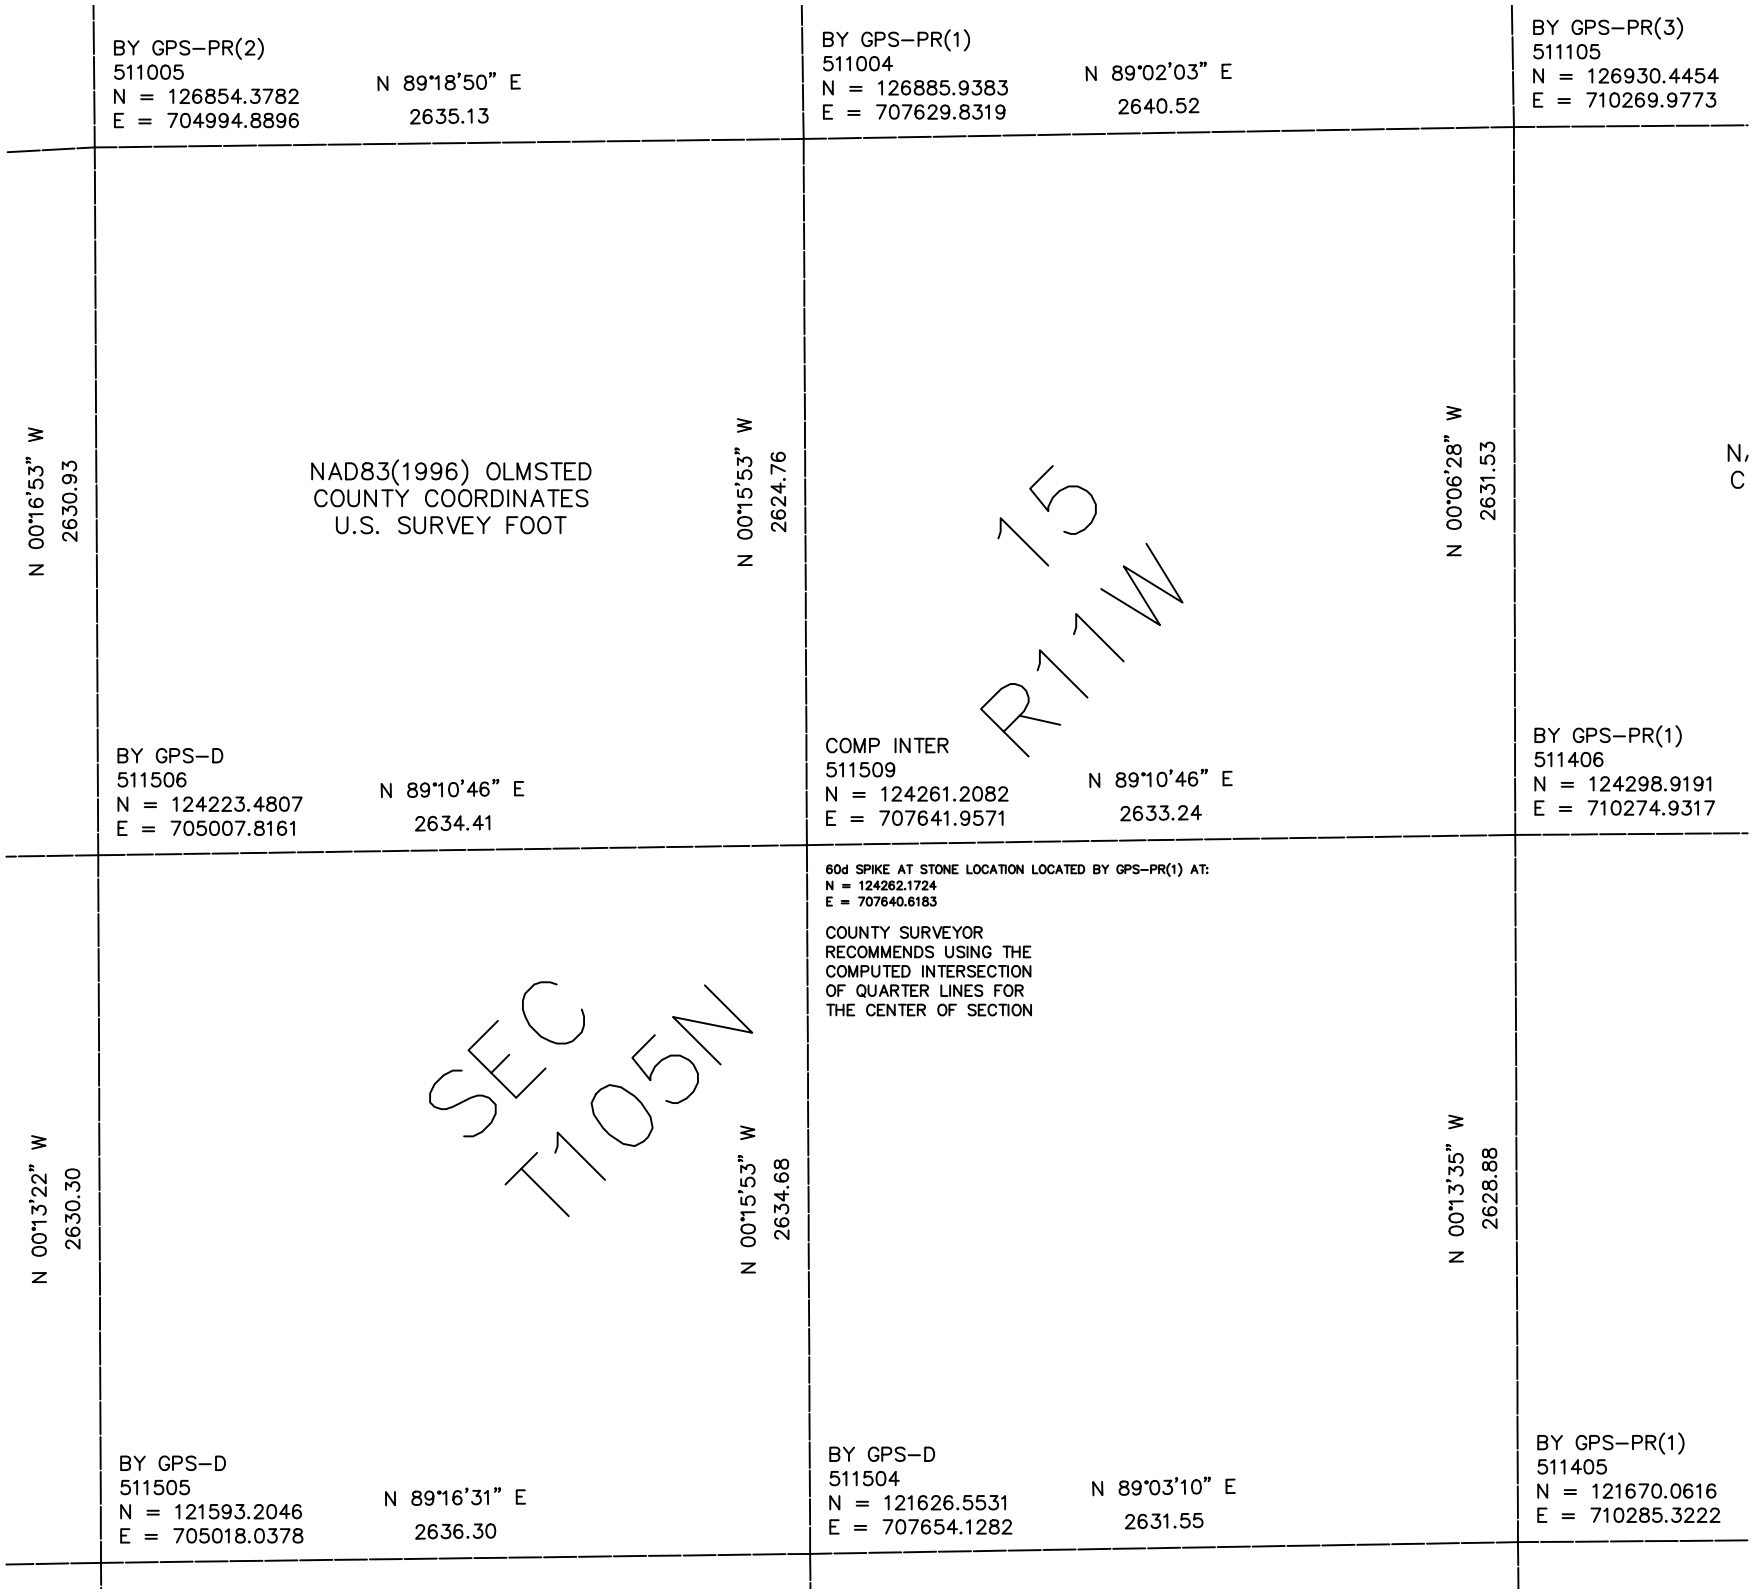

BY GPS–PR(2)
511005
N = 126854.3782
E = 704994.8896
N 89°18'50" E
2635.13
BY GPS–PR(1)
511004
N = 126885.9383
E = 707629.8319
N 89°02'03" E
2640.52
BY GPS–PR(3)
511105
N = 126930.4454
E = 710269.9773
N 00°16'53" W
2630.93
NAD83(1996) OLMSTED
COUNTY COORDINATES
U.S. SURVEY FOOT
N 00°15'53" W
2624.76
15
R11W
N 00°06'28" W
2631.53
N,
C
BY GPS–D
511506
N = 124223.4807
E = 705007.8161
N 89°10'46" E
2634.41
COMP INTER
511509
N = 124261.2082
E = 707641.9571
N 89°10'46" E
2633.24
BY GPS–PR(1)
511406
N = 124298.9191
E = 710274.9317
60d SPIKE AT STONE LOCATION LOCATED BY GPS–PR(1) AT:
N = 124262.1724
E = 707640.6183
COUNTY SURVEYOR
RECOMMENDS USING THE
COMPUTED INTERSECTION
OF QUARTER LINES FOR
THE CENTER OF SECTION
SEC
T105N
N 00°13'22" W
2630.30
N 00°15'53" W
2634.68
N 00°13'35" W
2628.88
BY GPS–D
511505
N = 121593.2046
E = 705018.0378
N 89°16'31" E
2636.30
BY GPS–D
511504
N = 121626.5531
E = 707654.1282
N 89°03'10" E
2631.55
BY GPS–PR(1)
511405
N = 121670.0616
E = 710285.3222