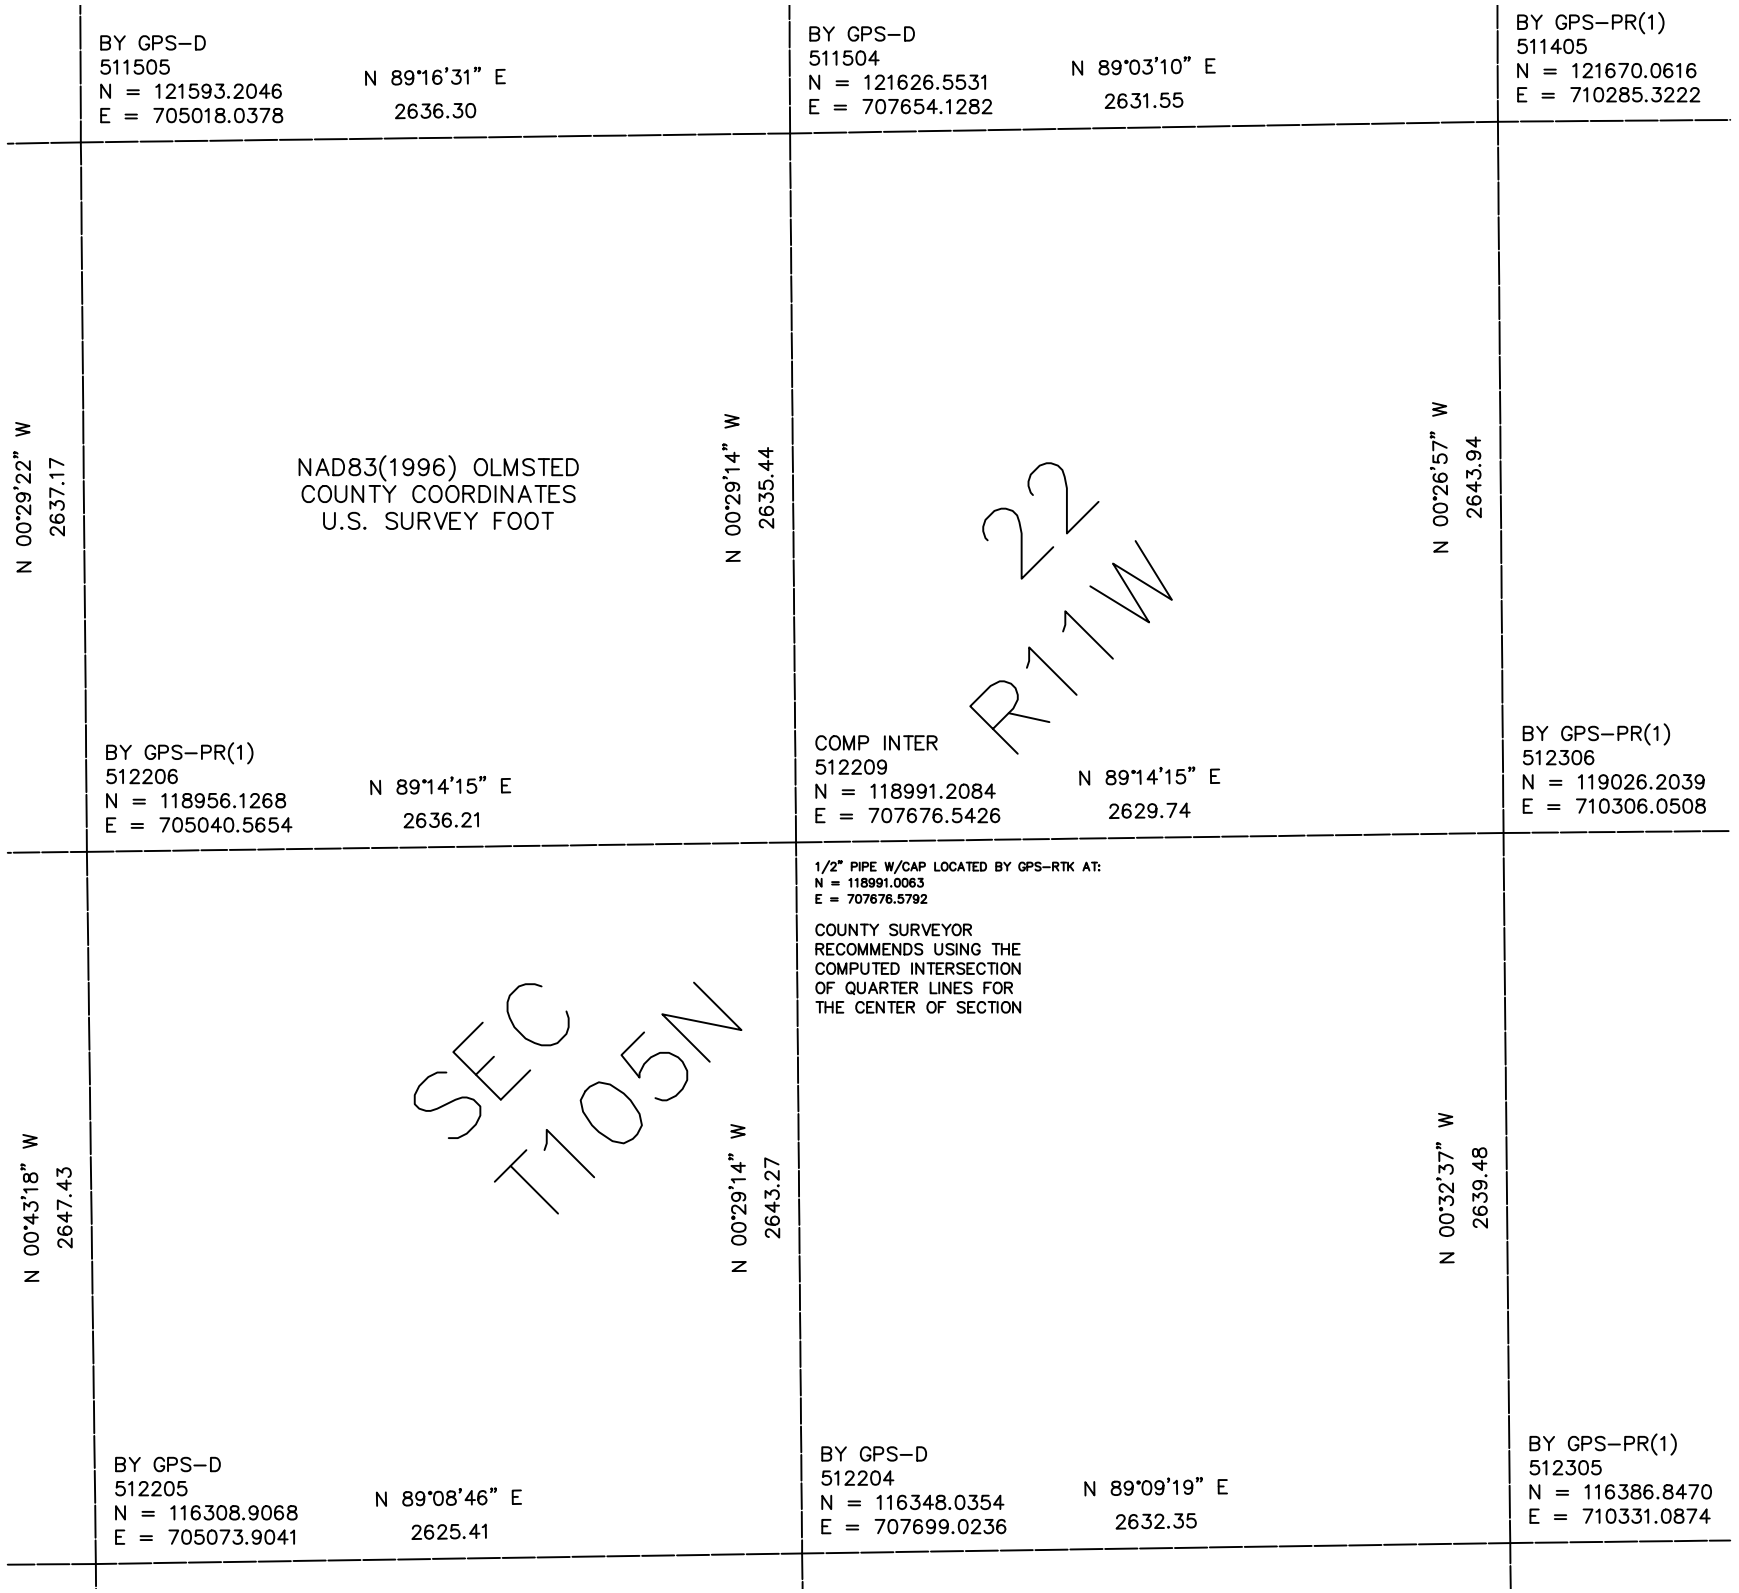

BY GPS–D
511505
N = 121593.2046
E = 705018.0378
N 89°16'31" E
2636.30
BY GPS–D
511504
N = 121626.5531
E = 707654.1282
N 89°03'10" E
2631.55
BY GPS–PR(1)
511405
N = 121670.0616
E = 710285.3222
N 00°29'22" W
2637.17
NAD83(1996) OLMSTED
COUNTY COORDINATES
U.S. SURVEY FOOT
N 00°29'14" W
2635.44
22
R11W
N 00°26'57" W
2643.94
BY GPS–PR(1)
512206
N = 118956.1268
E = 705040.5654
N 89°14'15" E
2636.21
COMP INTER
512209
N = 118991.2084
E = 707676.5426
N 89°14'15" E
2629.74
BY GPS–PR(1)
512306
N = 119026.2039
E = 710306.0508
1/2" PIPE W/CAP LOCATED BY GPS–RTK AT:
N = 118991.0063
E = 707676.5792
COUNTY SURVEYOR
RECOMMENDS USING THE
COMPUTED INTERSECTION
OF QUARTER LINES FOR
THE CENTER OF SECTION
N 00°43'18" W
2647.43
SEC
T105N
N 00°29'14" W
2643.27
N 00°32'37" W
2639.48
BY GPS–D
512205
N = 116308.9068
E = 705073.9041
N 89°08'46" E
2625.41
BY GPS–D
512204
N = 116348.0354
E = 707699.0236
N 89°09'19" E
2632.35
BY GPS–PR(1)
512305
N = 116386.8470
E = 710331.0874