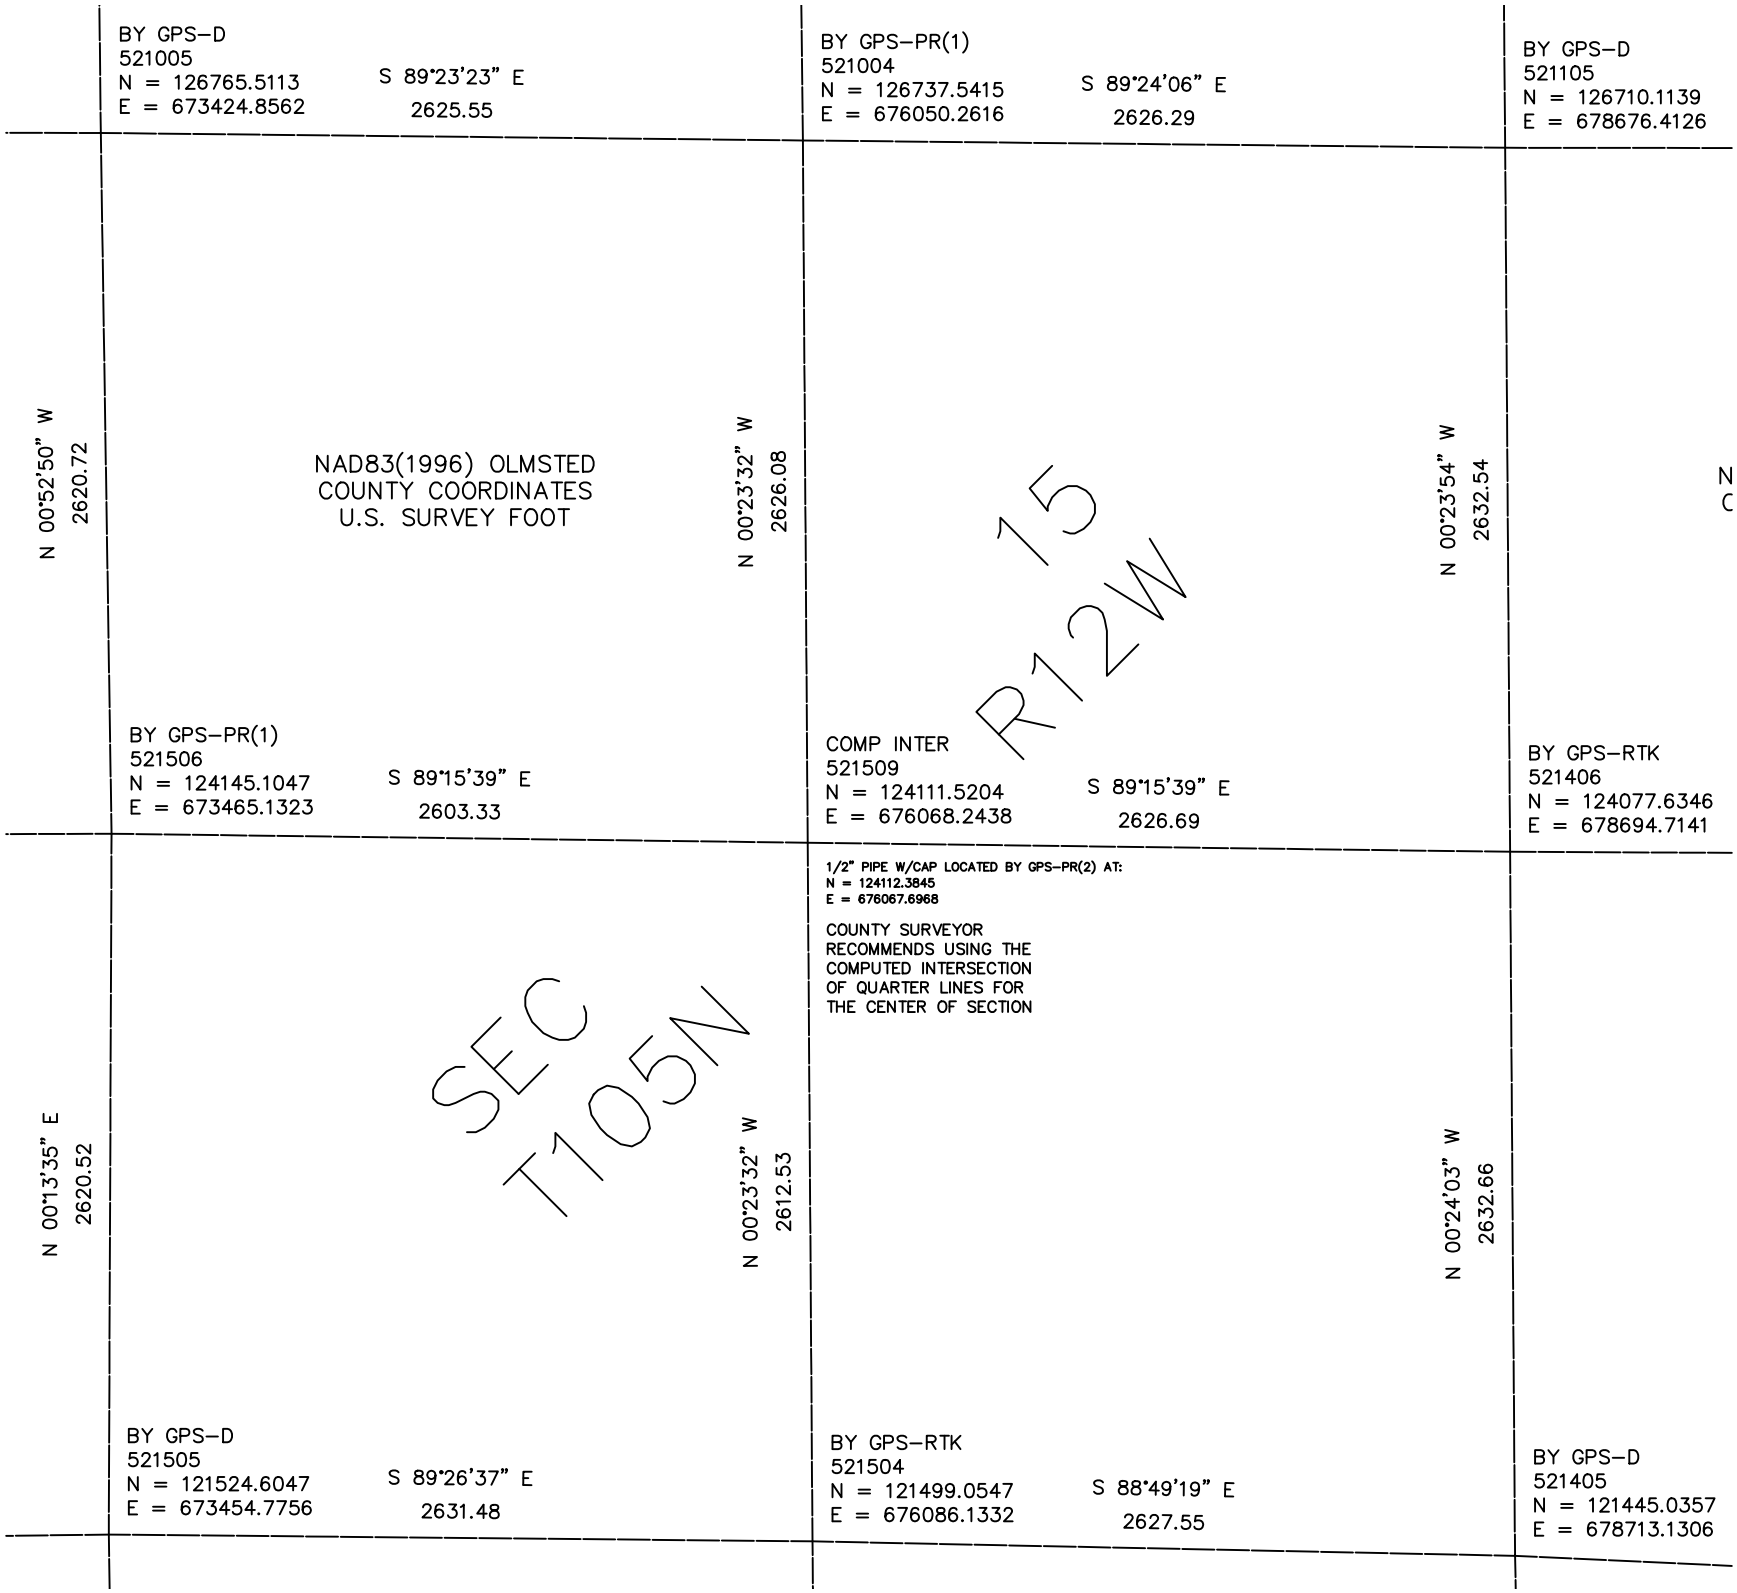

BY GPS–D
521005
N = 126765.5113
E = 673424.8562
S 89°23'23" E
2625.55
BY GPS–PR(1)
521004
N = 126737.5415
E = 676050.2616
S 89°24'06" E
2626.29
BY GPS–D
521105
N = 126710.1139
E = 678676.4126
N 00°52'50" W
2620.72
NAD83(1996) OLMSTED
COUNTY COORDINATES
U.S. SURVEY FOOT
N 00°23'32" W
2626.08
15
R12W
N 00°23'54" W
2632.54
N
C
BY GPS–PR(1)
521506
N = 124145.1047
E = 673465.1323
S 89°15'39" E
2603.33
COMP INTER
521509
N = 124111.5204
E = 676068.2438
S 89°15'39" E
2626.69
BY GPS–RTK
521406
N = 124077.6346
E = 678694.7141
1/2" PIPE W/CAP LOCATED BY GPS–PR(2) AT:
N = 124112.3845
E = 676067.6968
COUNTY SURVEYOR
RECOMMENDS USING THE
COMPUTED INTERSECTION
OF QUARTER LINES FOR
THE CENTER OF SECTION
N 00°13'35" E
2620.52
SEC
T105N
N 00°23'32" W
2612.53
N 00°24'03" W
2632.66
BY GPS–D
521505
N = 121524.6047
E = 673454.7756
S 89°26'37" E
2631.48
BY GPS–RTK
521504
N = 121499.0547
E = 676086.1332
S 88°49'19" E
2627.55
BY GPS–D
521405
N = 121445.0357
E = 678713.1306