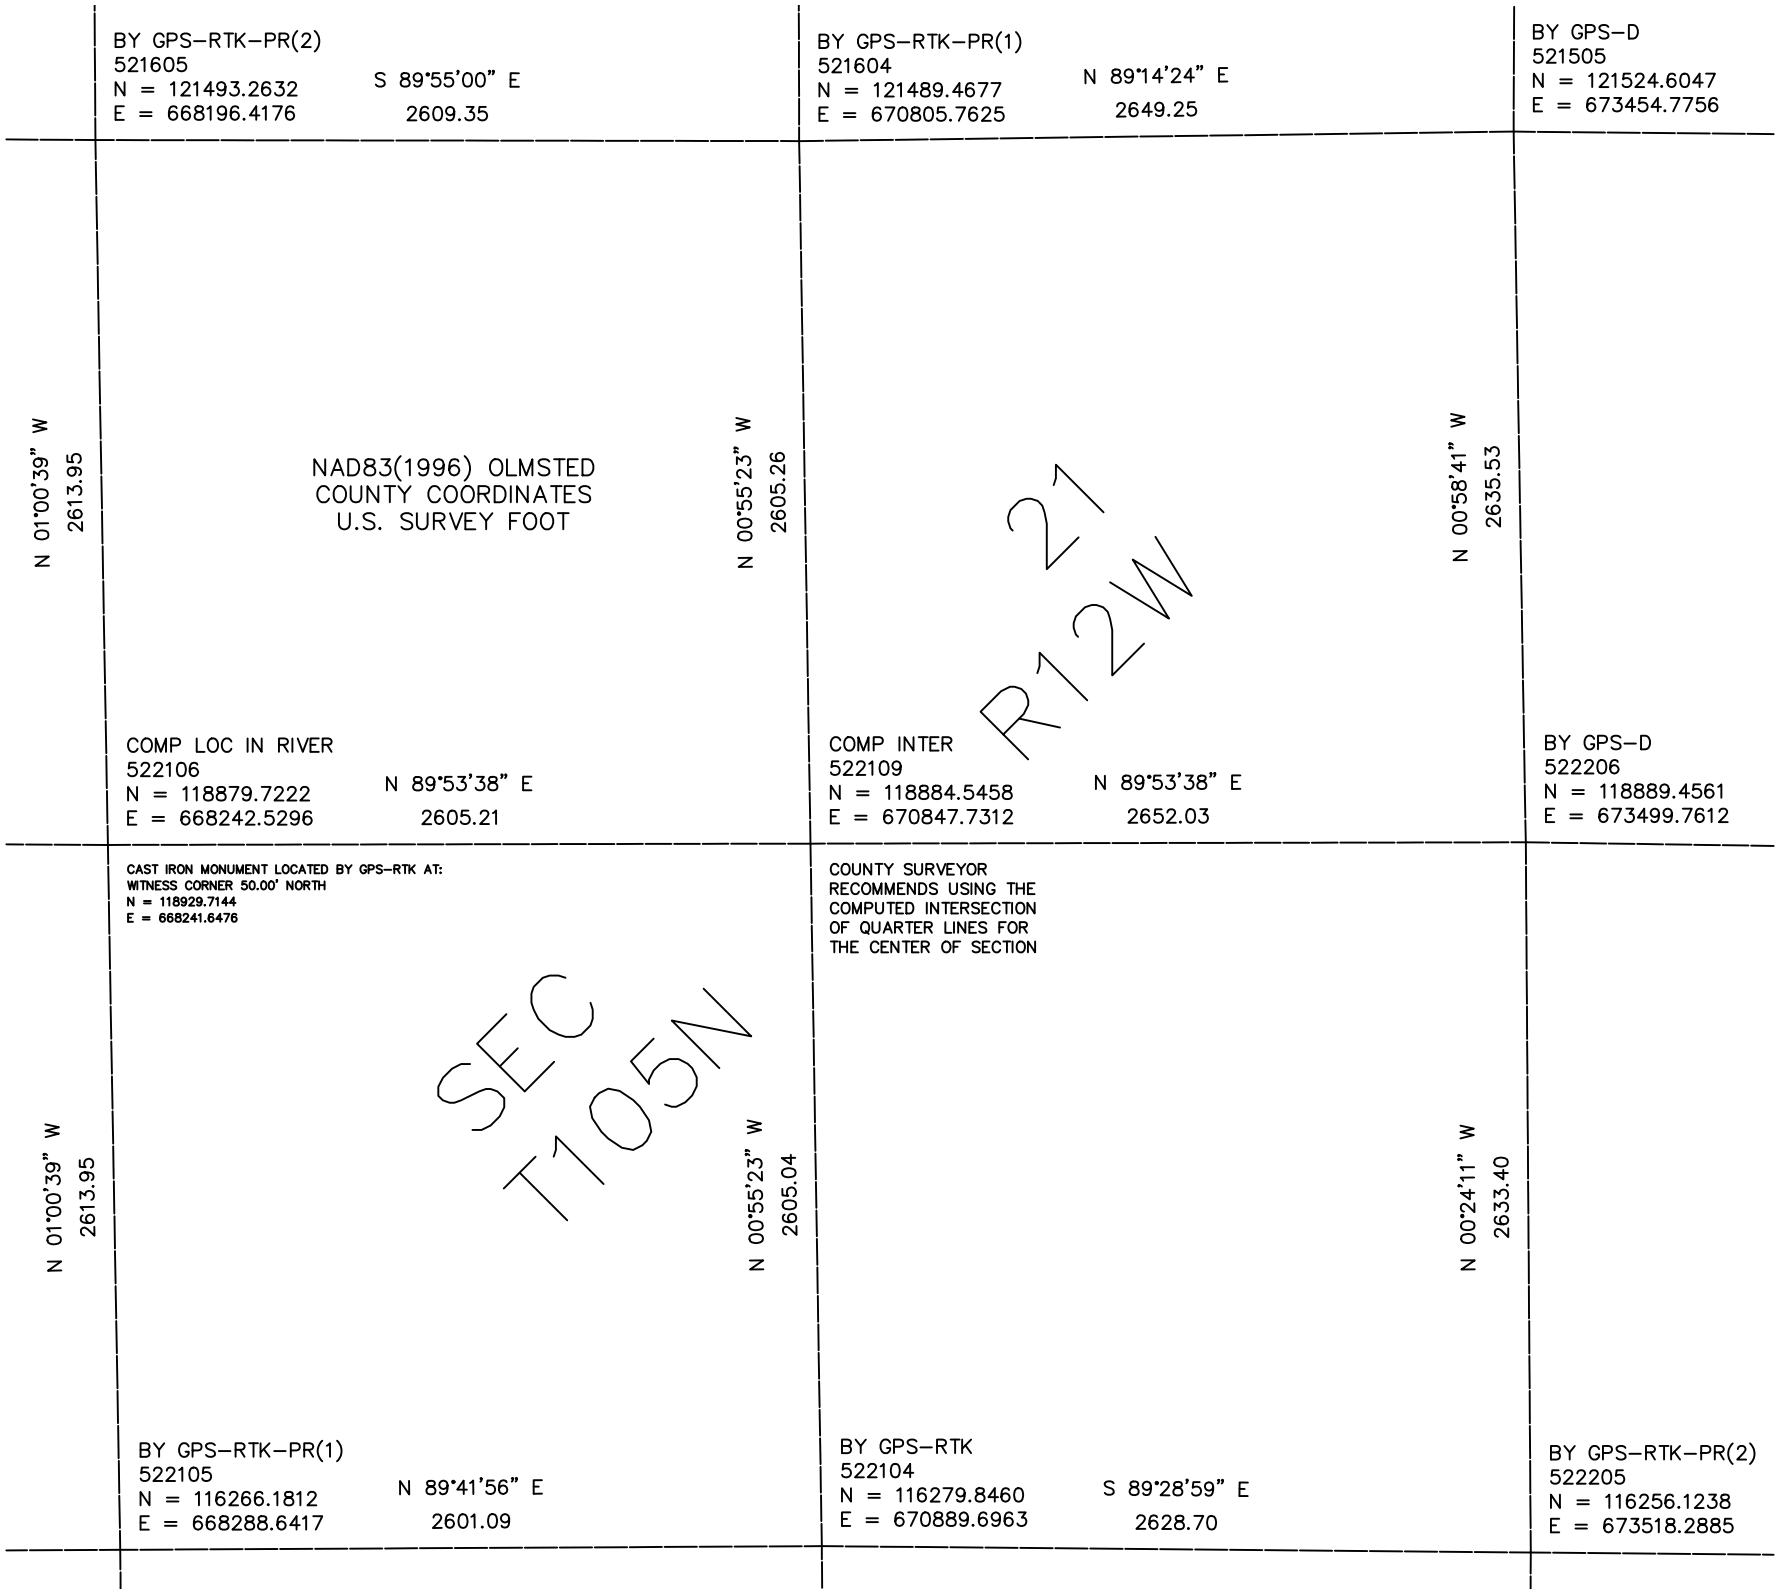

BY GPS–RTK–PR(2)
521605
N = 121493.2632
E = 668196.4176
S 89°55'00" E
2609.35
BY GPS–RTK–PR(1)
521604
N = 121489.4677
E = 670805.7625
N 89°14'24" E
2649.25
BY GPS–D
521505
N = 121524.6047
E = 673454.7756
N 01°00'39" W
2613.95
NAD83(1996) OLMSTED
COUNTY COORDINATES
U.S. SURVEY FOOT
N 00°55'23" W
2605.26
N 00°58'41" W
2635.53
21
R12W
COMP LOC IN RIVER
522106
N = 118879.7222
E = 668242.5296
N 89°53'38" E
2605.21
COMP INTER
522109
N = 118884.5458
E = 670847.7312
N 89°53'38" E
2652.03
BY GPS–D
522206
N = 118889.4561
E = 673499.7612
CAST IRON MONUMENT LOCATED BY GPS–RTK AT:
WITNESS CORNER 50.00' NORTH
N = 118929.7144
E = 668241.6476
COUNTY SURVEYOR
RECOMMENDS USING THE
COMPUTED INTERSECTION
OF QUARTER LINES FOR
THE CENTER OF SECTION
SEC
T105N
N 01°00'39" W
2613.95
N 00°55'23" W
2605.04
N 00°24'11" W
2633.40
BY GPS–RTK–PR(1)
522105
N = 116266.1812
E = 668288.6417
N 89°41'56" E
2601.09
BY GPS–RTK
522104
N = 116279.8460
E = 670889.6963
S 89°28'59" E
2628.70
BY GPS–RTK–PR(2)
522205
N = 116256.1238
E = 673518.2885