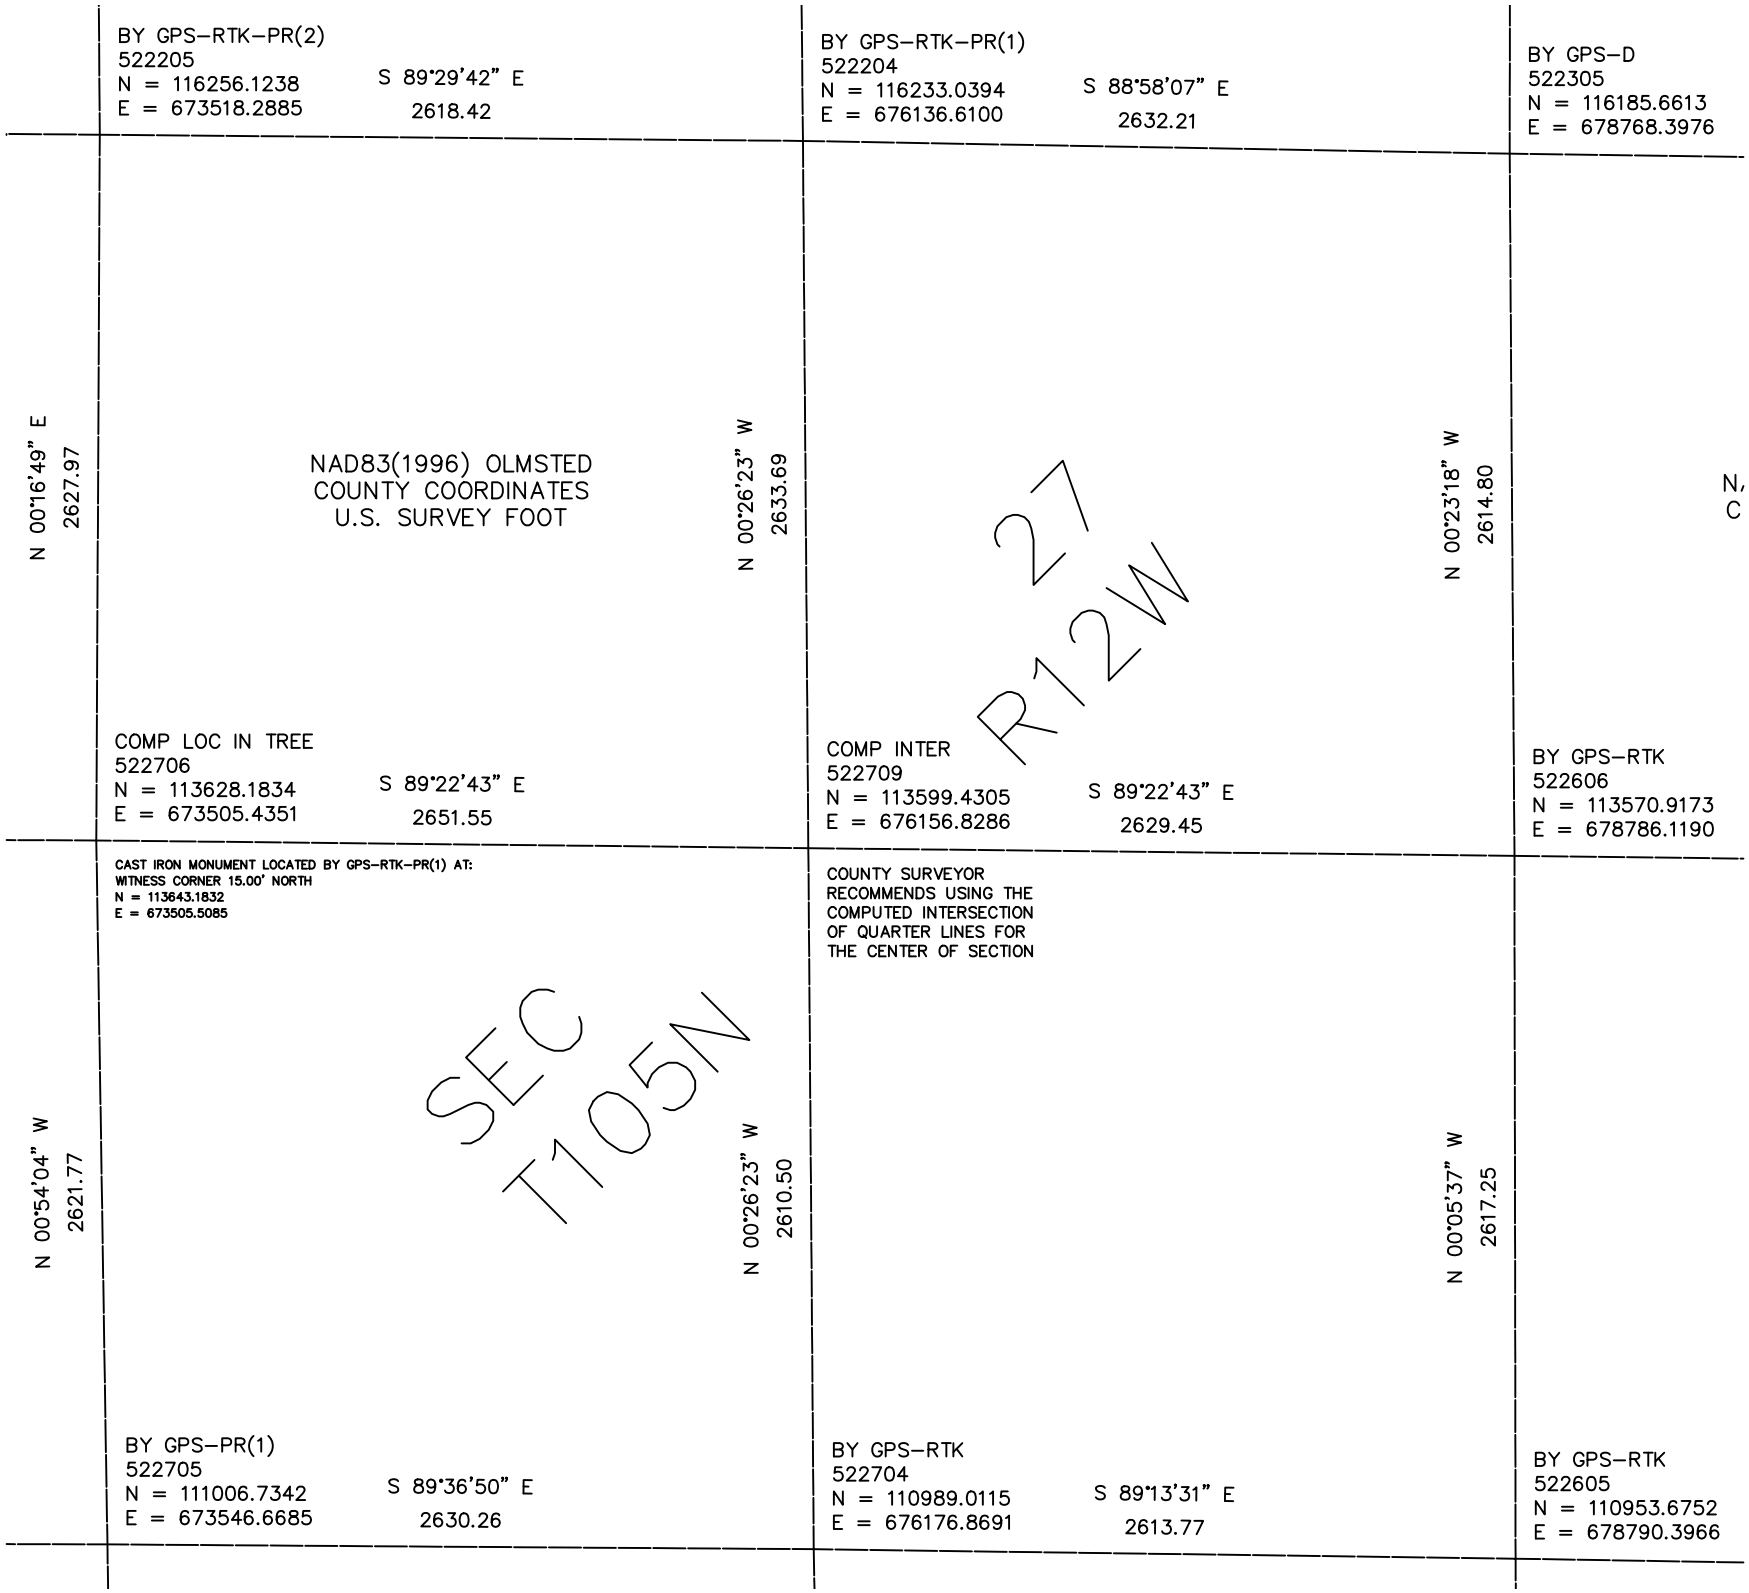

BY GPS–RTK–PR(2)
522205
N = 116256.1238
E = 673518.2885
S 89°29'42" E
2618.42
BY GPS–RTK–PR(1)
522204
N = 116233.0394
E = 676136.6100
S 88°58'07" E
2632.21
BY GPS–D
522305
N = 116185.6613
E = 678768.3976
N 00°16'49" E
2627.97
NAD83(1996) OLMSTED
COUNTY COORDINATES
U.S. SURVEY FOOT
N 00°26'23" W
2633.69
27
R12W
N 00°23'18" W
2614.80
COMP LOC IN TREE
522706
N = 113628.1834
E = 673505.4351
S 89°22'43" E
2651.55
COMP INTER
522709
N = 113599.4305
E = 676156.8286
S 89°22'43" E
2629.45
BY GPS–RTK
522606
N = 113570.9173
E = 678786.1190
CAST IRON MONUMENT LOCATED BY GPS–RTK–PR(1) AT:
WITNESS CORNER 15.00' NORTH
N = 113643.1832
E = 673505.5085
COUNTY SURVEYOR
RECOMMENDS USING THE
COMPUTED INTERSECTION
OF QUARTER LINES FOR
THE CENTER OF SECTION
SEC
T105N
N 00°54'04" W
2621.77
N 00°26'23" W
2610.50
N 00°05'37" W
2617.25
BY GPS–PR(1)
522705
N = 111006.7342
E = 673546.6685
S 89°36'50" E
2630.26
BY GPS–RTK
522704
N = 110989.0115
E = 676176.8691
S 89°13'31" E
2613.77
BY GPS–RTK
522605
N = 110953.6752
E = 678790.3966