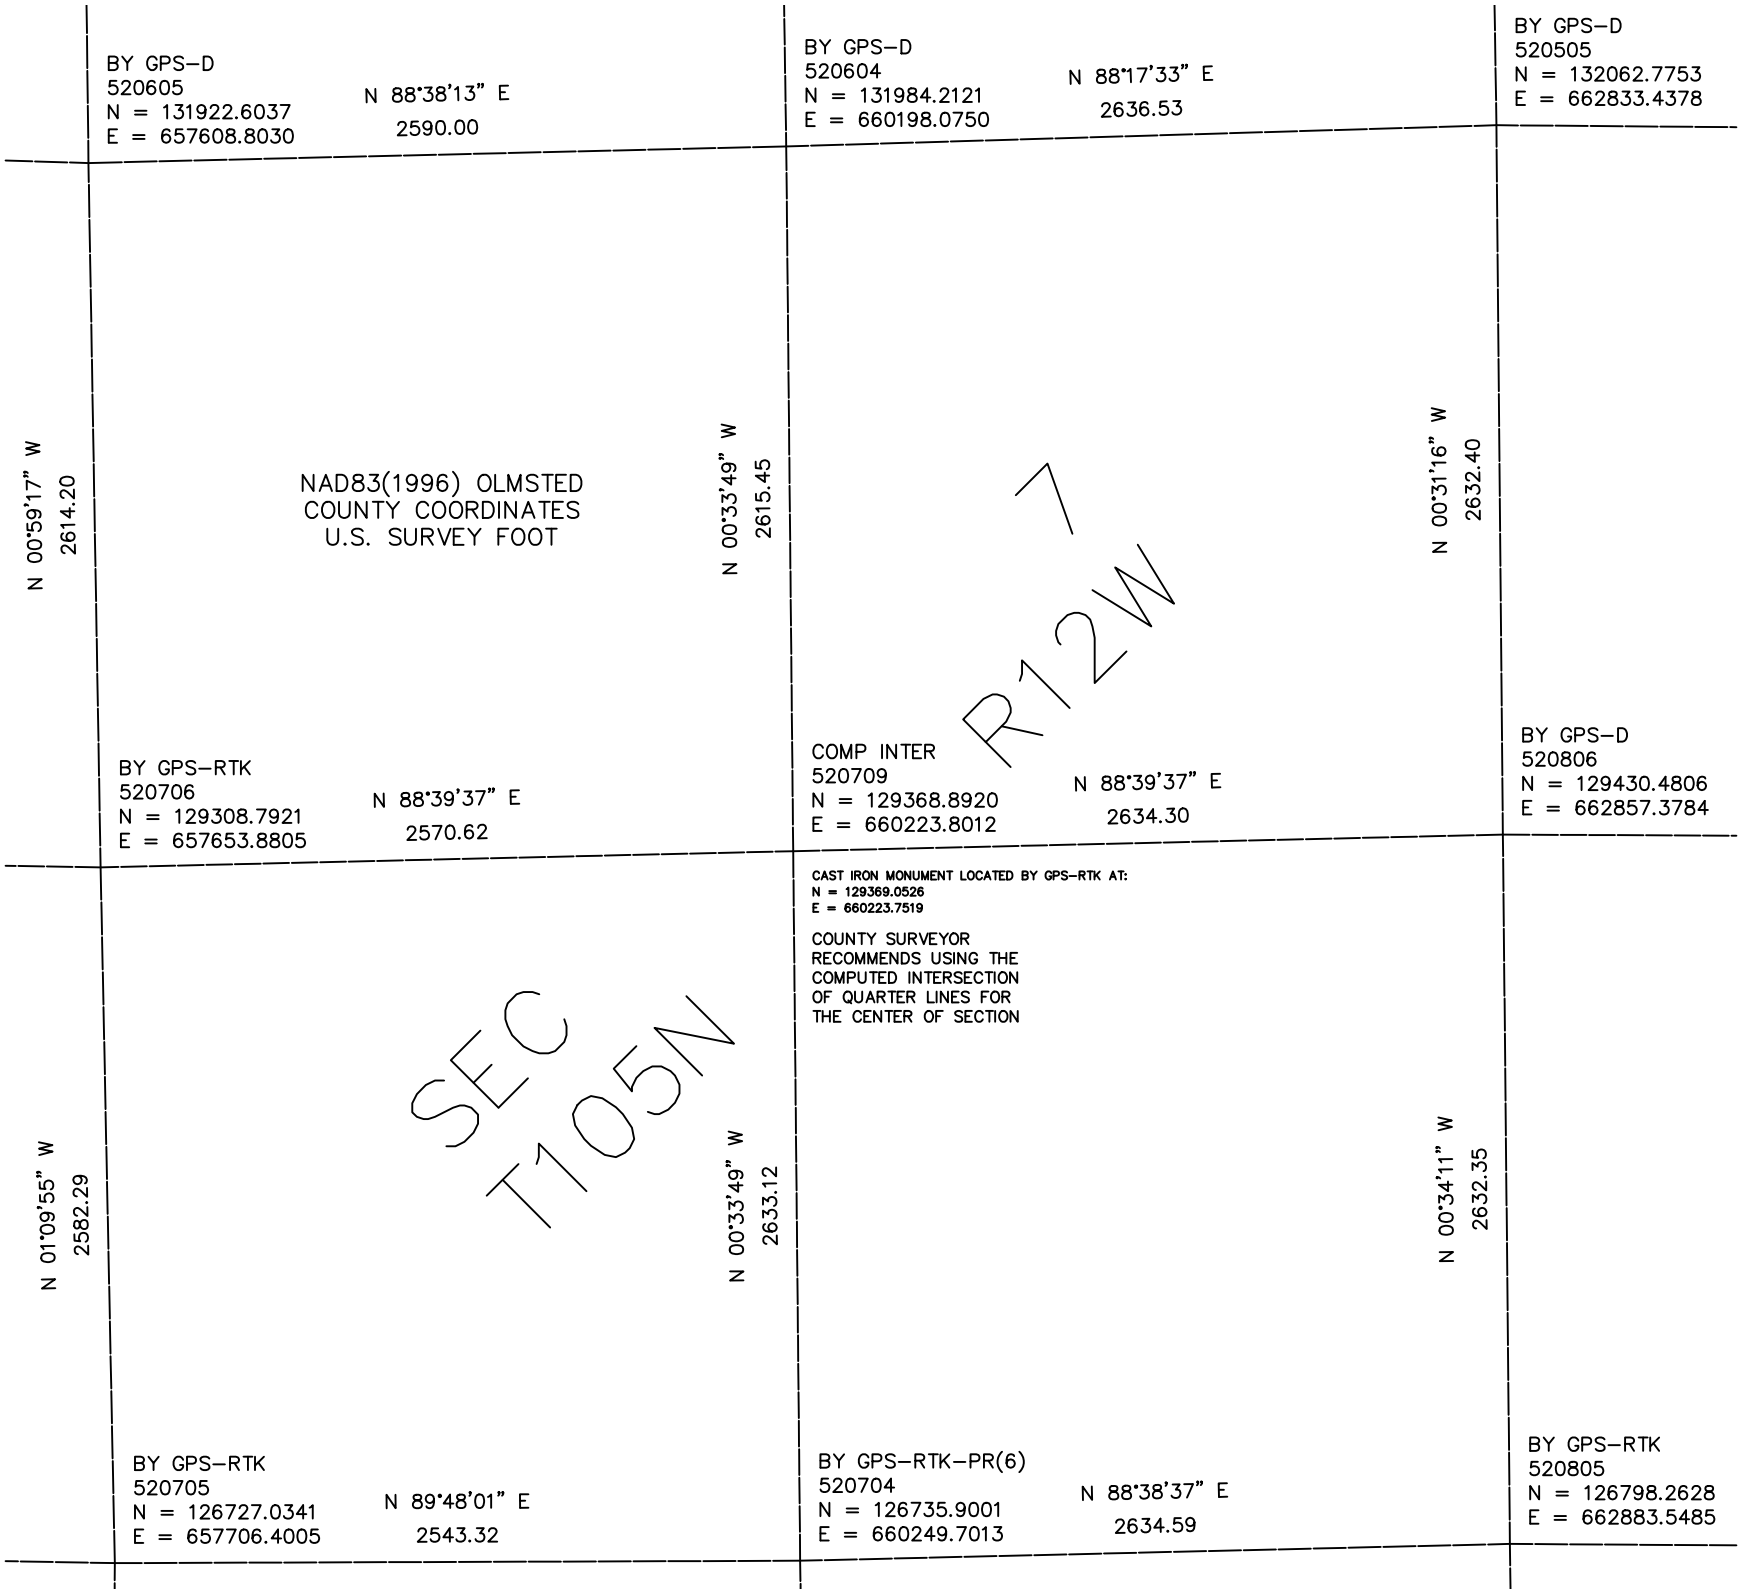

BY GPS–D
520605
N = 131922.6037
E = 657608.8030
N 88°38'13" E
2590.00
BY GPS–D
520604
N = 131984.2121
E = 660198.0750
N 88°17'33" E
2636.53
BY GPS–D
520505
N = 132062.7753
E = 662833.4378
N 00°59'17" W
2614.20
NAD83(1996) OLMSTED
COUNTY COORDINATES
U.S. SURVEY FOOT
N 00°33'49" W
2615.45
N 00°31'16" W
2632.40
7
R12W
BY GPS–RTK
520706
N = 129308.7921
E = 657653.8805
N 88°39'37" E
2570.62
COMP INTER
520709
N = 129368.8920
E = 660223.8012
N 88°39'37" E
2634.30
BY GPS–D
520806
N = 129430.4806
E = 662857.3784
CAST IRON MONUMENT LOCATED BY GPS–RTK AT:
N = 129369.0526
E = 660223.7519
COUNTY SURVEYOR
RECOMMENDS USING THE
COMPUTED INTERSECTION
OF QUARTER LINES FOR
THE CENTER OF SECTION
SEC
T105N
N 01°09'55" W
2582.29
N 00°33'49" W
2633.12
N 00°34'11" W
2632.35
BY GPS–RTK
520705
N = 126727.0341
E = 657706.4005
N 89°48'01" E
2543.32
BY GPS–RTK–PR(6)
520704
N = 126735.9001
E = 660249.7013
N 88°38'37" E
2634.59
BY GPS–RTK
520805
N = 126798.2628
E = 662883.5485