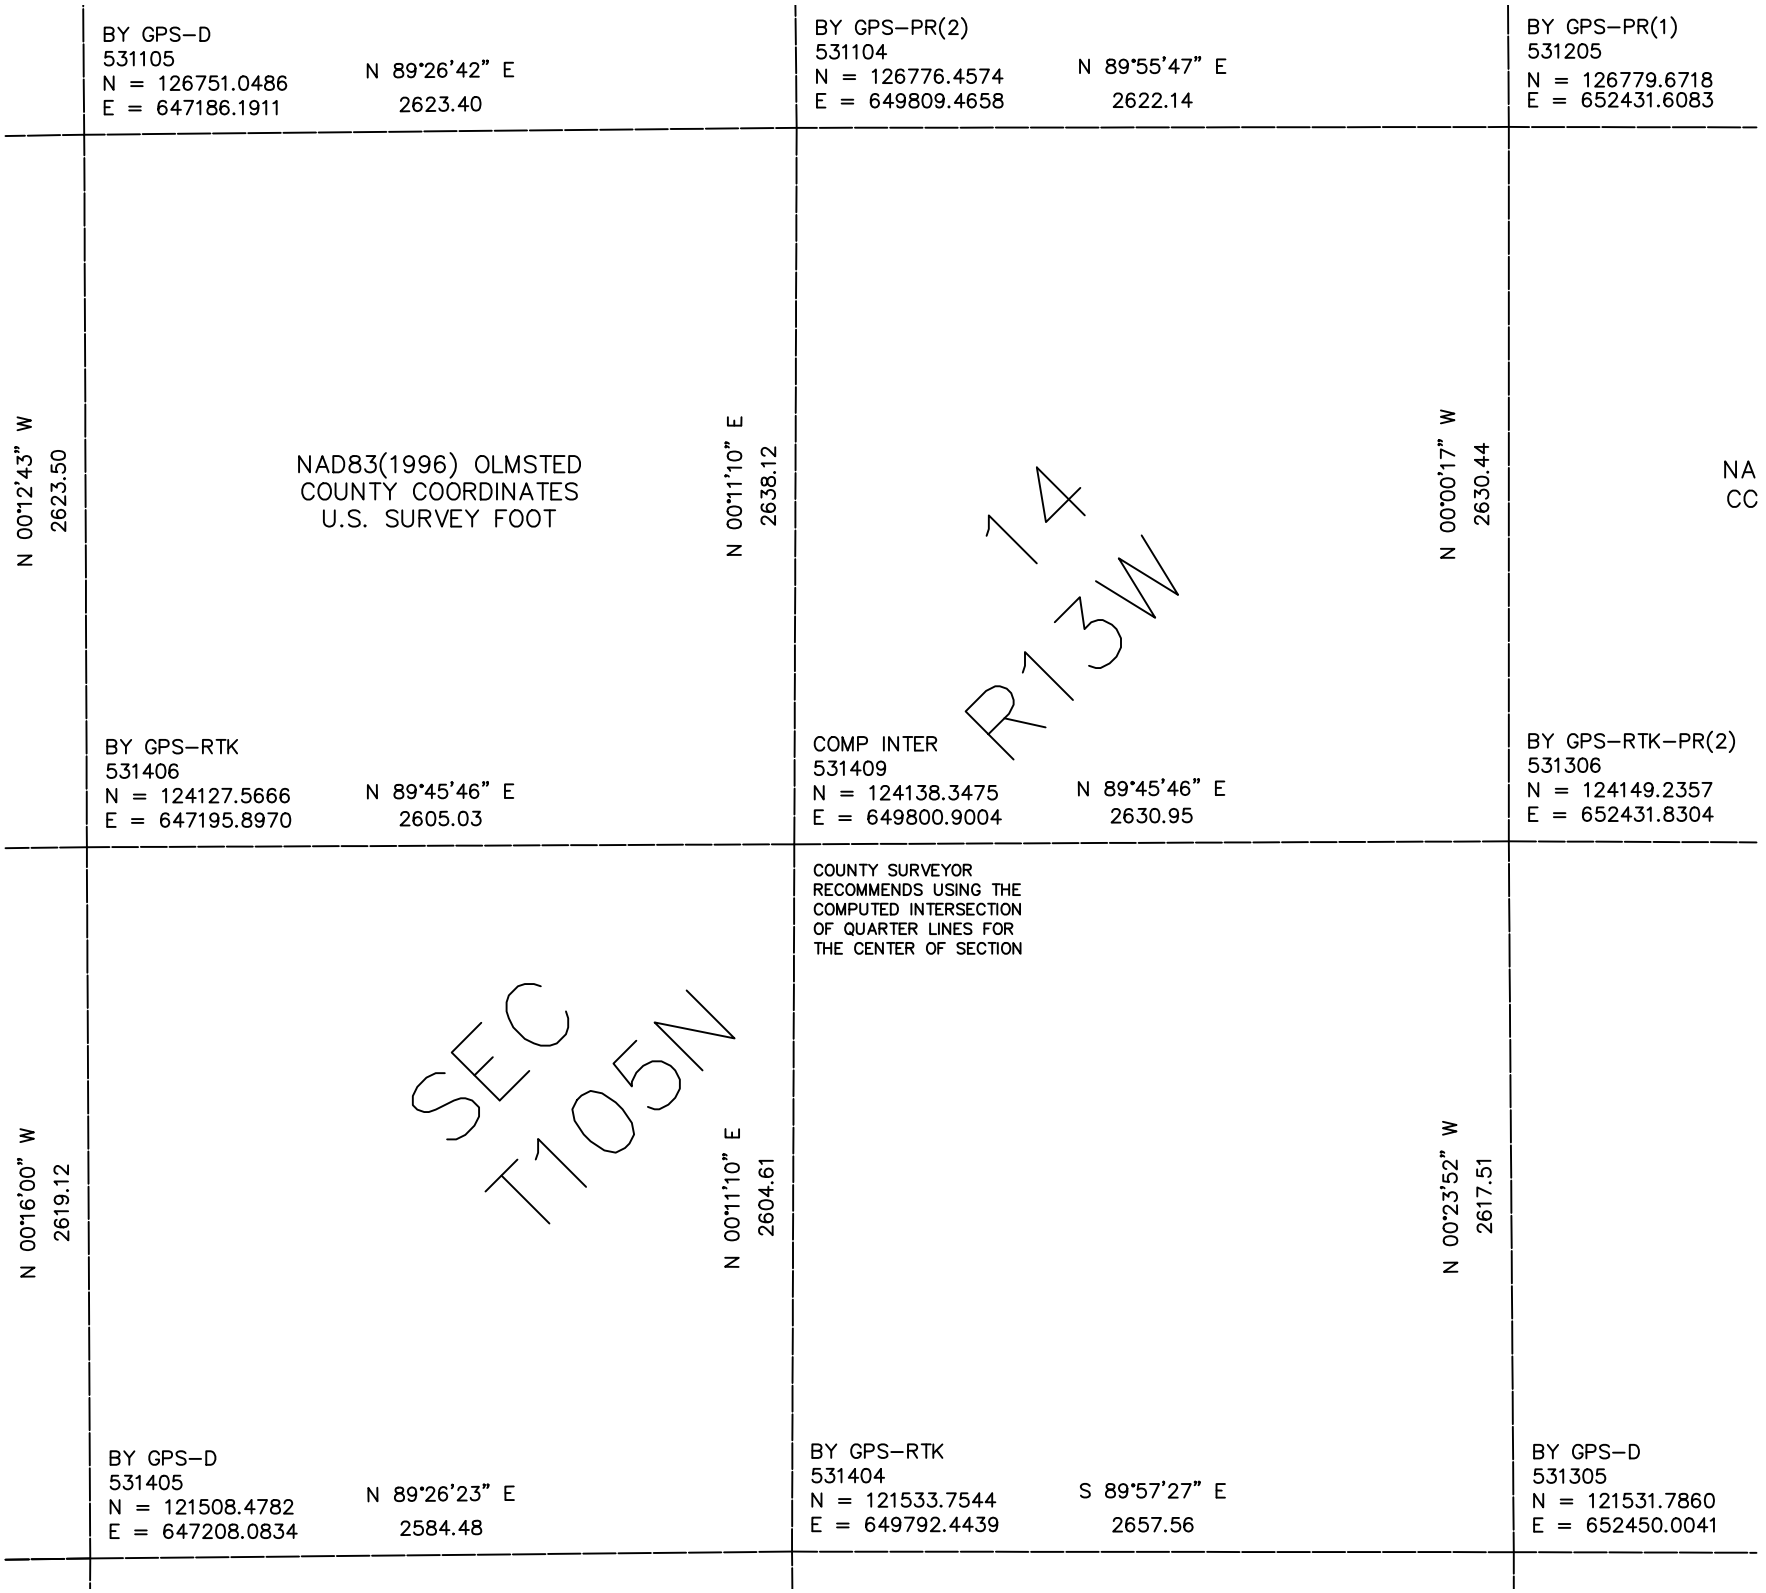

BY GPS–D
531105
N = 126751.0486
E = 647186.1911
N 89°26'42" E
2623.40
BY GPS–PR(2)
531104
N = 126776.4574
E = 649809.4658
N 89°55'47" E
2622.14
BY GPS–PR(1)
531205
N = 126779.6718
E = 652431.6083
N 00°12'43" W
2623.50
NAD83(1996) OLMSTED
COUNTY COORDINATES
U.S. SURVEY FOOT
N 00°11'10" E
2638.12
14
R13W
N 00°00'17" W
2630.44
NA
CC
BY GPS–RTK
531406
N = 124127.5666
E = 647195.8970
N 89°45'46" E
2605.03
COMP INTER
531409
N = 124138.3475
E = 649800.9004
N 89°45'46" E
2630.95
BY GPS–RTK–PR(2)
531306
N = 124149.2357
E = 652431.8304
COUNTY SURVEYOR
RECOMMENDS USING THE
COMPUTED INTERSECTION
OF QUARTER LINES FOR
THE CENTER OF SECTION
N 00°16'00" W
2619.12
SEC
T105N
N 00°11'10" E
2604.61
N 00°23'52" W
2617.51
BY GPS–D
531405
N = 121508.4782
E = 647208.0834
N 89°26'23" E
2584.48
BY GPS–RTK
531404
N = 121533.7544
E = 649792.4439
S 89°57'27" E
2657.56
BY GPS–D
531305
N = 121531.7860
E = 652450.0041