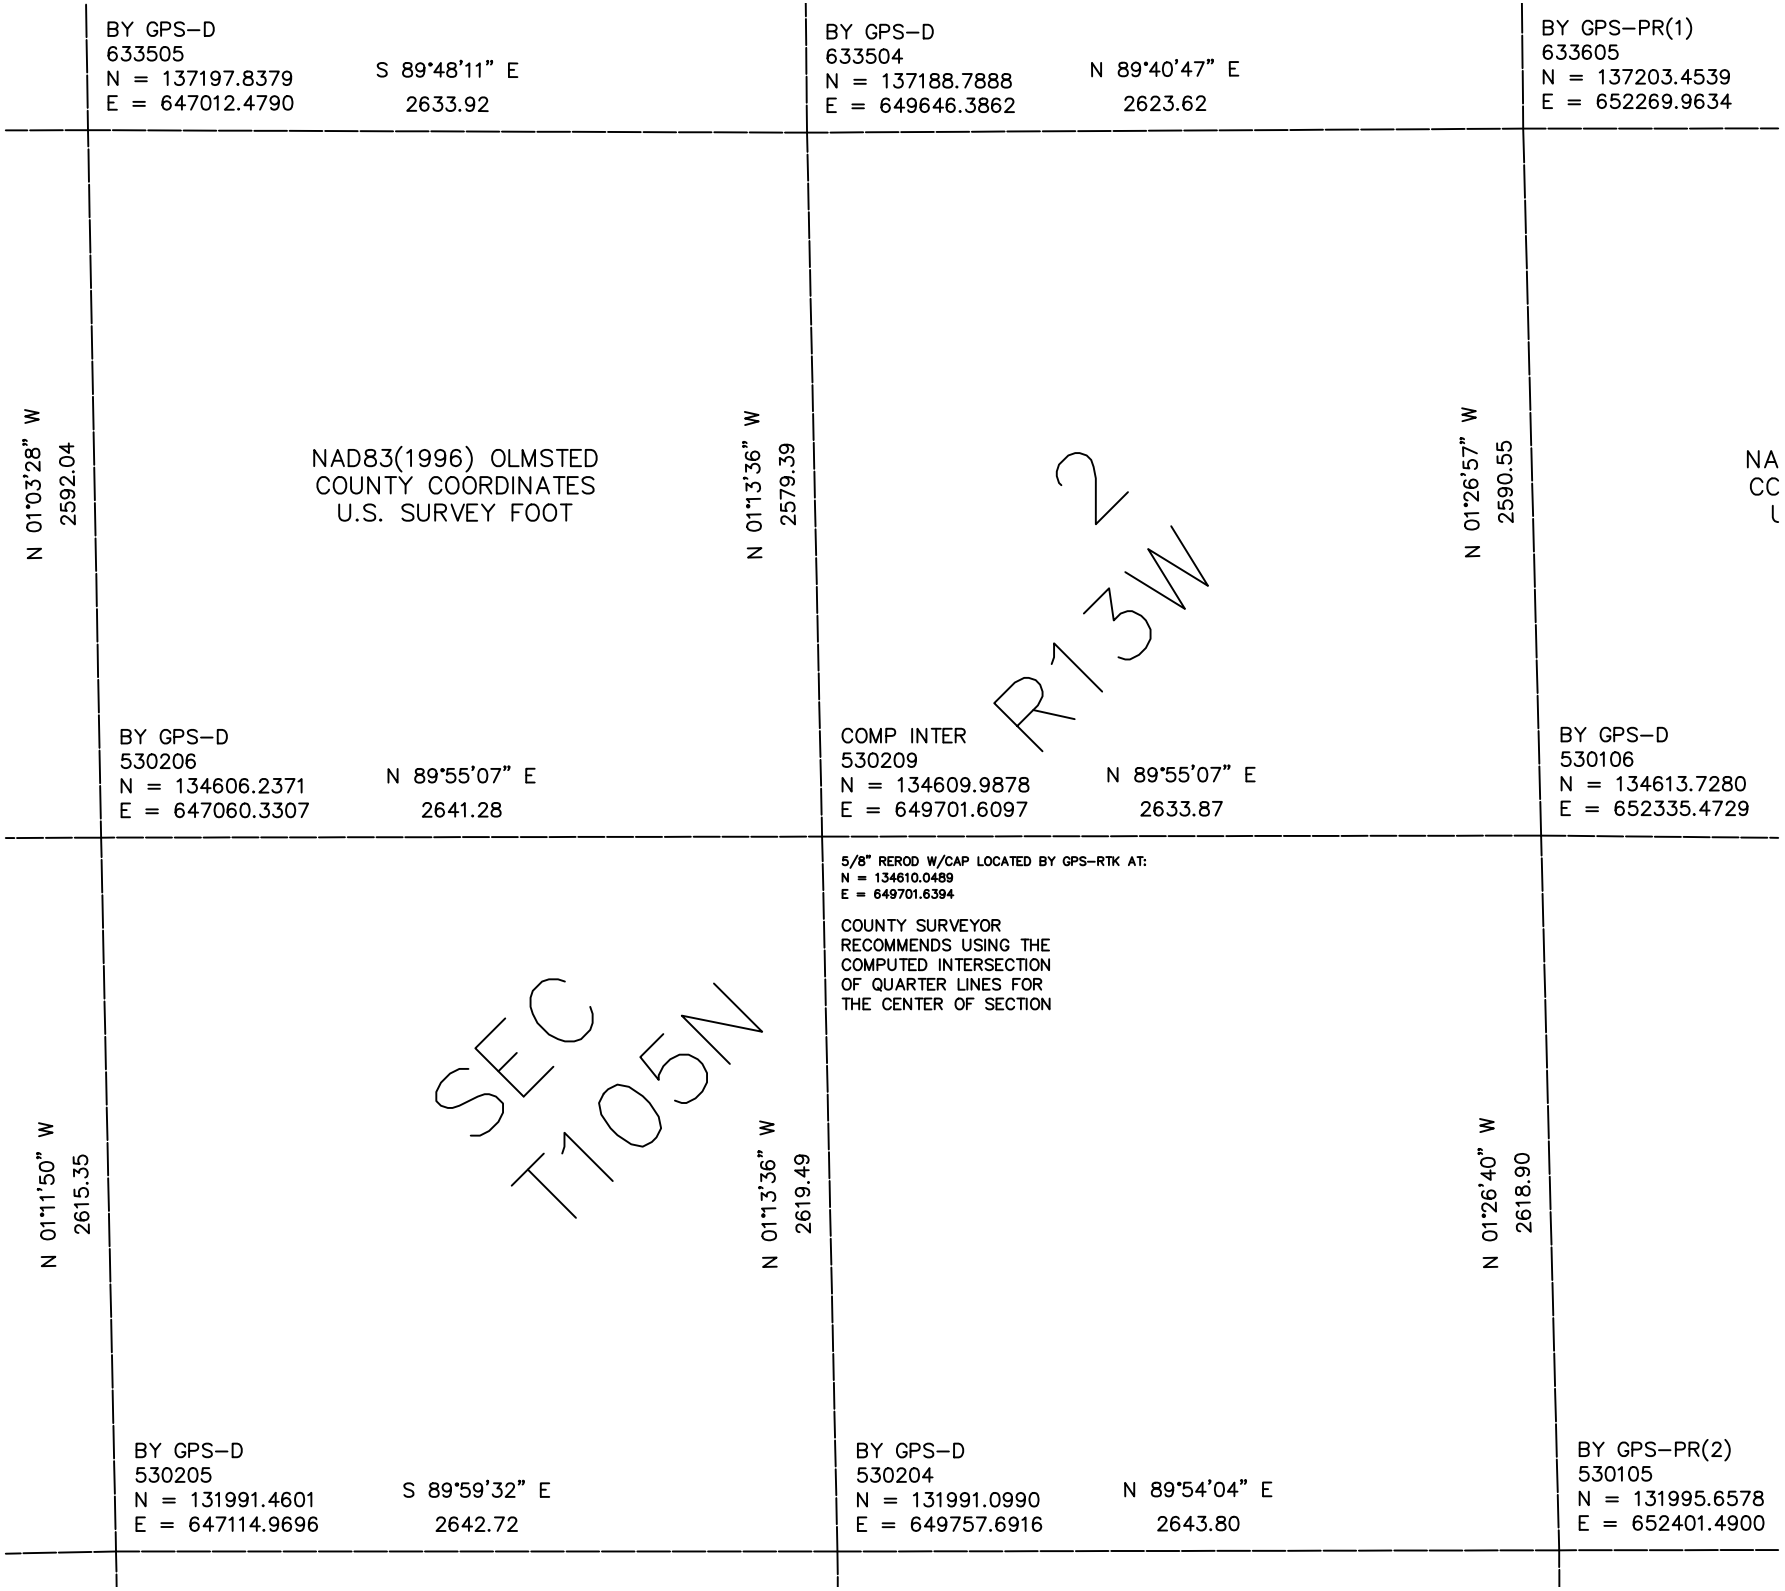

BY GPS–D
633505
N = 137197.8379
E = 647012.4790
S 89°48'11" E
2633.92
BY GPS–D
633504
N = 137188.7888
E = 649646.3862
N 89°40'47" E
2623.62
BY GPS–PR(1)
633605
N = 137203.4539
E = 652269.9634
N 01°03'28" W
2592.04
NAD83(1996) OLMSTED
COUNTY COORDINATES
U.S. SURVEY FOOT
N 01°13'36" W
2579.39
N 01°26'57" W
2590.55
NA
CC
L
R13W
2
BY GPS–D
530206
N = 134606.2371
E = 647060.3307
N 89°55'07" E
2641.28
COMP INTER
530209
N = 134609.9878
E = 649701.6097
N 89°55'07" E
2633.87
BY GPS–D
530106
N = 134613.7280
E = 652335.4729
5/8" REROD W/CAP LOCATED BY GPS–RTK AT:
N = 134610.0489
E = 649701.6394
COUNTY SURVEYOR
RECOMMENDS USING THE
COMPUTED INTERSECTION
OF QUARTER LINES FOR
THE CENTER OF SECTION
N 01°11'50" W
2615.35
SEC
T105N
N 01°13'36" W
2619.49
N 01°26'40" W
2618.90
BY GPS–D
530205
N = 131991.4601
E = 647114.9696
S 89°59'32" E
2642.72
BY GPS–D
530204
N = 131991.0990
E = 649757.6916
N 89°54'04" E
2643.80
BY GPS–PR(2)
530105
N = 131995.6578
E = 652401.4900