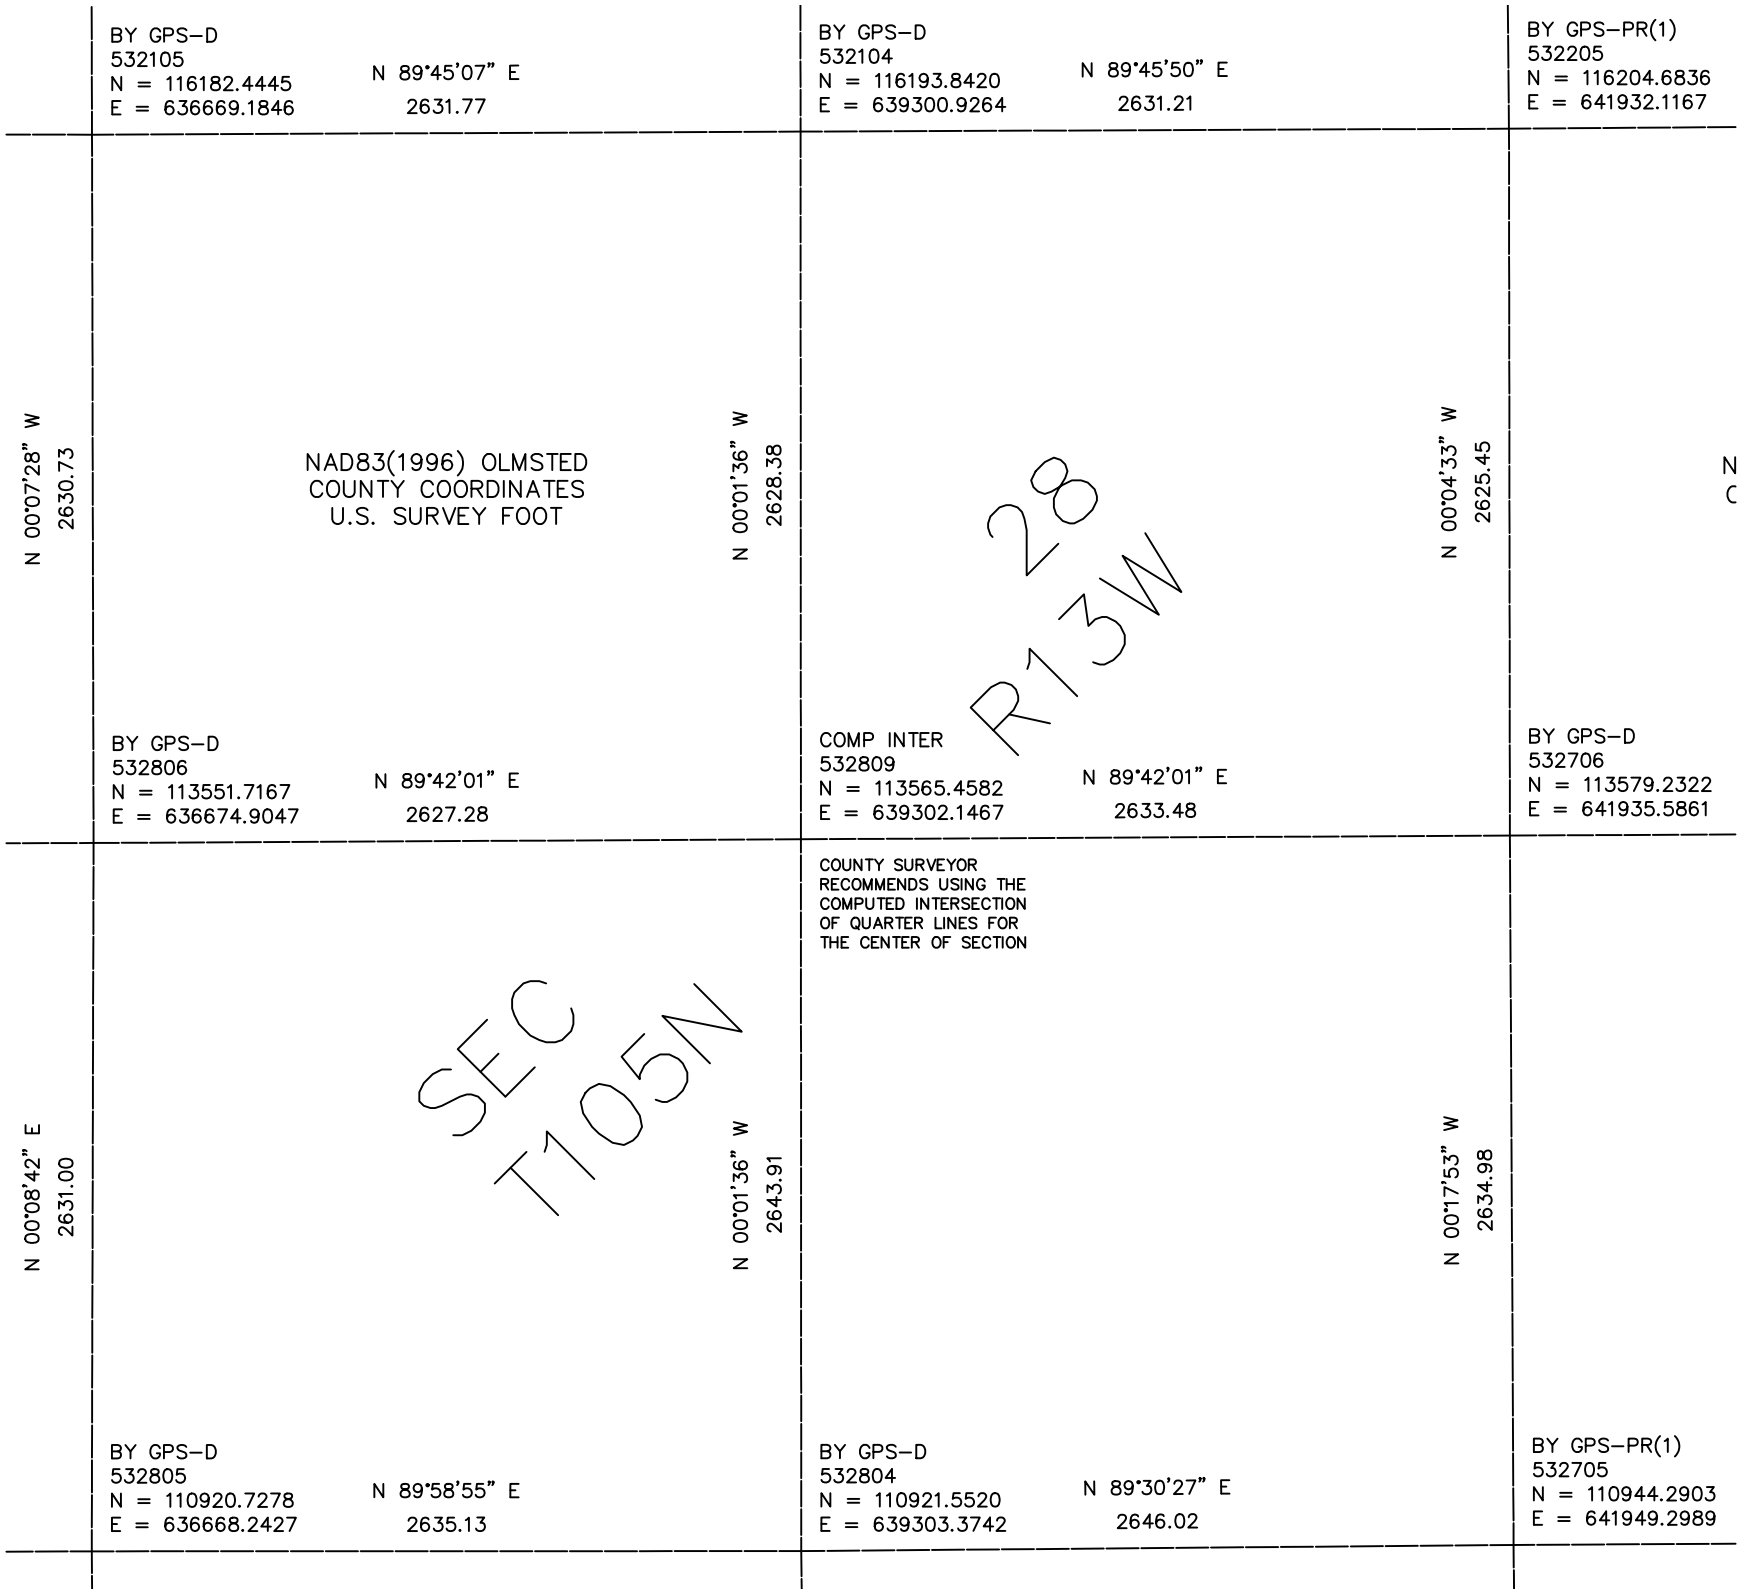

BY GPS–D
532105
N = 116182.4445
E = 636669.1846
N 89°45'07" E
2631.77
BY GPS–D
532104
N = 116193.8420
E = 639300.9264
N 89°45'50" E
2631.21
BY GPS–PR(1)
532205
N = 116204.6836
E = 641932.1167
N 00°07'28" W
2630.73
NAD83(1996) OLMSTED
COUNTY COORDINATES
U.S. SURVEY FOOT
N 00°01'36" W
2628.38
N 00°04'33" W
2625.45
28
R13W
BY GPS–D
532806
N = 113551.7167
E = 636674.9047
N 89°42'01" E
2627.28
COMP INTER
532809
N = 113565.4582
E = 639302.1467
N 89°42'01" E
2633.48
BY GPS–D
532706
N = 113579.2322
E = 641935.5861
COUNTY SURVEYOR
RECOMMENDS USING THE
COMPUTED INTERSECTION
OF QUARTER LINES FOR
THE CENTER OF SECTION
N 00°08'42" E
2631.00
SEC
T105N
N 00°01'36" W
2643.91
N 00°17'53" W
2634.98
BY GPS–D
532805
N = 110920.7278
E = 636668.2427
N 89°58'55" E
2635.13
BY GPS–D
532804
N = 110921.5520
E = 639303.3742
N 89°30'27" E
2646.02
BY GPS–PR(1)
532705
N = 110944.2903
E = 641949.2989