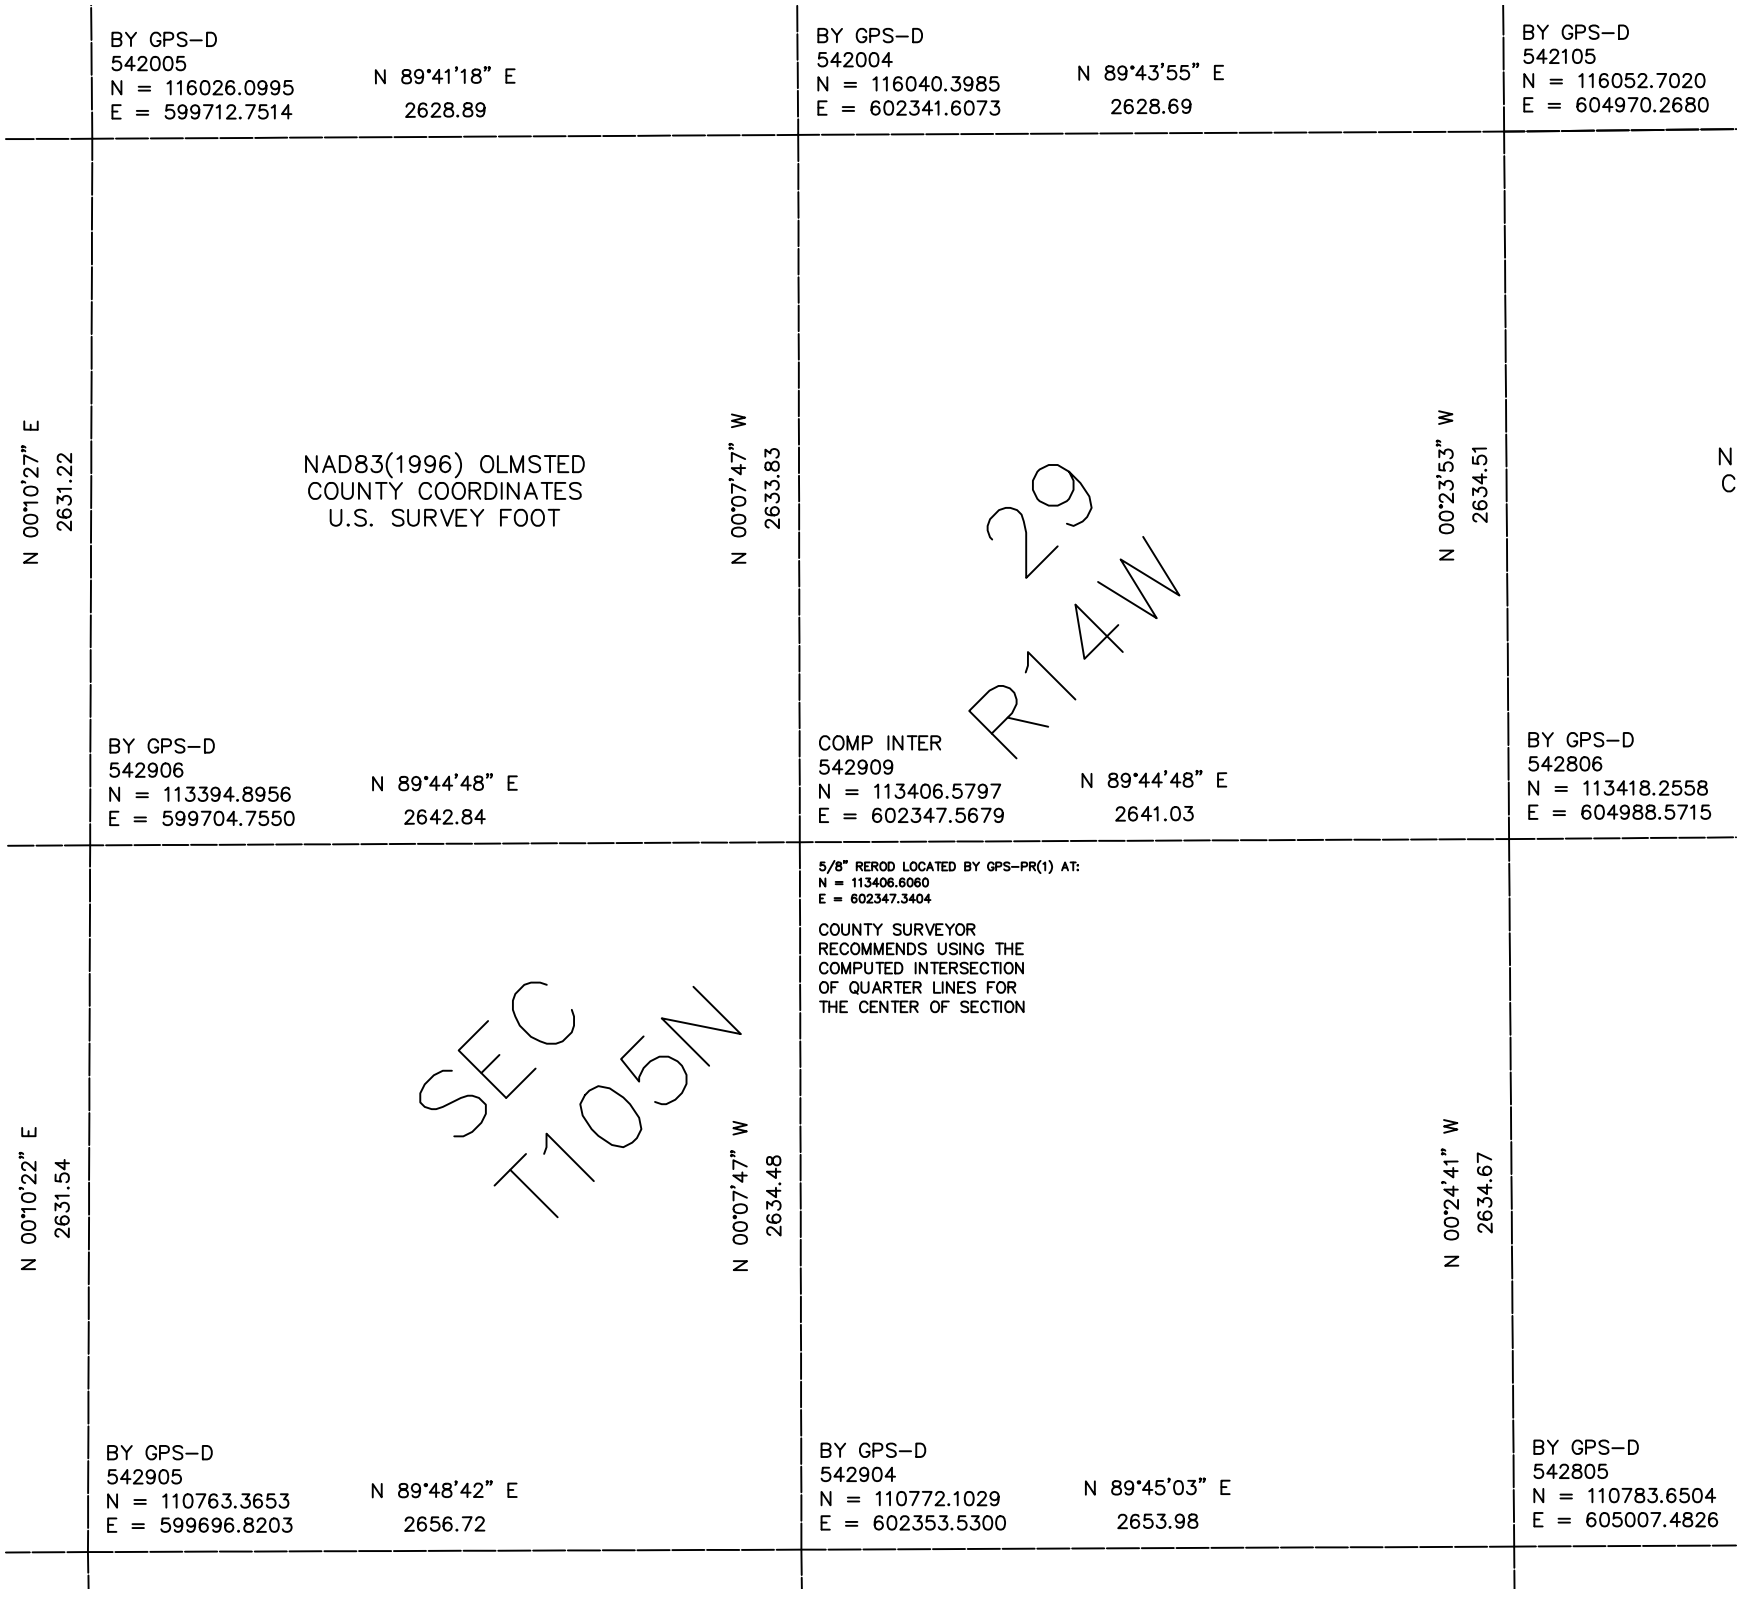

BY GPS–D
542005
N = 116026.0995
E = 599712.7514
N 89°41'18" E
2628.89
BY GPS–D
542004
N = 116040.3985
E = 602341.6073
N 89°43'55" E
2628.69
BY GPS–D
542105
N = 116052.7020
E = 604970.2680
N 00°10'27" E
2631.22
NAD83(1996) OLMSTED
COUNTY COORDINATES
U.S. SURVEY FOOT
N 00°07'47" W
2633.83
N 00°23'53" W
2634.51
29
R14W
N
C
BY GPS–D
542906
N = 113394.8956
E = 599704.7550
N 89°44'48" E
2642.84
COMP INTER
542909
N = 113406.5797
E = 602347.5679
N 89°44'48" E
2641.03
BY GPS–D
542806
N = 113418.2558
E = 604988.5715
N 00°10'22" E
2631.54
SEC
T105N
N 00°07'47" W
2634.48
5/8" REROD LOCATED BY GPS–PR(1) AT:
N = 113406.6060
E = 602347.3404
COUNTY SURVEYOR
RECOMMENDS USING THE
COMPUTED INTERSECTION
OF QUARTER LINES FOR
THE CENTER OF SECTION
N 00°24'41" W
2634.67
BY GPS–D
542905
N = 110763.3653
E = 599696.8203
N 89°48'42" E
2656.72
BY GPS–D
542904
N = 110772.1029
E = 602353.5300
N 89°45'03" E
2653.98
BY GPS–D
542805
N = 110783.6504
E = 605007.4826