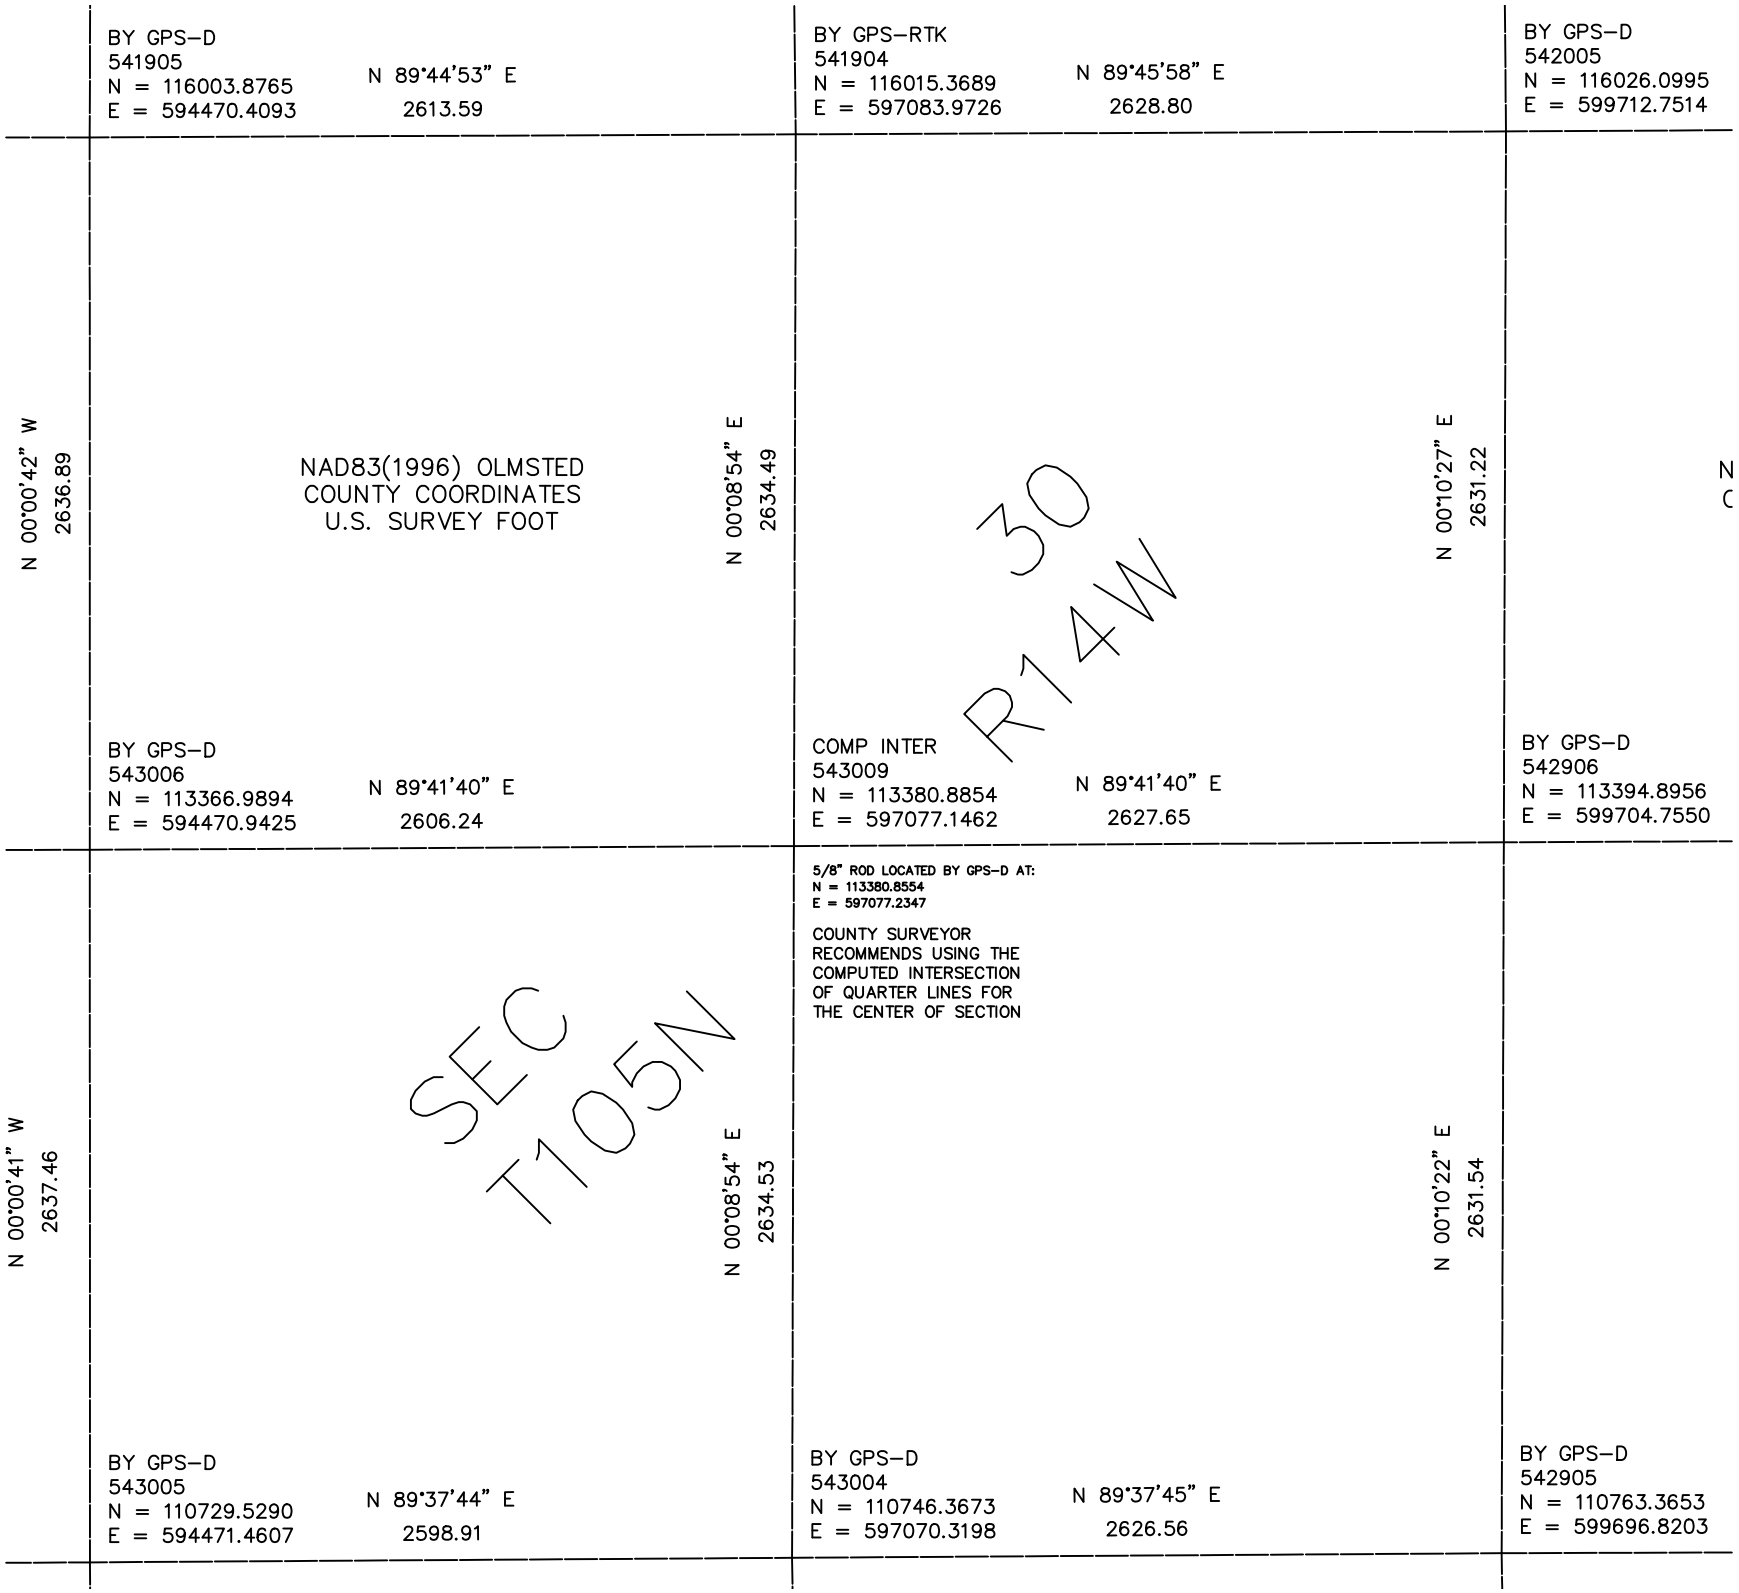

BY GPS–D
541905
N = 116003.8765
E = 594470.4093
N 89°44'53" E
2613.59
BY GPS–RTK
541904
N = 116015.3689
E = 597083.9726
N 89°45'58" E
2628.80
BY GPS–D
542005
N = 116026.0995
E = 599712.7514
N 00°00'42" W
2636.89
NAD83(1996) OLMSTED
COUNTY COORDINATES
U.S. SURVEY FOOT
N 00°08'54" E
2634.49
30
R14W
N 00°10'27" E
2631.22
BY GPS–D
543006
N = 113366.9894
E = 594470.9425
N 89°41'40" E
2606.24
COMP INTER
543009
N = 113380.8854
E = 597077.1462
N 89°41'40" E
2627.65
BY GPS–D
542906
N = 113394.8956
E = 599704.7550
5/8" ROD LOCATED BY GPS–D AT:
N = 113380.8554
E = 597077.2347
COUNTY SURVEYOR
RECOMMENDS USING THE
COMPUTED INTERSECTION
OF QUARTER LINES FOR
THE CENTER OF SECTION
N 00°00'41" W
2637.46
SEC
T105N
N 00°08'54" E
2634.53
N 00°10'22" E
2631.54
BY GPS–D
543005
N = 110729.5290
E = 594471.4607
N 89°37'44" E
2598.91
BY GPS–D
543004
N = 110746.3673
E = 597070.3198
N 89°37'45" E
2626.56
BY GPS–D
542905
N = 110763.3653
E = 599696.8203