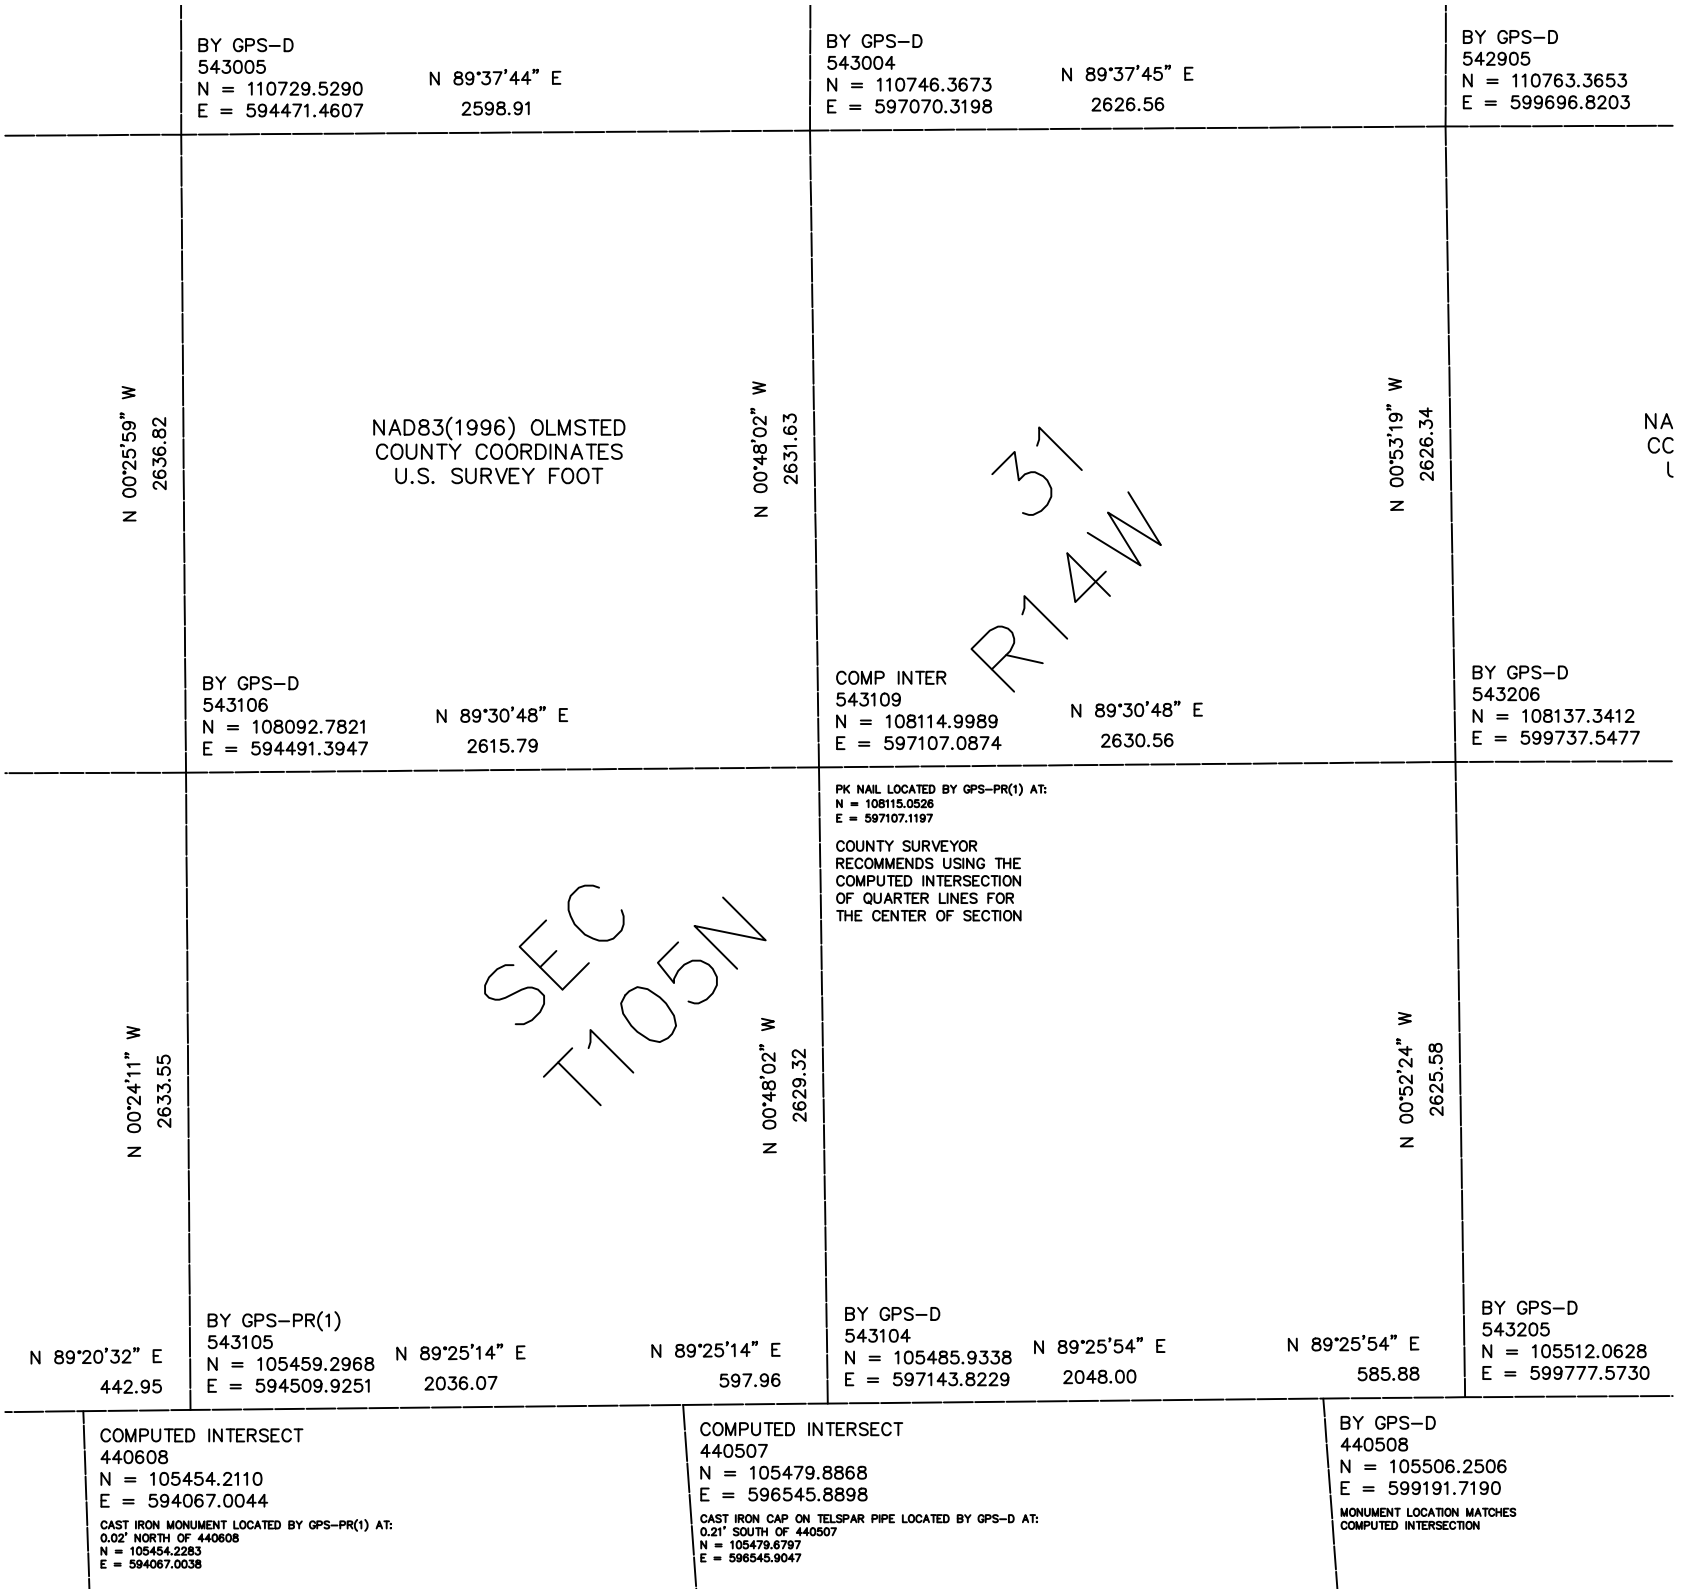

BY GPS–D
543005
N = 110729.5290
E = 594471.4607
N 89°37'44" E
2598.91
BY GPS–D
543004
N = 110746.3673
E = 597070.3198
N 89°37'45" E
2626.56
BY GPS–D
542905
N = 110763.3653
E = 599696.8203
N 00°25'59" W
2636.82
NAD83(1996) OLMSTED
COUNTY COORDINATES
U.S. SURVEY FOOT
N 00°48'02" W
2631.63
N 00°53'19" W
2626.34
NA
CC
L
31
R14W
BY GPS–D
543106
N = 108092.7821
E = 594491.3947
N 89°30'48" E
2615.79
COMP INTER
543109
N = 108114.9989
E = 597107.0874
N 89°30'48" E
2630.56
BY GPS–D
543206
N = 108137.3412
E = 599737.5477
PK NAIL LOCATED BY GPS–PR(1) AT:
N = 108115.0526
E = 597107.1197
COUNTY SURVEYOR
RECOMMENDS USING THE
COMPUTED INTERSECTION
OF QUARTER LINES FOR
THE CENTER OF SECTION
SEC
T105N
N 00°24'11" W
2633.55
N 00°48'02" W
2629.32
N 00°52'24" W
2625.58
N 89°20'32" E
442.95
BY GPS–PR(1)
543105
N = 105459.2968
E = 594509.9251
N 89°25'14" E
2036.07
N 89°25'14" E
597.96
BY GPS–D
543104
N = 105485.9338
E = 597143.8229
N 89°25'54" E
2048.00
N 89°25'54" E
585.88
BY GPS–D
543205
N = 105512.0628
E = 599777.5730
COMPUTED INTERSECT
440608
N = 105454.2110
E = 594067.0044
CAST IRON MONUMENT LOCATED BY GPS–PR(1) AT:
0.02' NORTH OF 440608
N = 105454.2283
E = 594067.0038
COMPUTED INTERSECT
440507
N = 105479.8868
E = 596545.8898
CAST IRON CAP ON TELSPAR PIPE LOCATED BY GPS–D AT:
0.21' SOUTH OF 440507
N = 105479.6797
E = 596545.9047
BY GPS–D
440508
N = 105506.2506
E = 599191.7190
MONUMENT LOCATION MATCHES
COMPUTED INTERSECTION