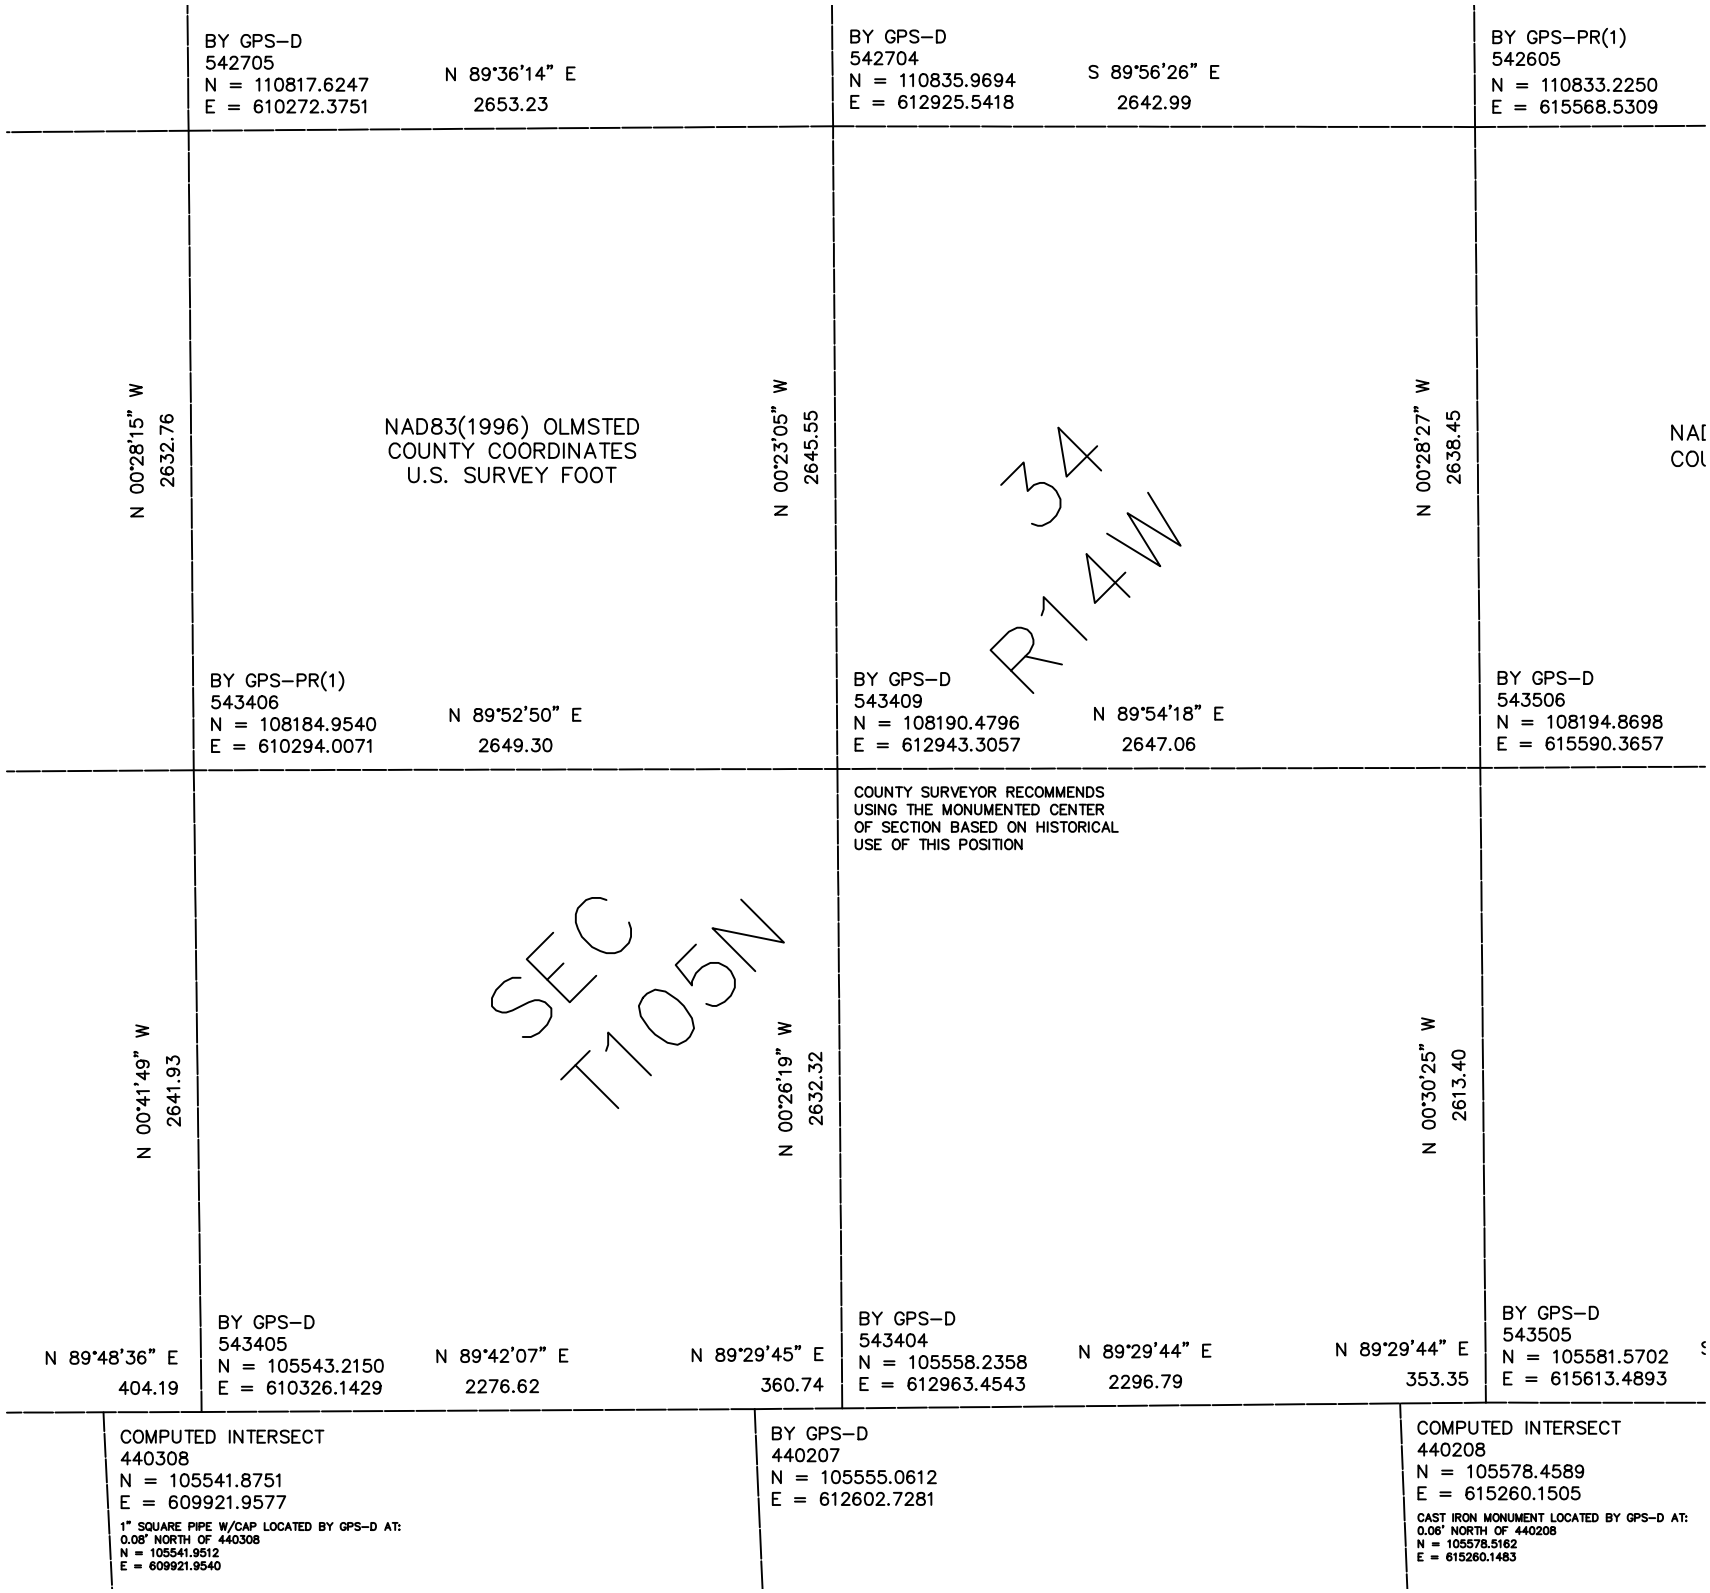

BY GPS–D
542705
N = 110817.6247
E = 610272.3751
N 89°36'14" E
2653.23
BY GPS–D
542704
N = 110835.9694
E = 612925.5418
S 89°56'26" E
2642.99
BY GPS–PR(1)
542605
N = 110833.2250
E = 615568.5309
N 00°28'15" W
2632.76
NAD83(1996) OLMSTED
COUNTY COORDINATES
U.S. SURVEY FOOT
N 00°23'05" W
2645.55
34
R14W
N 00°28'27" W
2638.45
NAI
COU
BY GPS–PR(1)
543406
N = 108184.9540
E = 610294.0071
N 89°52'50" E
2649.30
BY GPS–D
543409
N = 108190.4796
E = 612943.3057
N 89°54'18" E
2647.06
BY GPS–D
543506
N = 108194.8698
E = 615590.3657
COUNTY SURVEYOR RECOMMENDS
USING THE MONUMENTED CENTER
OF SECTION BASED ON HISTORICAL
USE OF THIS POSITION
N 00°41'49" W
2641.93
SEC
T105N
N 00°26'19" W
2632.32
N 00°30'25" W
2613.40
N 89°48'36" E
404.19
BY GPS–D
543405
N = 105543.2150
E = 610326.1429
N 89°42'07" E
2276.62
N 89°29'45" E
360.74
BY GPS–D
543404
N = 105558.2358
E = 612963.4543
N 89°29'44" E
2296.79
N 89°29'44" E
353.35
BY GPS–D
543505
N = 105581.5702
E = 615613.4893
COMPUTED INTERSECT
440308
N = 105541.8751
E = 609921.9577
1" SQUARE PIPE W/CAP LOCATED BY GPS–D AT:
0.08' NORTH OF 440308
N = 105541.9512
E = 609921.9540
BY GPS–D
440207
N = 105555.0612
E = 612602.7281
COMPUTED INTERSECT
440208
N = 105578.4589
E = 615260.1505
CAST IRON MONUMENT LOCATED BY GPS–D AT:
0.06' NORTH OF 440208
N = 105578.5162
E = 615260.1483