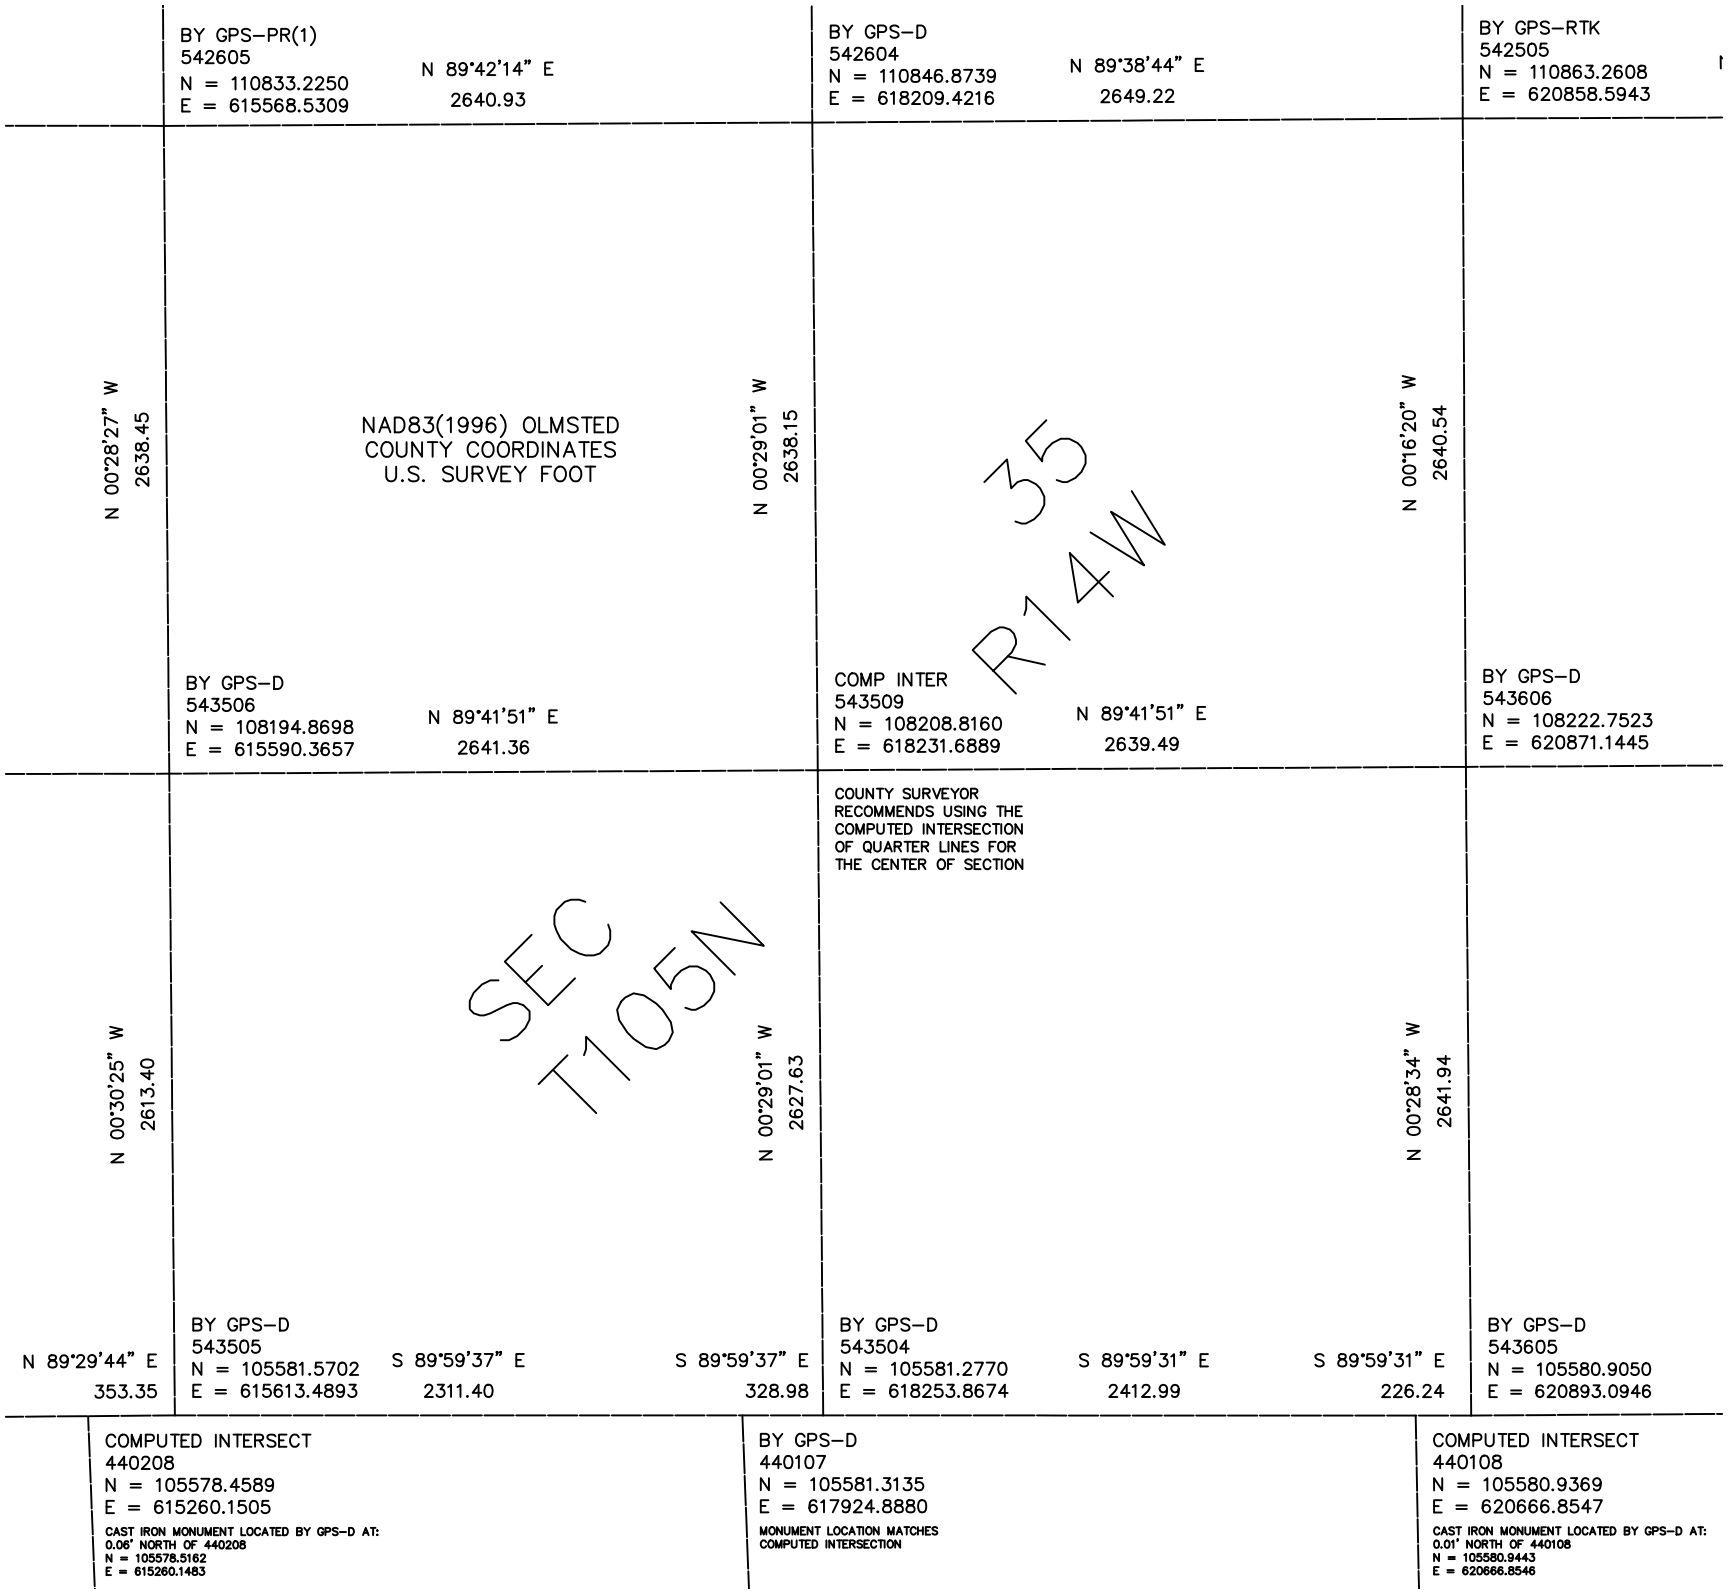

BY GPS–PR(1)
542605
N = 110833.2250
E = 615568.5309
N 89°42'14" E
2640.93
BY GPS–D
542604
N = 110846.8739
E = 618209.4216
N 89°38'44" E
2649.22
BY GPS–RTK
542505
N = 110863.2608
E = 620858.5943
N 00°28'27" W
2638.45
NAD83(1996) OLMSTED
COUNTY COORDINATES
U.S. SURVEY FOOT
N 00°29'01" W
2638.15
35
R14W
N 00°16'20" W
2640.54
BY GPS–D
543506
N = 108194.8698
E = 615590.3657
N 89°41'51" E
2641.36
COMP INTER
543509
N = 108208.8160
E = 618231.6889
N 89°41'51" E
2639.49
BY GPS–D
543606
N = 108222.7523
E = 620871.1445
COUNTY SURVEYOR
RECOMMENDS USING THE
COMPUTED INTERSECTION
OF QUARTER LINES FOR
THE CENTER OF SECTION
N 00°30'25" W
2613.40
SEC
T105N
N 00°29'01" W
2627.63
N 00°28'34" W
2641.94
N 89°29'44" E
353.35
BY GPS–D
543505
N = 105581.5702
E = 615613.4893
S 89°59'37" E
2311.40
S 89°59'37" E
328.98
BY GPS–D
543504
N = 105581.2770
E = 618253.8674
S 89°59'31" E
2412.99
S 89°59'31" E
226.24
BY GPS–D
543605
N = 105580.9050
E = 620893.0946
COMPUTED INTERSECT
440208
N = 105578.4589
E = 615260.1505
CAST IRON MONUMENT LOCATED BY GPS–D AT:
0.06' NORTH OF 440208
N = 105578.5162
E = 615260.1483
BY GPS–D
440107
N = 105581.3135
E = 617924.8880
MONUMENT LOCATION MATCHES
COMPUTED INTERSECTION
COMPUTED INTERSECT
440108
N = 105580.9369
E = 620666.8547
CAST IRON MONUMENT LOCATED BY GPS–D AT:
0.01' NORTH OF 440108
N = 105580.9443
E = 620666.8546