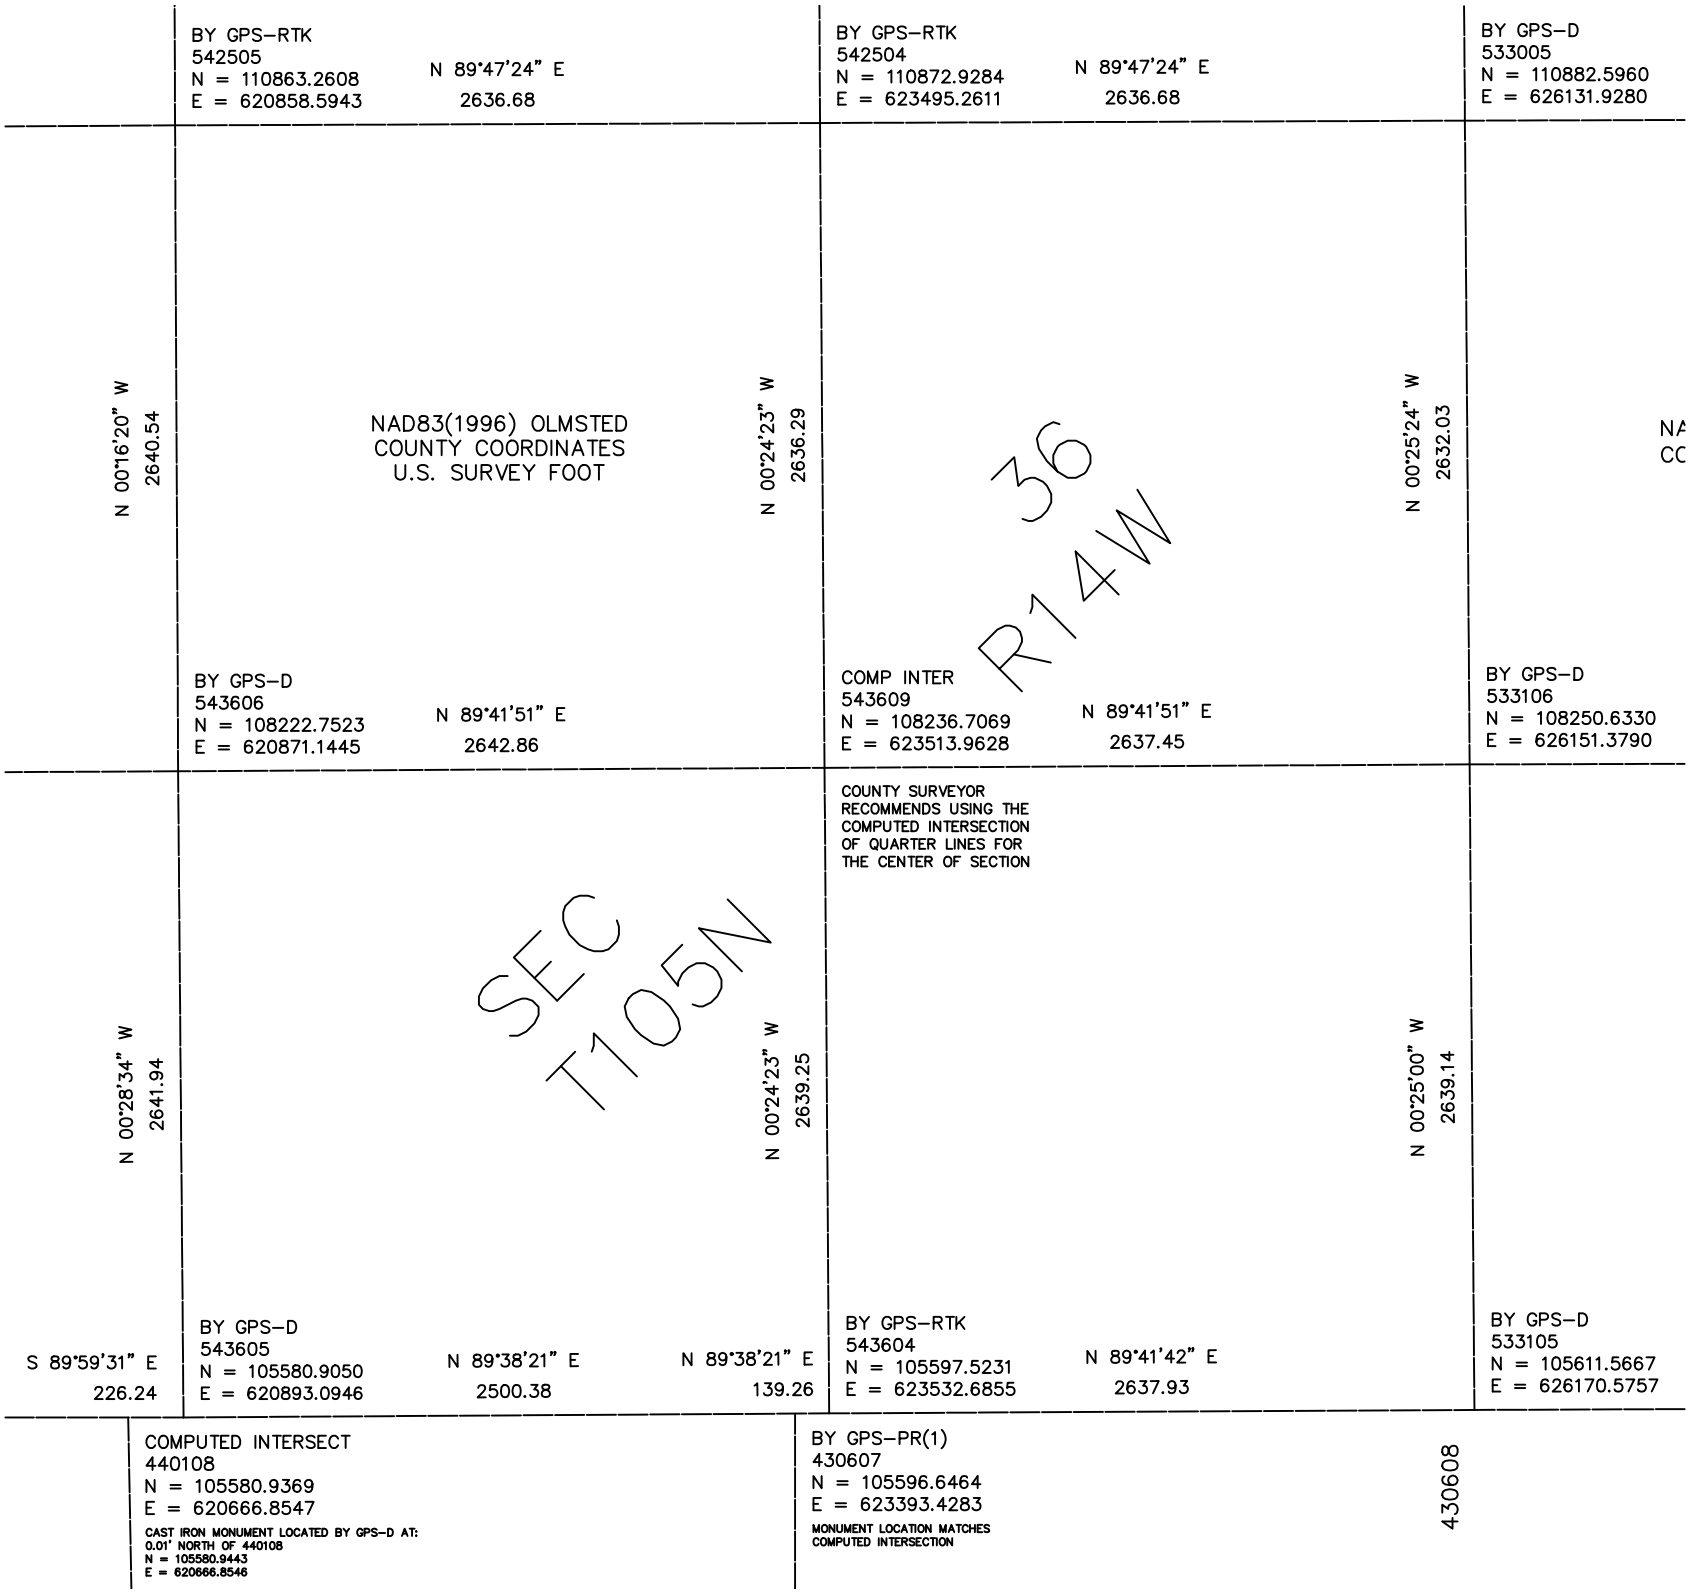

BY GPS–RTK
542505
N = 110863.2608
E = 620858.5943
N 89°47'24" E
2636.68
BY GPS–RTK
542504
N = 110872.9284
E = 623495.2611
N 89°47'24" E
2636.68
BY GPS–D
533005
N = 110882.5960
E = 626131.9280
N 00°16'20" W
2640.54
NAD83(1996) OLMSTED
COUNTY COORDINATES
U.S. SURVEY FOOT
N 00°24'23" W
2636.29
36
R14W
N 00°25'24" W
2632.03
NA
CC
BY GPS–D
543606
N = 108222.7523
E = 620871.1445
N 89°41'51" E
2642.86
COMP INTER
543609
N = 108236.7069
E = 623513.9628
N 89°41'51" E
2637.45
BY GPS–D
533106
N = 108250.6330
E = 626151.3790
COUNTY SURVEYOR
RECOMMENDS USING THE
COMPUTED INTERSECTION
OF QUARTER LINES FOR
THE CENTER OF SECTION
N 00°28'34" W
2641.94
SEC
T105N
N 00°24'23" W
2639.25
N 00°25'00" W
2639.14
S 89°59'31" E
226.24
BY GPS–D
543605
N = 105580.9050
E = 620893.0946
N 89°38'21" E
2500.38
N 89°38'21" E
139.26
BY GPS–RTK
543604
N = 105597.5231
E = 623532.6855
N 89°41'42" E
2637.93
BY GPS–D
533105
N = 105611.5667
E = 626170.5757
COMPUTED INTERSECT
440108
N = 105580.9369
E = 620666.8547
CAST IRON MONUMENT LOCATED BY GPS–D AT:
0.01' NORTH OF 440108
N = 105580.9443
E = 620666.8546
BY GPS–PR(1)
430607
N = 105596.6464
E = 623393.4283
MONUMENT LOCATION MATCHES
COMPUTED INTERSECTION
430608