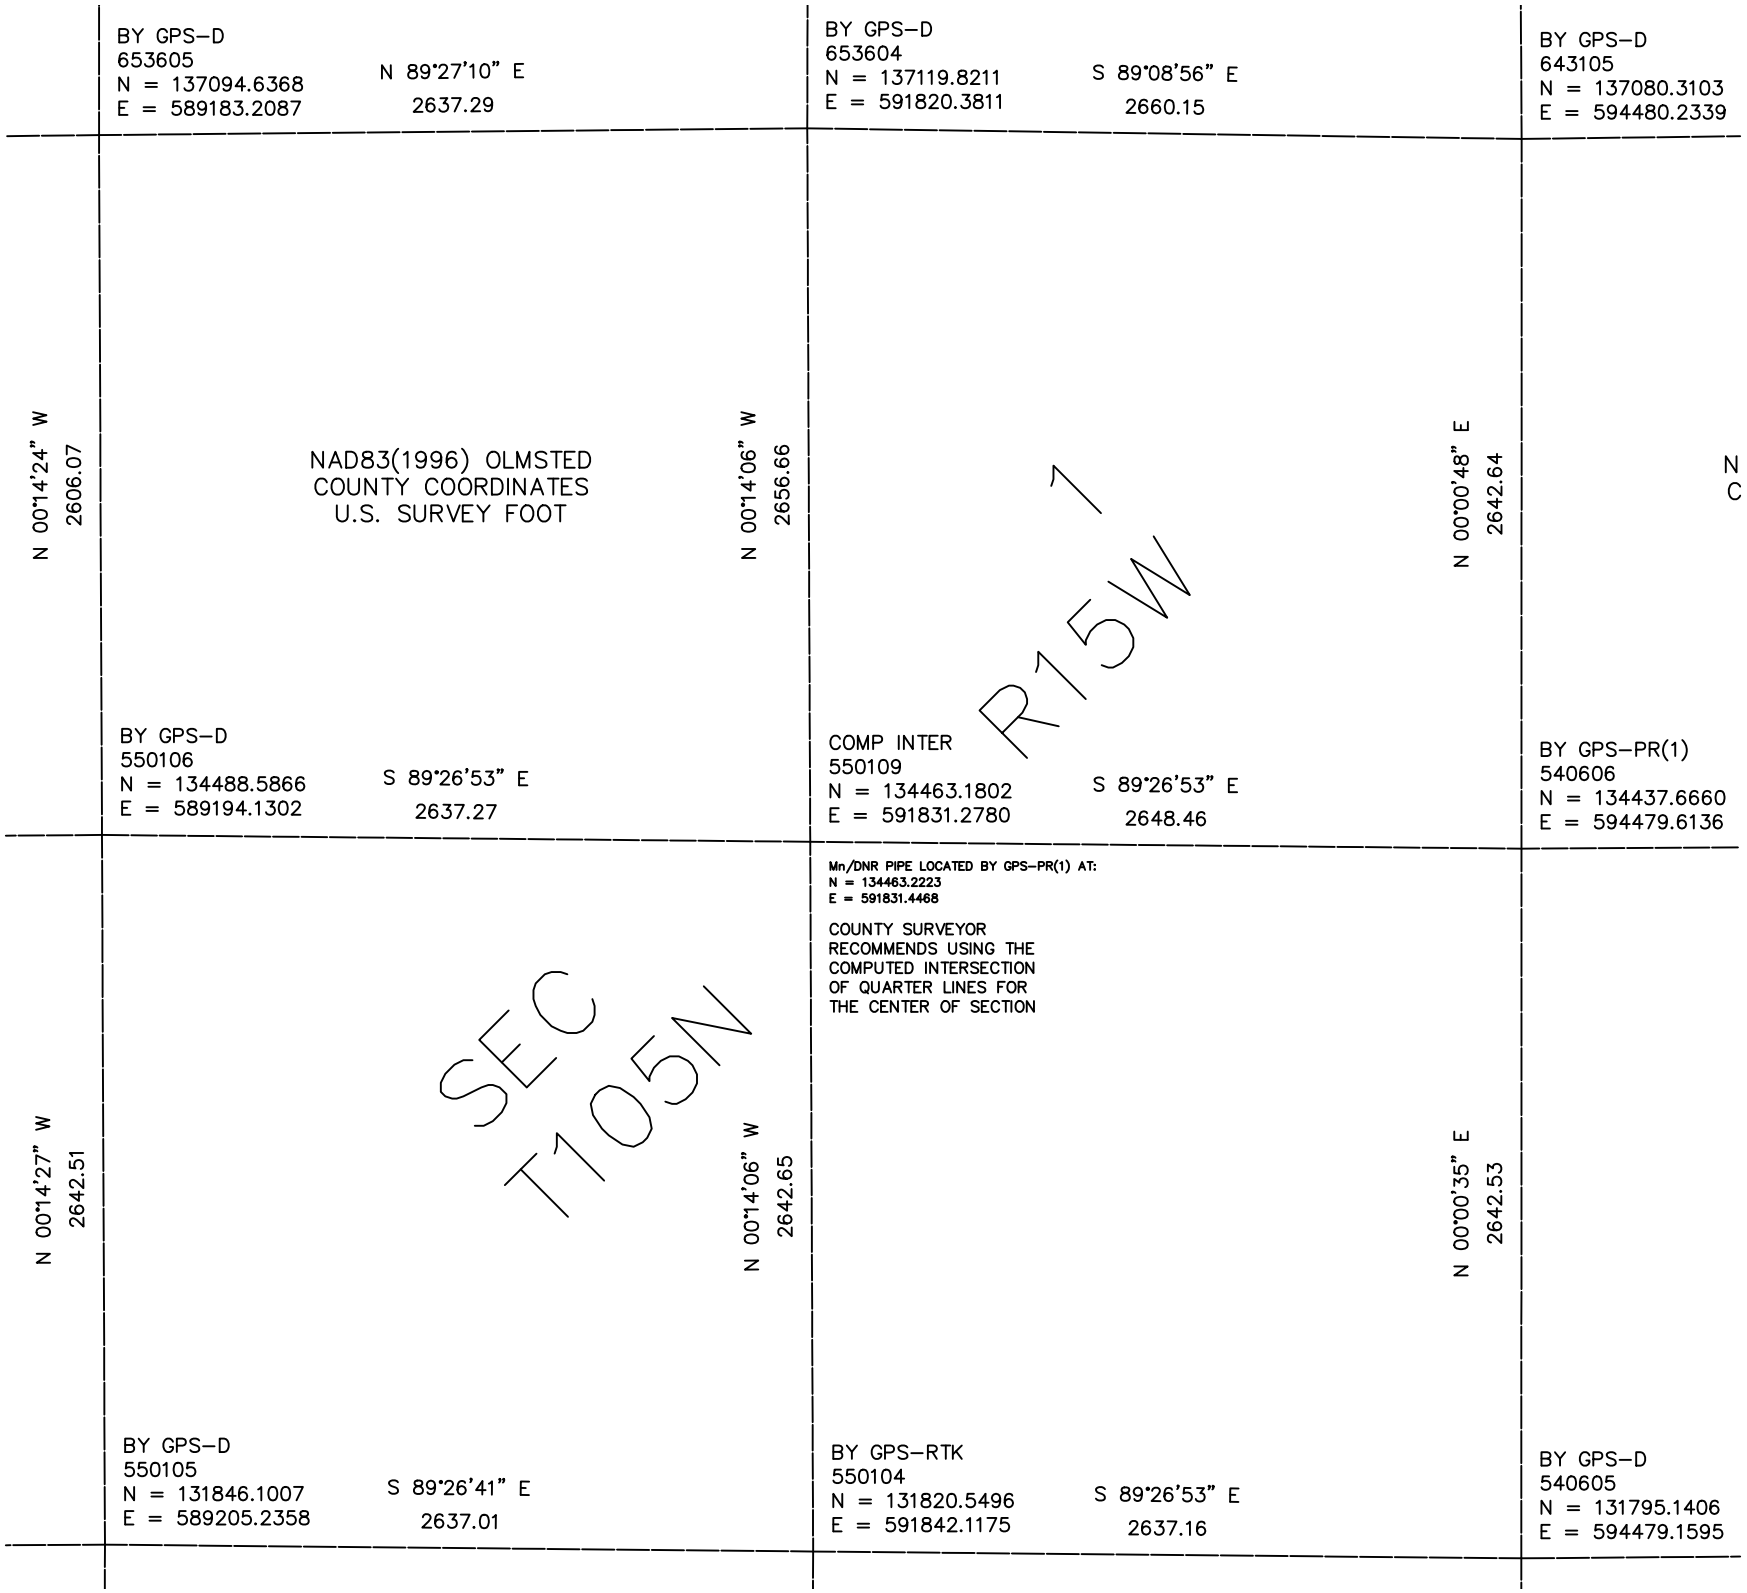

BY GPS–D
653605
N = 137094.6368
E = 589183.2087
N 89°27'10" E
2637.29
BY GPS–D
653604
N = 137119.8211
E = 591820.3811
S 89°08'56" E
2660.15
BY GPS–D
643105
N = 137080.3103
E = 594480.2339
N 00°14'24" W
2606.07
NAD83(1996) OLMSTED
COUNTY COORDINATES
U.S. SURVEY FOOT
N 00°14'06" W
2656.66
R15W
N 00°00'48" E
2642.64
N
C
BY GPS–D
550106
N = 134488.5866
E = 589194.1302
S 89°26'53" E
2637.27
COMP INTER
550109
N = 134463.1802
E = 591831.2780
S 89°26'53" E
2648.46
BY GPS–PR(1)
540606
N = 134437.6660
E = 594479.6136
Mn/DNR PIPE LOCATED BY GPS–PR(1) AT:
N = 134463.2223
E = 591831.4468
COUNTY SURVEYOR
RECOMMENDS USING THE
COMPUTED INTERSECTION
OF QUARTER LINES FOR
THE CENTER OF SECTION
N 00°14'27" W
2642.51
SEC
T105N
N 00°14'06" W
2642.65
N 00°00'35" E
2642.53
BY GPS–D
550105
N = 131846.1007
E = 589205.2358
S 89°26'41" E
2637.01
BY GPS–RTK
550104
N = 131820.5496
E = 591842.1175
S 89°26'53" E
2637.16
BY GPS–D
540605
N = 131795.1406
E = 594479.1595