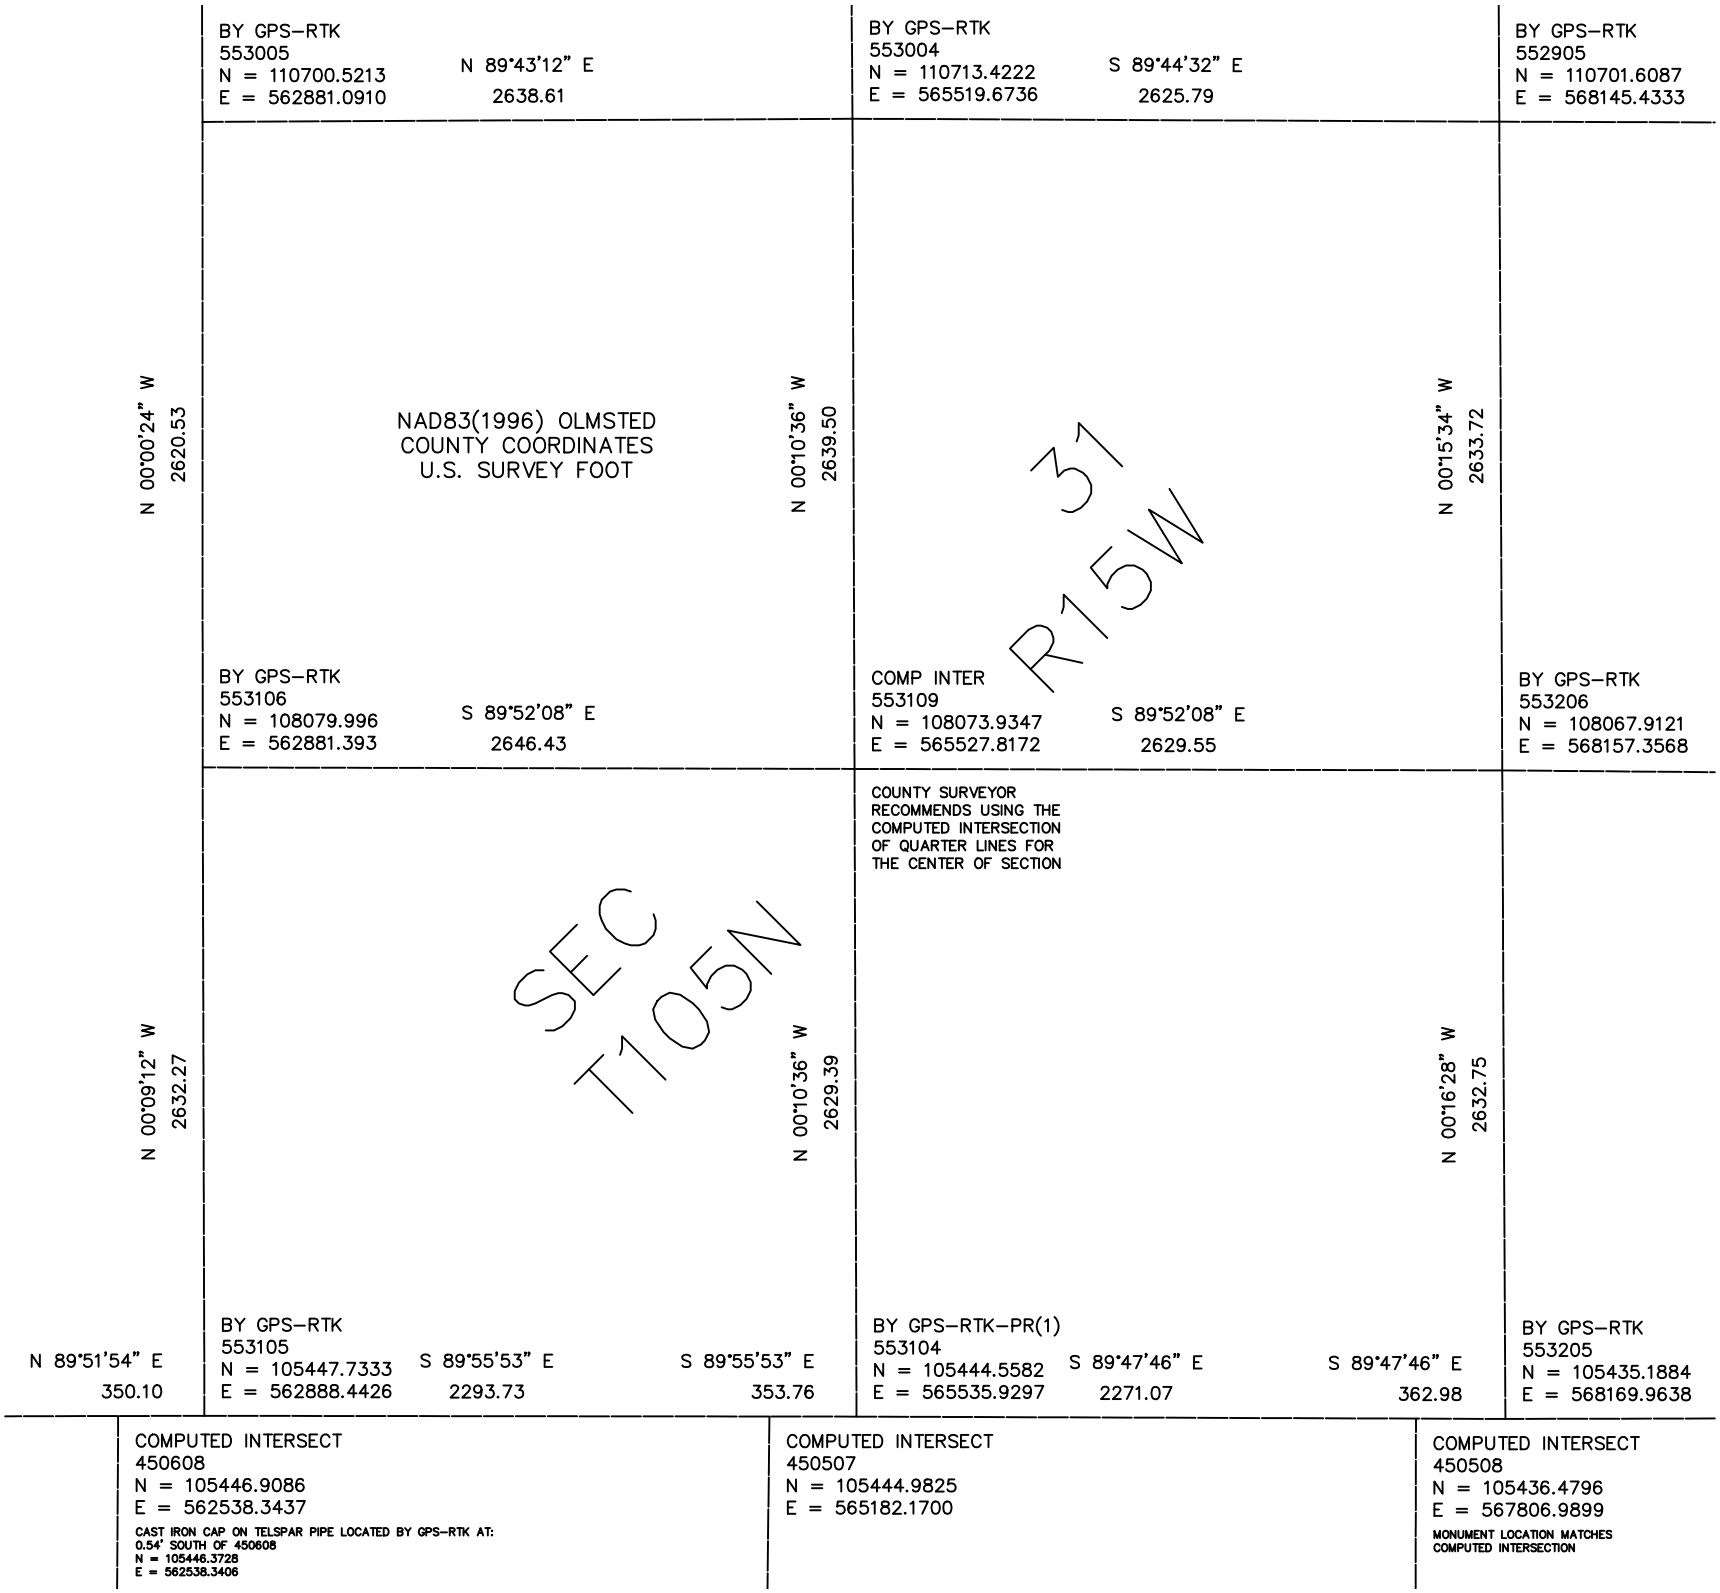

BY GPS–RTK
553005
N = 110700.5213
E = 562881.0910
N 89°43'12" E
2638.61
BY GPS–RTK
553004
N = 110713.4222
E = 565519.6736
S 89°44'32" E
2625.79
BY GPS–RTK
552905
N = 110701.6087
E = 568145.4333
N 00°00'24" W
2620.53
NAD83(1996) OLMSTED
COUNTY COORDINATES
U.S. SURVEY FOOT
N 00°10'36" W
2639.50
N 00°15'34" W
2633.72
31
R15W
BY GPS–RTK
553106
N = 108079.996
E = 562881.393
S 89°52'08" E
2646.43
COMP INTER
553109
N = 108073.9347
E = 565527.8172
S 89°52'08" E
2629.55
BY GPS–RTK
553206
N = 108067.9121
E = 568157.3568
COUNTY SURVEYOR
RECOMMENDS USING THE
COMPUTED INTERSECTION
OF QUARTER LINES FOR
THE CENTER OF SECTION
N 00°09'12" W
2632.27
SEC
T105N
N 00°10'36" W
2629.39
N 00°16'28" W
2632.75
N 89°51'54" E
350.10
BY GPS–RTK
553105
N = 105447.7333
E = 562888.4426
S 89°55'53" E
2293.73
S 89°55'53" E
353.76
BY GPS–RTK–PR(1)
553104
N = 105444.5582
E = 565535.9297
S 89°47'46" E
2271.07
S 89°47'46" E
362.98
BY GPS–RTK
553205
N = 105435.1884
E = 568169.9638
COMPUTED INTERSECT
450608
N = 105446.9086
E = 562538.3437
CAST IRON CAP ON TELSPAR PIPE LOCATED BY GPS–RTK AT:
0.54' SOUTH OF 450608
N = 105446.3728
E = 562538.3406
COMPUTED INTERSECT
450507
N = 105444.9825
E = 565182.1700
COMPUTED INTERSECT
450508
N = 105436.4796
E = 567806.9899
MONUMENT LOCATION MATCHES
COMPUTED INTERSECTION