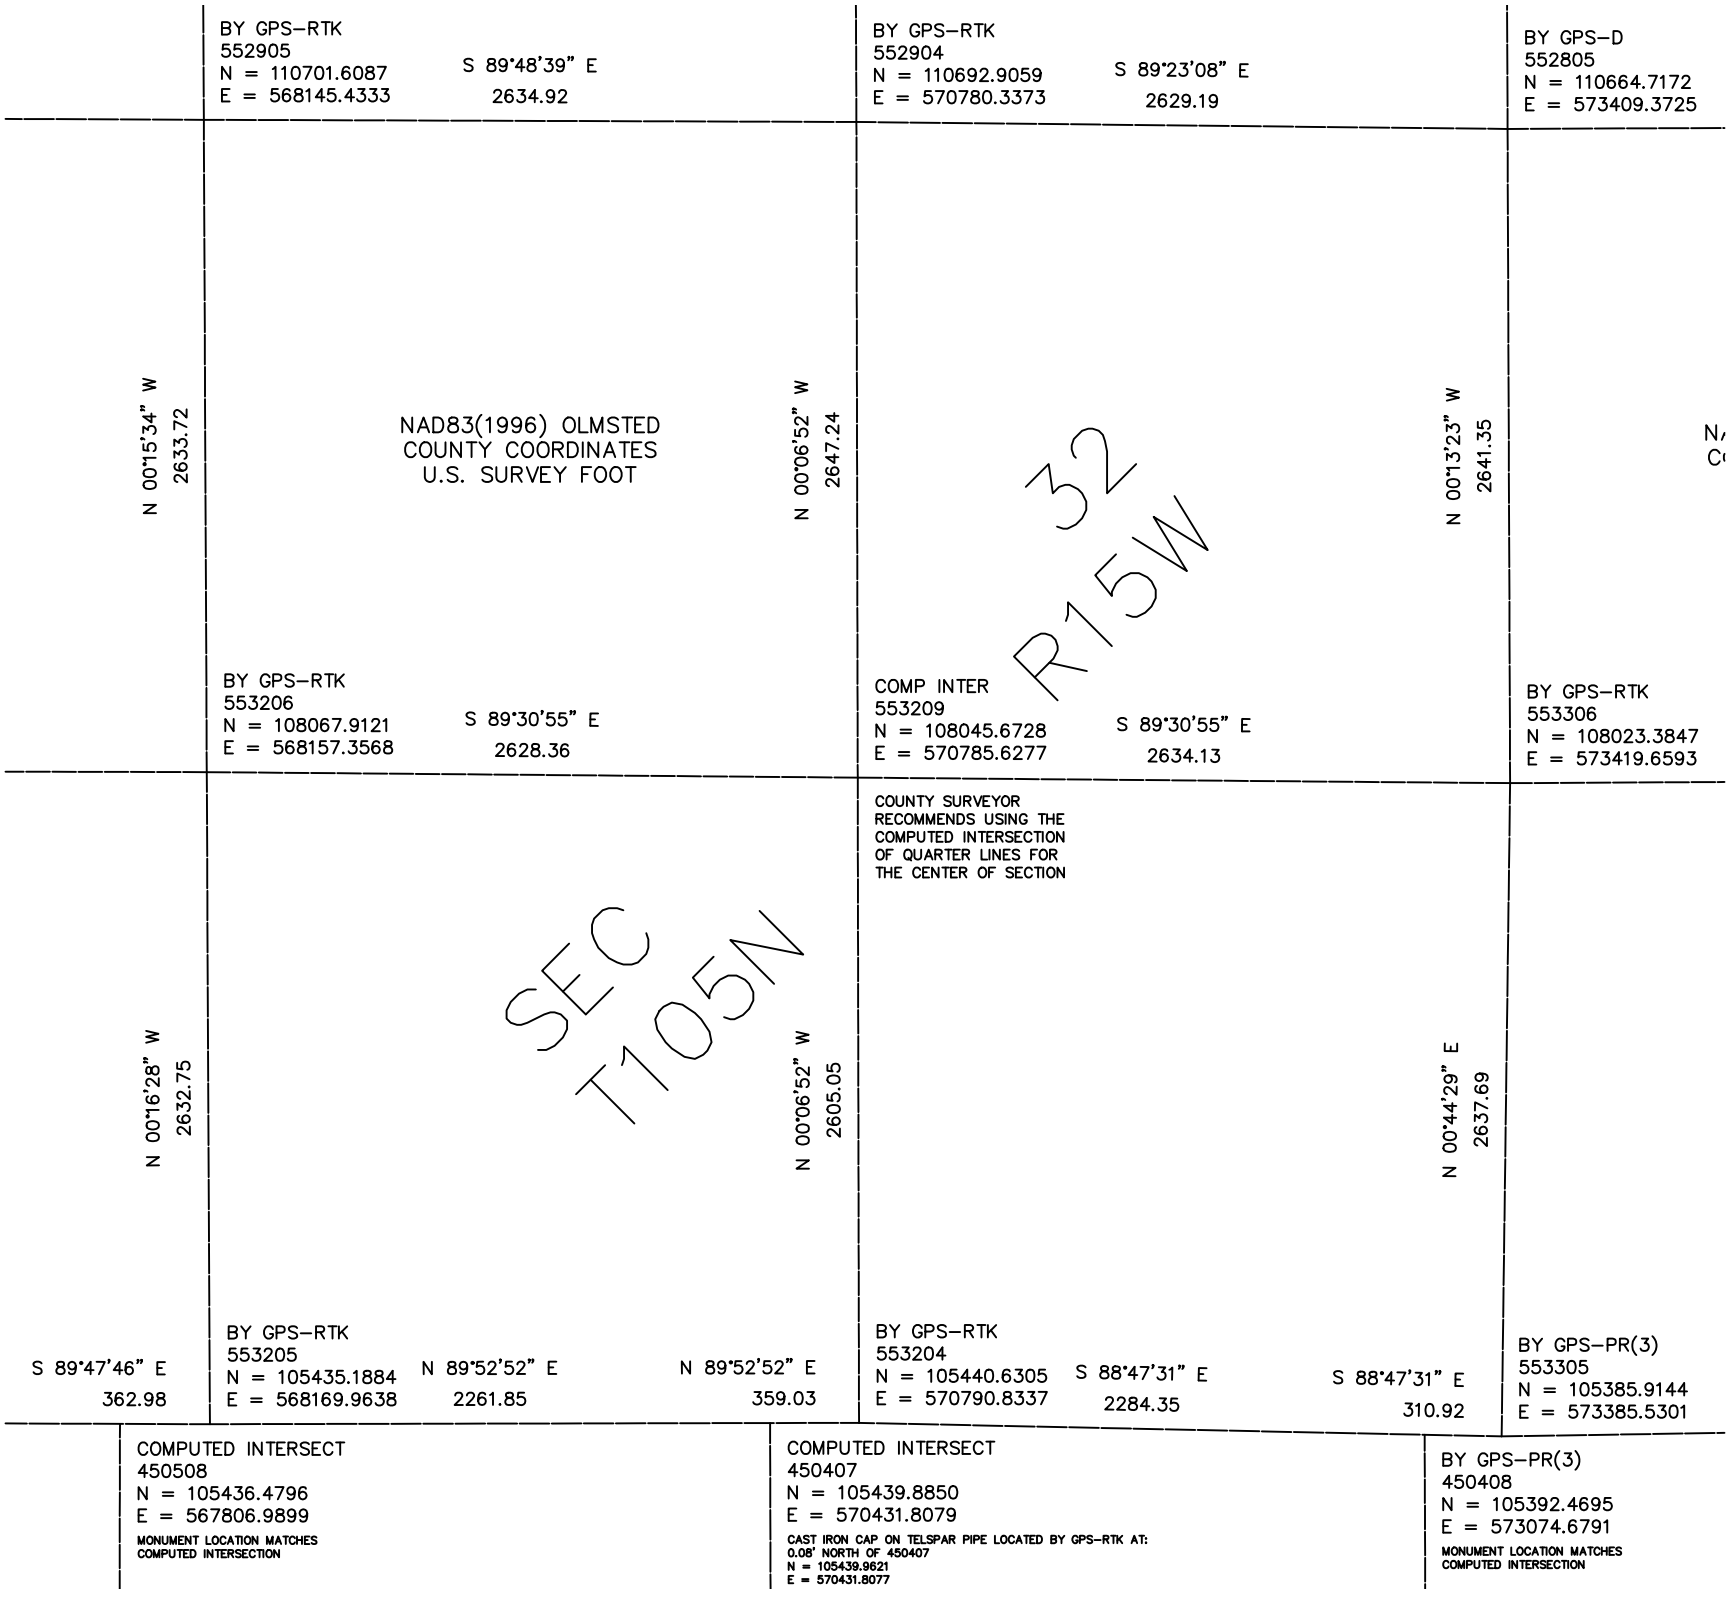

BY GPS–RTK
552905
N = 110701.6087
E = 568145.4333
S 89°48'39" E
2634.92
BY GPS–RTK
552904
N = 110692.9059
E = 570780.3373
S 89°23'08" E
2629.19
BY GPS–D
552805
N = 110664.7172
E = 573409.3725
N 00°15'34" W
2633.72
NAD83(1996) OLMSTED
COUNTY COORDINATES
U.S. SURVEY FOOT
N 00°06'52" W
2647.24
N 00°13'23" W
2641.35
32
R15W
BY GPS–RTK
553206
N = 108067.9121
E = 568157.3568
S 89°30'55" E
2628.36
COMP INTER
553209
N = 108045.6728
E = 570785.6277
S 89°30'55" E
2634.13
BY GPS–RTK
553306
N = 108023.3847
E = 573419.6593
COUNTY SURVEYOR
RECOMMENDS USING THE
COMPUTED INTERSECTION
OF QUARTER LINES FOR
THE CENTER OF SECTION
N 00°16'28" W
2632.75
SEC
T105N
N 00°06'52" W
2605.05
N 00°44'29" E
2637.69
S 89°47'46" E
362.98
BY GPS–RTK
553205
N = 105435.1884
E = 568169.9638
N 89°52'52" E
2261.85
N 89°52'52" E
359.03
BY GPS–RTK
553204
N = 105440.6305
E = 570790.8337
S 88°47'31" E
2284.35
S 88°47'31" E
310.92
BY GPS–PR(3)
553305
N = 105385.9144
E = 573385.5301
COMPUTED INTERSECT
450508
N = 105436.4796
E = 567806.9899
MONUMENT LOCATION MATCHES
COMPUTED INTERSECTION
COMPUTED INTERSECT
450407
N = 105439.8850
E = 570431.8079
CAST IRON CAP ON TELSPAR PIPE LOCATED BY GPS–RTK AT:
0.08' NORTH OF 450407
N = 105439.9621
E = 570431.8077
BY GPS–PR(3)
450408
N = 105392.4695
E = 573074.6791
MONUMENT LOCATION MATCHES
COMPUTED INTERSECTION