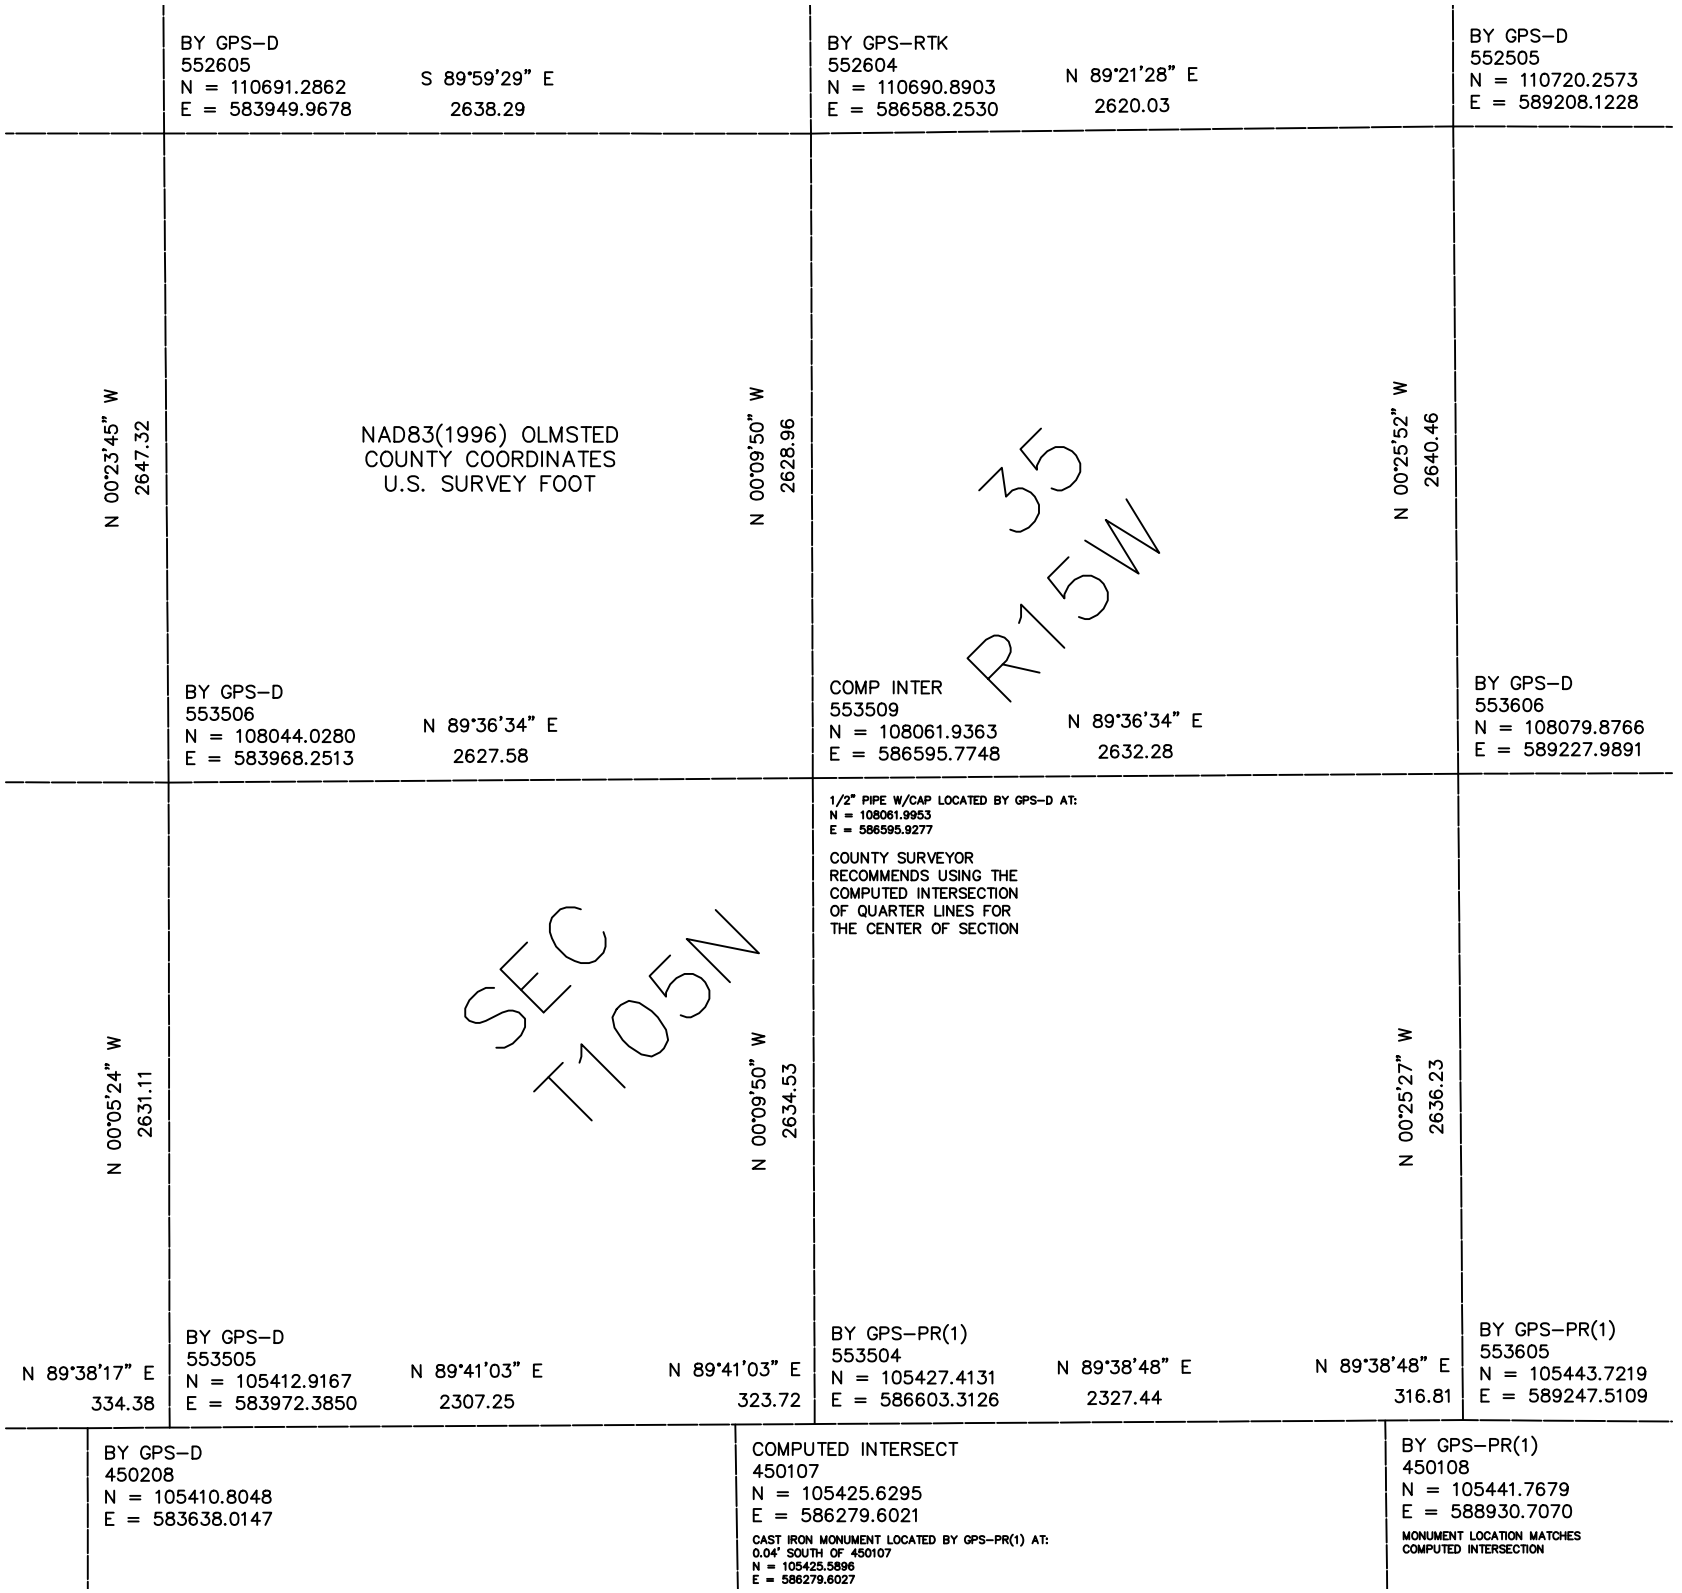

BY GPS–D
552605
N = 110691.2862
E = 583949.9678
S 89°59'29" E
2638.29
BY GPS–RTK
552604
N = 110690.8903
E = 586588.2530
N 89°21'28" E
2620.03
BY GPS–D
552505
N = 110720.2573
E = 589208.1228
N 00°23'45" W
2647.32
NAD83(1996) OLMSTED
COUNTY COORDINATES
U.S. SURVEY FOOT
N 00°09'50" W
2628.96
35
R15W
N 00°25'52" W
2640.46
BY GPS–D
553506
N = 108044.0280
E = 583968.2513
N 89°36'34" E
2627.58
COMP INTER
553509
N = 108061.9363
E = 586595.7748
N 89°36'34" E
2632.28
BY GPS–D
553606
N = 108079.8766
E = 589227.9891
1/2" PIPE W/CAP LOCATED BY GPS–D AT:
N = 108061.9953
E = 586595.9277
COUNTY SURVEYOR
RECOMMENDS USING THE
COMPUTED INTERSECTION
OF QUARTER LINES FOR
THE CENTER OF SECTION
N 00°05'24" W
2631.11
SEC
T105N
N 00°09'50" W
2634.53
N 00°25'27" W
2636.23
N 89°38'17" E
334.38
BY GPS–D
553505
N = 105412.9167
E = 583972.3850
N 89°41'03" E
2307.25
N 89°41'03" E
323.72
BY GPS–PR(1)
553504
N = 105427.4131
E = 586603.3126
N 89°38'48" E
2327.44
N 89°38'48" E
316.81
BY GPS–PR(1)
553605
N = 105443.7219
E = 589247.5109
BY GPS–D
450208
N = 105410.8048
E = 583638.0147
COMPUTED INTERSECT
450107
N = 105425.6295
E = 586279.6021
CAST IRON MONUMENT LOCATED BY GPS–PR(1) AT:
0.04' SOUTH OF 450107
N = 105425.5896
E = 586279.6027
BY GPS–PR(1)
450108
N = 105441.7679
E = 588930.7070
MONUMENT LOCATION MATCHES
COMPUTED INTERSECTION