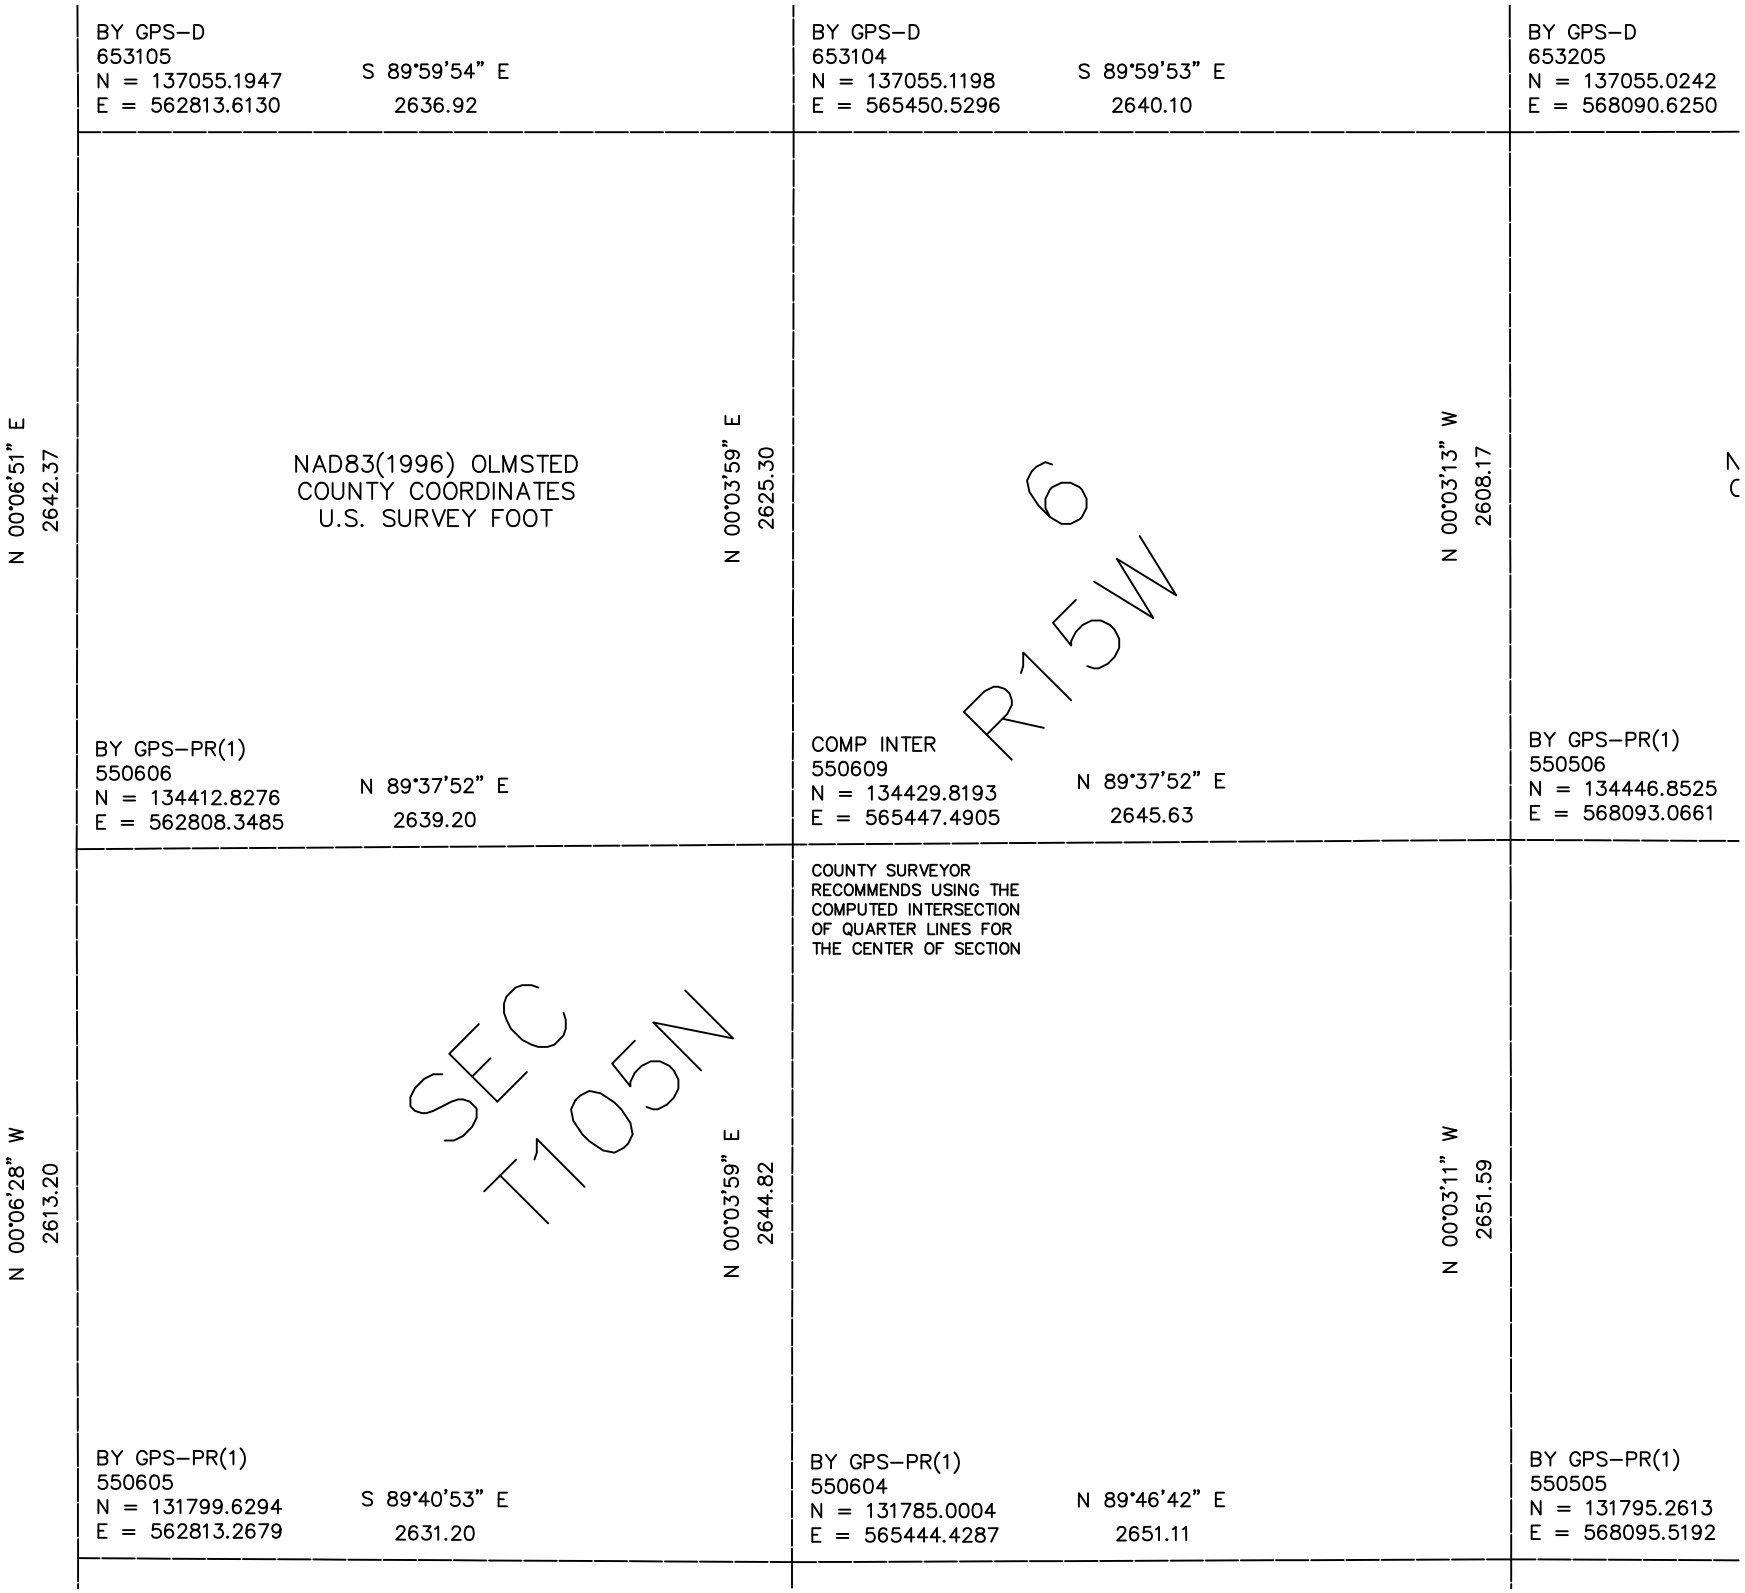

BY GPS–D
653105
N = 137055.1947
E = 562813.6130
S 89°59'54" E
2636.92
BY GPS–D
653104
N = 137055.1198
E = 565450.5296
S 89°59'53" E
2640.10
BY GPS–D
653205
N = 137055.0242
E = 568090.6250
N 00°06'51" E
2642.37
NAD83(1996) OLMSTED
COUNTY COORDINATES
U.S. SURVEY FOOT
N 00°03'59" E
2625.30
N 00°03'13" W
2608.17
6
R15W
BY GPS–PR(1)
550606
N = 134412.8276
E = 562808.3485
N 89°37'52" E
2639.20
COMP INTER
550609
N = 134429.8193
E = 565447.4905
N 89°37'52" E
2645.63
BY GPS–PR(1)
550506
N = 134446.8525
E = 568093.0661
COUNTY SURVEYOR
RECOMMENDS USING THE
COMPUTED INTERSECTION
OF QUARTER LINES FOR
THE CENTER OF SECTION
N 00°06'28" W
2613.20
SEC
T105N
N 00°03'59" E
2644.82
N 00°03'11" W
2651.59
BY GPS–PR(1)
550605
N = 131799.6294
E = 562813.2679
S 89°40'53" E
2631.20
BY GPS–PR(1)
550604
N = 131785.0004
E = 565444.4287
N 89°46'42" E
2651.11
BY GPS–PR(1)
550505
N = 131795.2613
E = 568095.5192