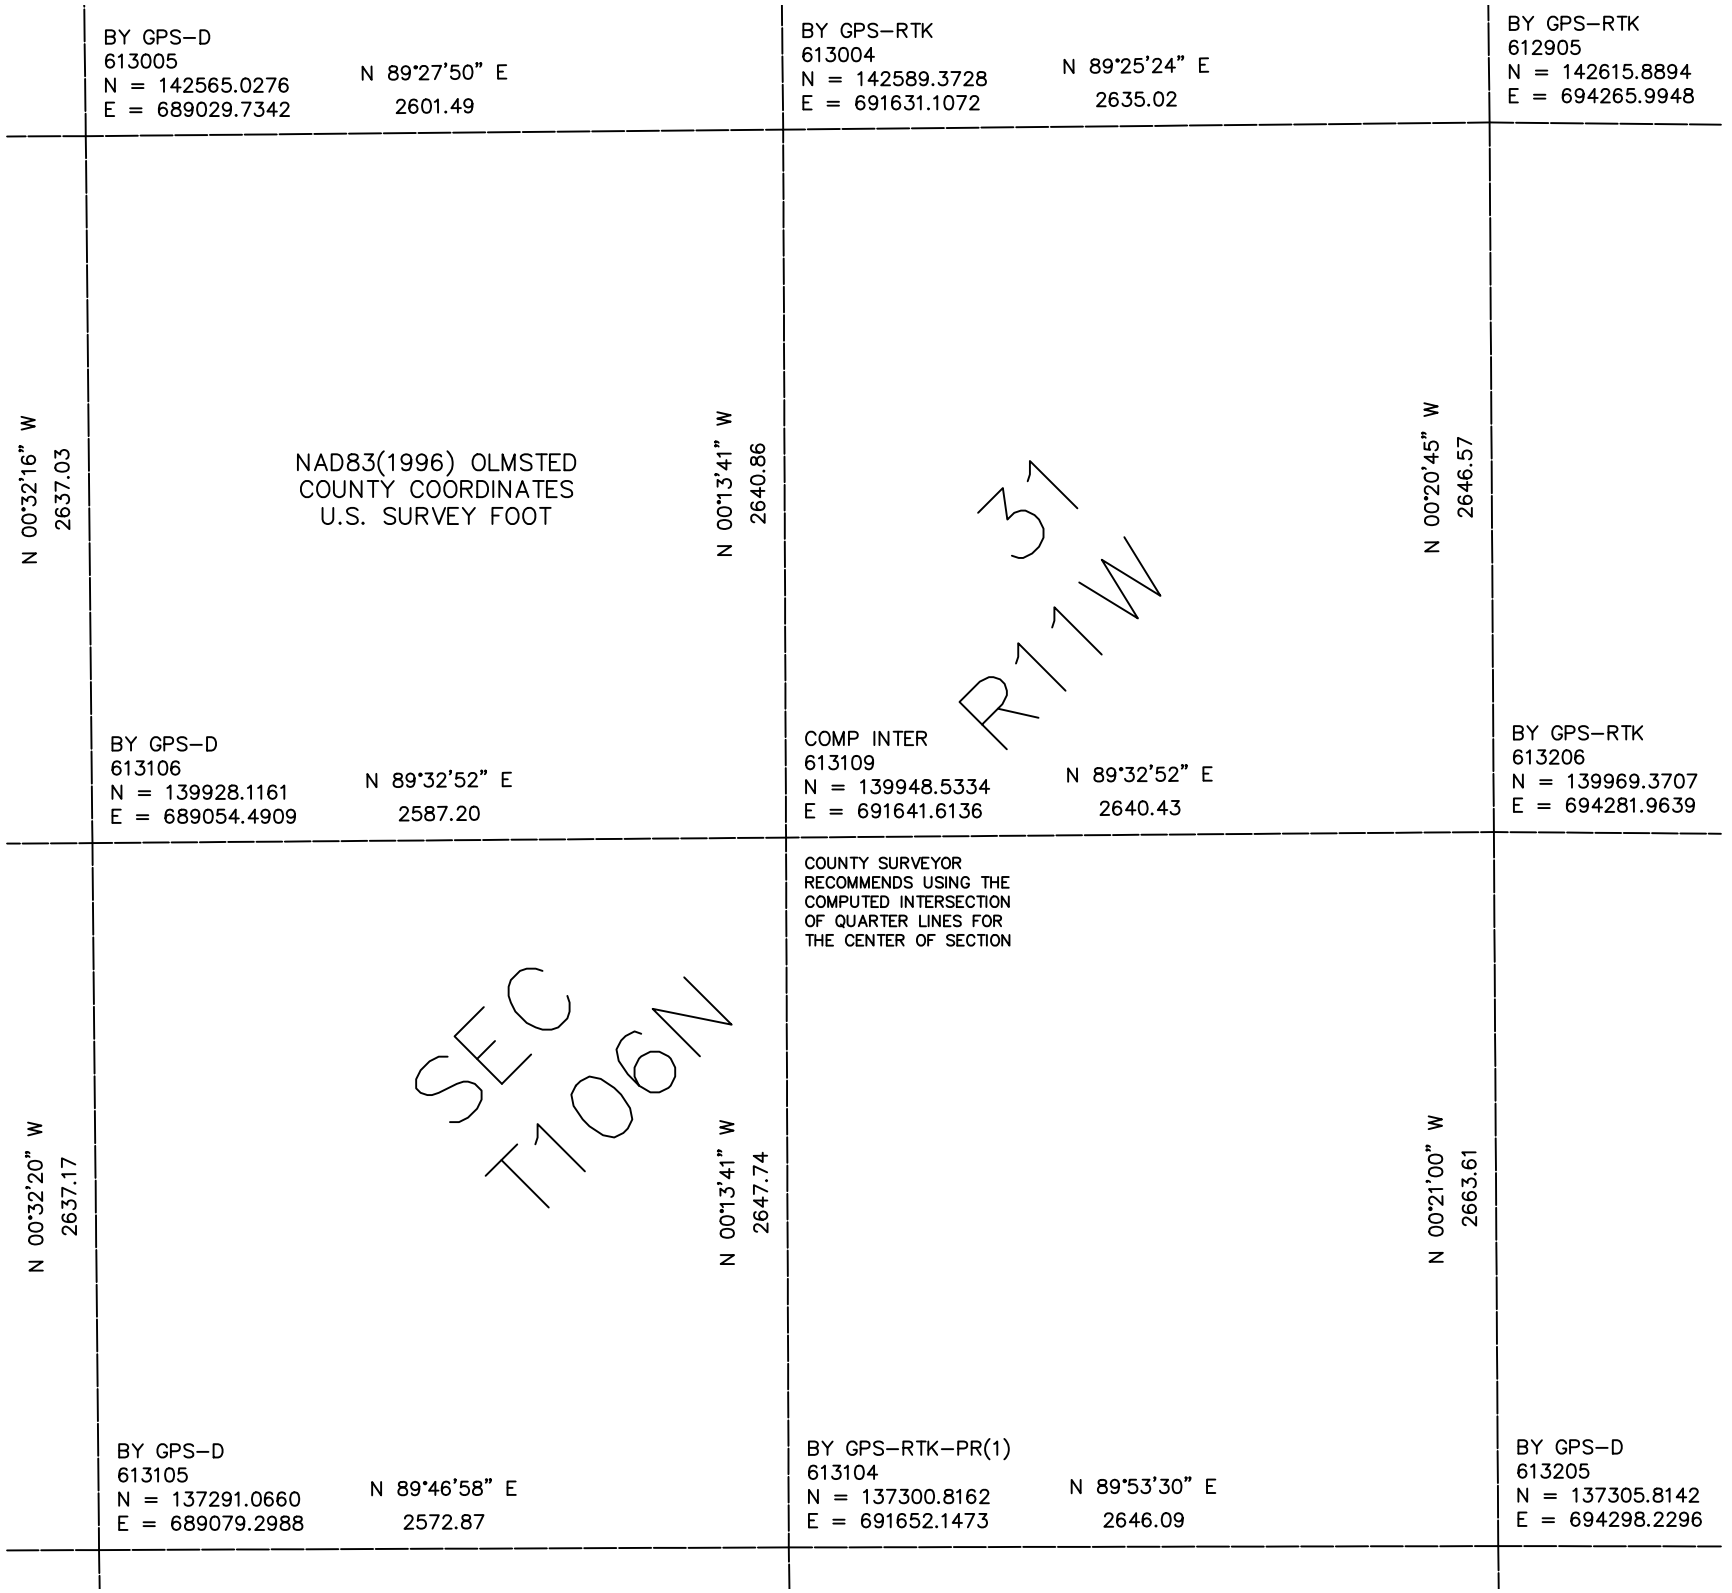

BY GPS–D
613005
N = 142565.0276
E = 689029.7342
N 89°27'50" E
2601.49
BY GPS–RTK
613004
N = 142589.3728
E = 691631.1072
N 89°25'24" E
2635.02
BY GPS–RTK
612905
N = 142615.8894
E = 694265.9948
N 00°32'16" W
2637.03
NAD83(1996) OLMSTED
COUNTY COORDINATES
U.S. SURVEY FOOT
N 00°13'41" W
2640.86
31
R11W
N 00°20'45" W
2646.57
BY GPS–D
613106
N = 139928.1161
E = 689054.4909
N 89°32'52" E
2587.20
COMP INTER
613109
N = 139948.5334
E = 691641.6136
N 89°32'52" E
2640.43
BY GPS–RTK
613206
N = 139969.3707
E = 694281.9639
COUNTY SURVEYOR
RECOMMENDS USING THE
COMPUTED INTERSECTION
OF QUARTER LINES FOR
THE CENTER OF SECTION
N 00°32'20" W
2637.17
SEC
T106N
N 00°13'41" W
2647.74
N 00°21'00" W
2663.61
BY GPS–D
613105
N = 137291.0660
E = 689079.2988
N 89°46'58" E
2572.87
BY GPS–RTK–PR(1)
613104
N = 137300.8162
E = 691652.1473
N 89°53'30" E
2646.09
BY GPS–D
613205
N = 137305.8142
E = 694298.2296