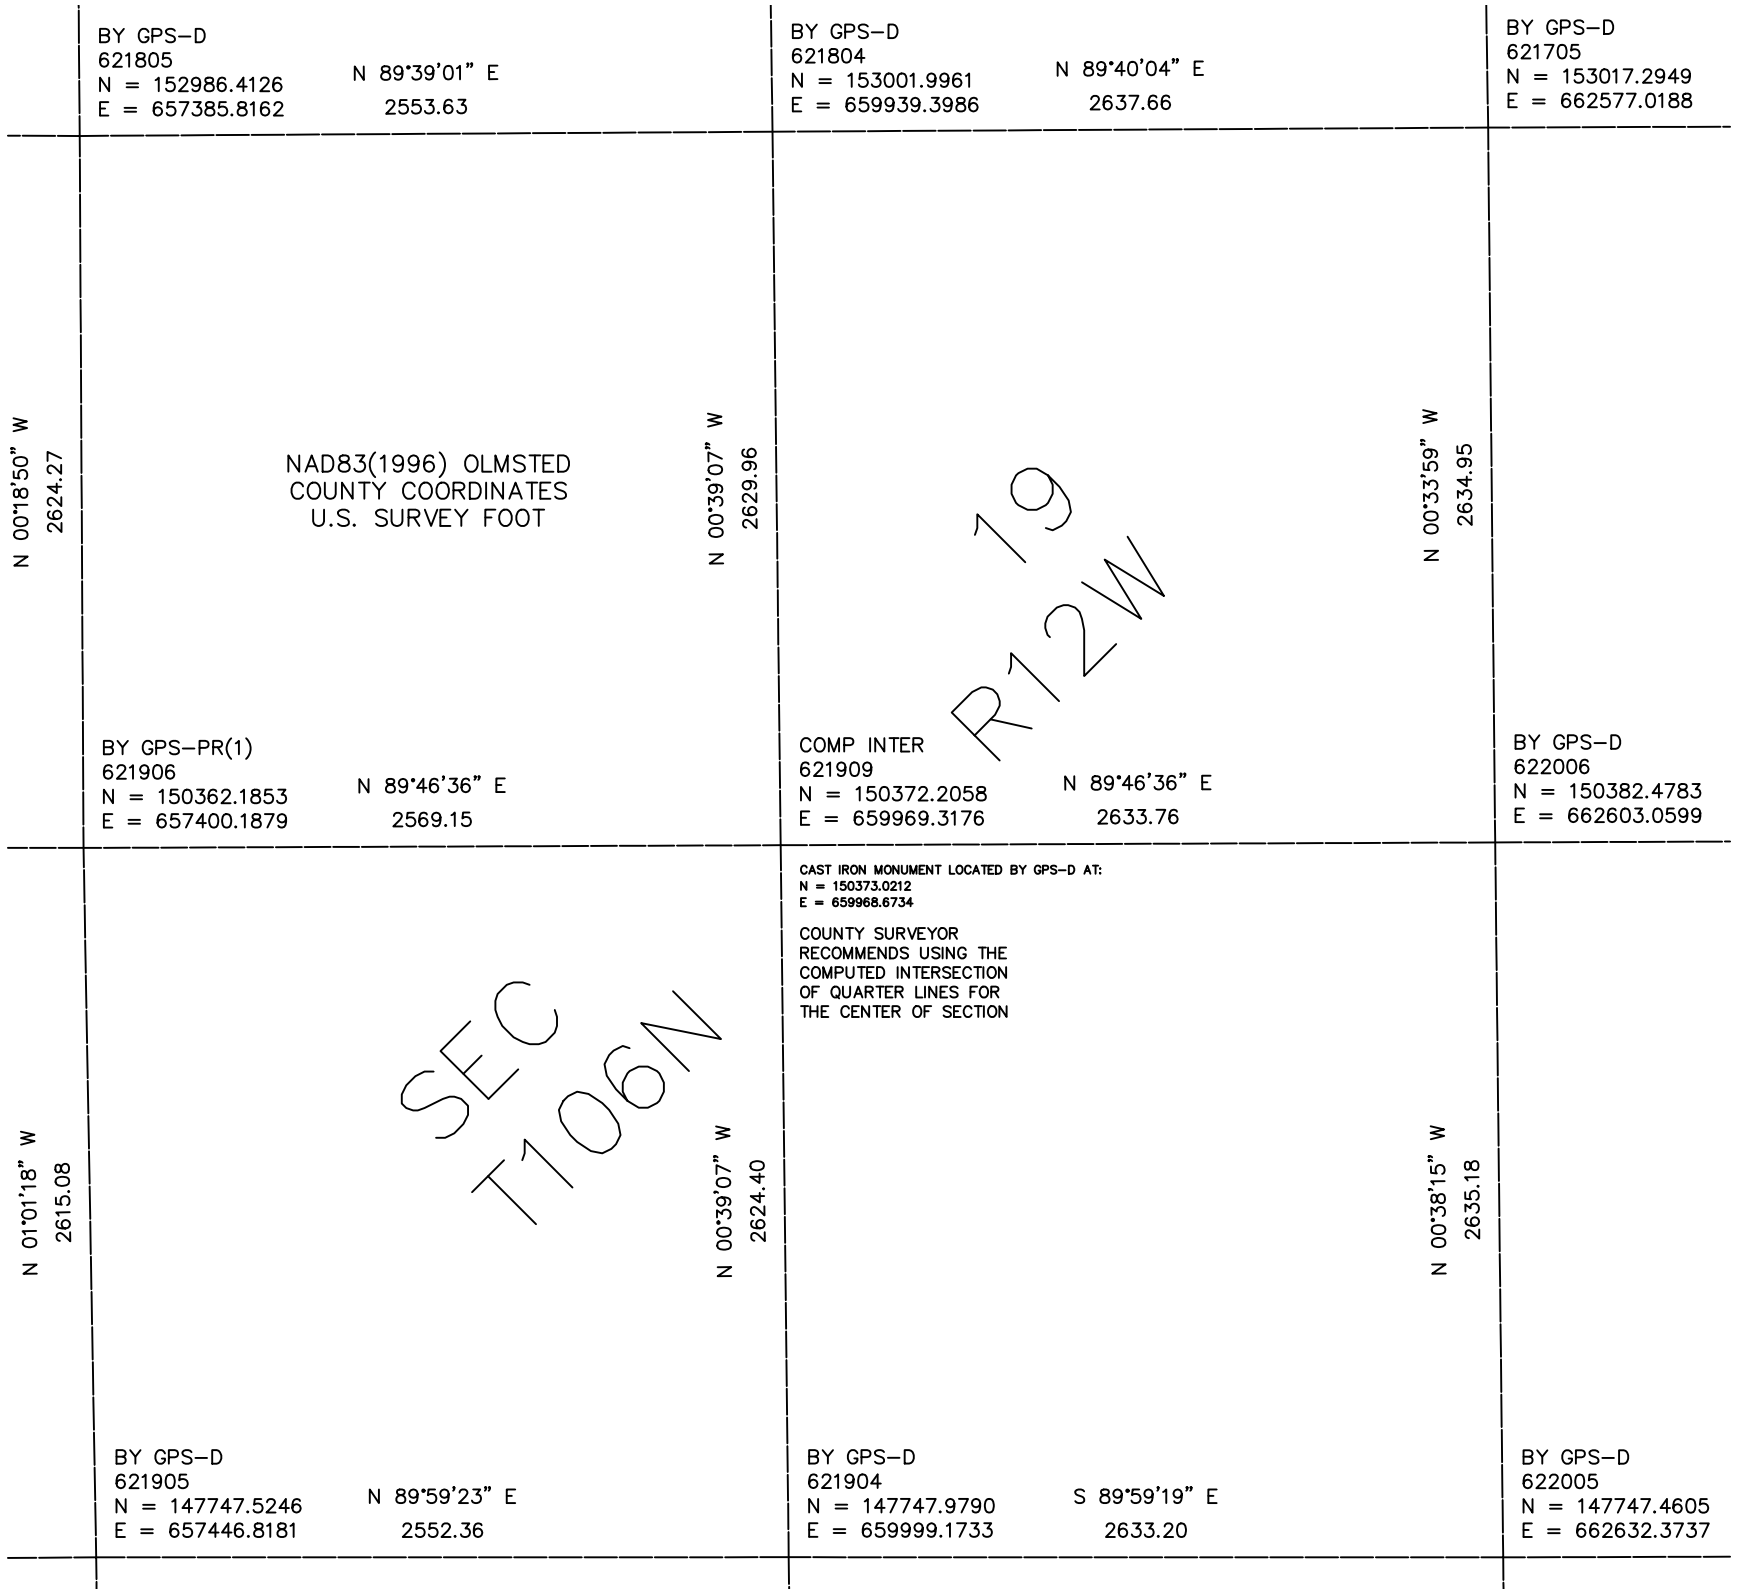

BY GPS–D
621805
N = 152986.4126
E = 657385.8162
N 89°39'01" E
2553.63
BY GPS–D
621804
N = 153001.9961
E = 659939.3986
N 89°40'04" E
2637.66
BY GPS–D
621705
N = 153017.2949
E = 662577.0188
N 00°18'50" W
2624.27
NAD83(1996) OLMSTED
COUNTY COORDINATES
U.S. SURVEY FOOT
N 00°39'07" W
2629.96
19
R12W
N 00°33'59" W
2634.95
BY GPS–PR(1)
621906
N = 150362.1853
E = 657400.1879
N 89°46'36" E
2569.15
COMP INTER
621909
N = 150372.2058
E = 659969.3176
N 89°46'36" E
2633.76
BY GPS–D
622006
N = 150382.4783
E = 662603.0599
CAST IRON MONUMENT LOCATED BY GPS–D AT:
N = 150373.0212
E = 659968.6734
COUNTY SURVEYOR
RECOMMENDS USING THE
COMPUTED INTERSECTION
OF QUARTER LINES FOR
THE CENTER OF SECTION
N 01°01'18" W
2615.08
SEC
T106N
N 00°39'07" W
2624.40
N 00°38'15" W
2635.18
BY GPS–D
621905
N = 147747.5246
E = 657446.8181
N 89°59'23" E
2552.36
BY GPS–D
621904
N = 147747.9790
E = 659999.1733
S 89°59'19" E
2633.20
BY GPS–D
622005
N = 147747.4605
E = 662632.3737