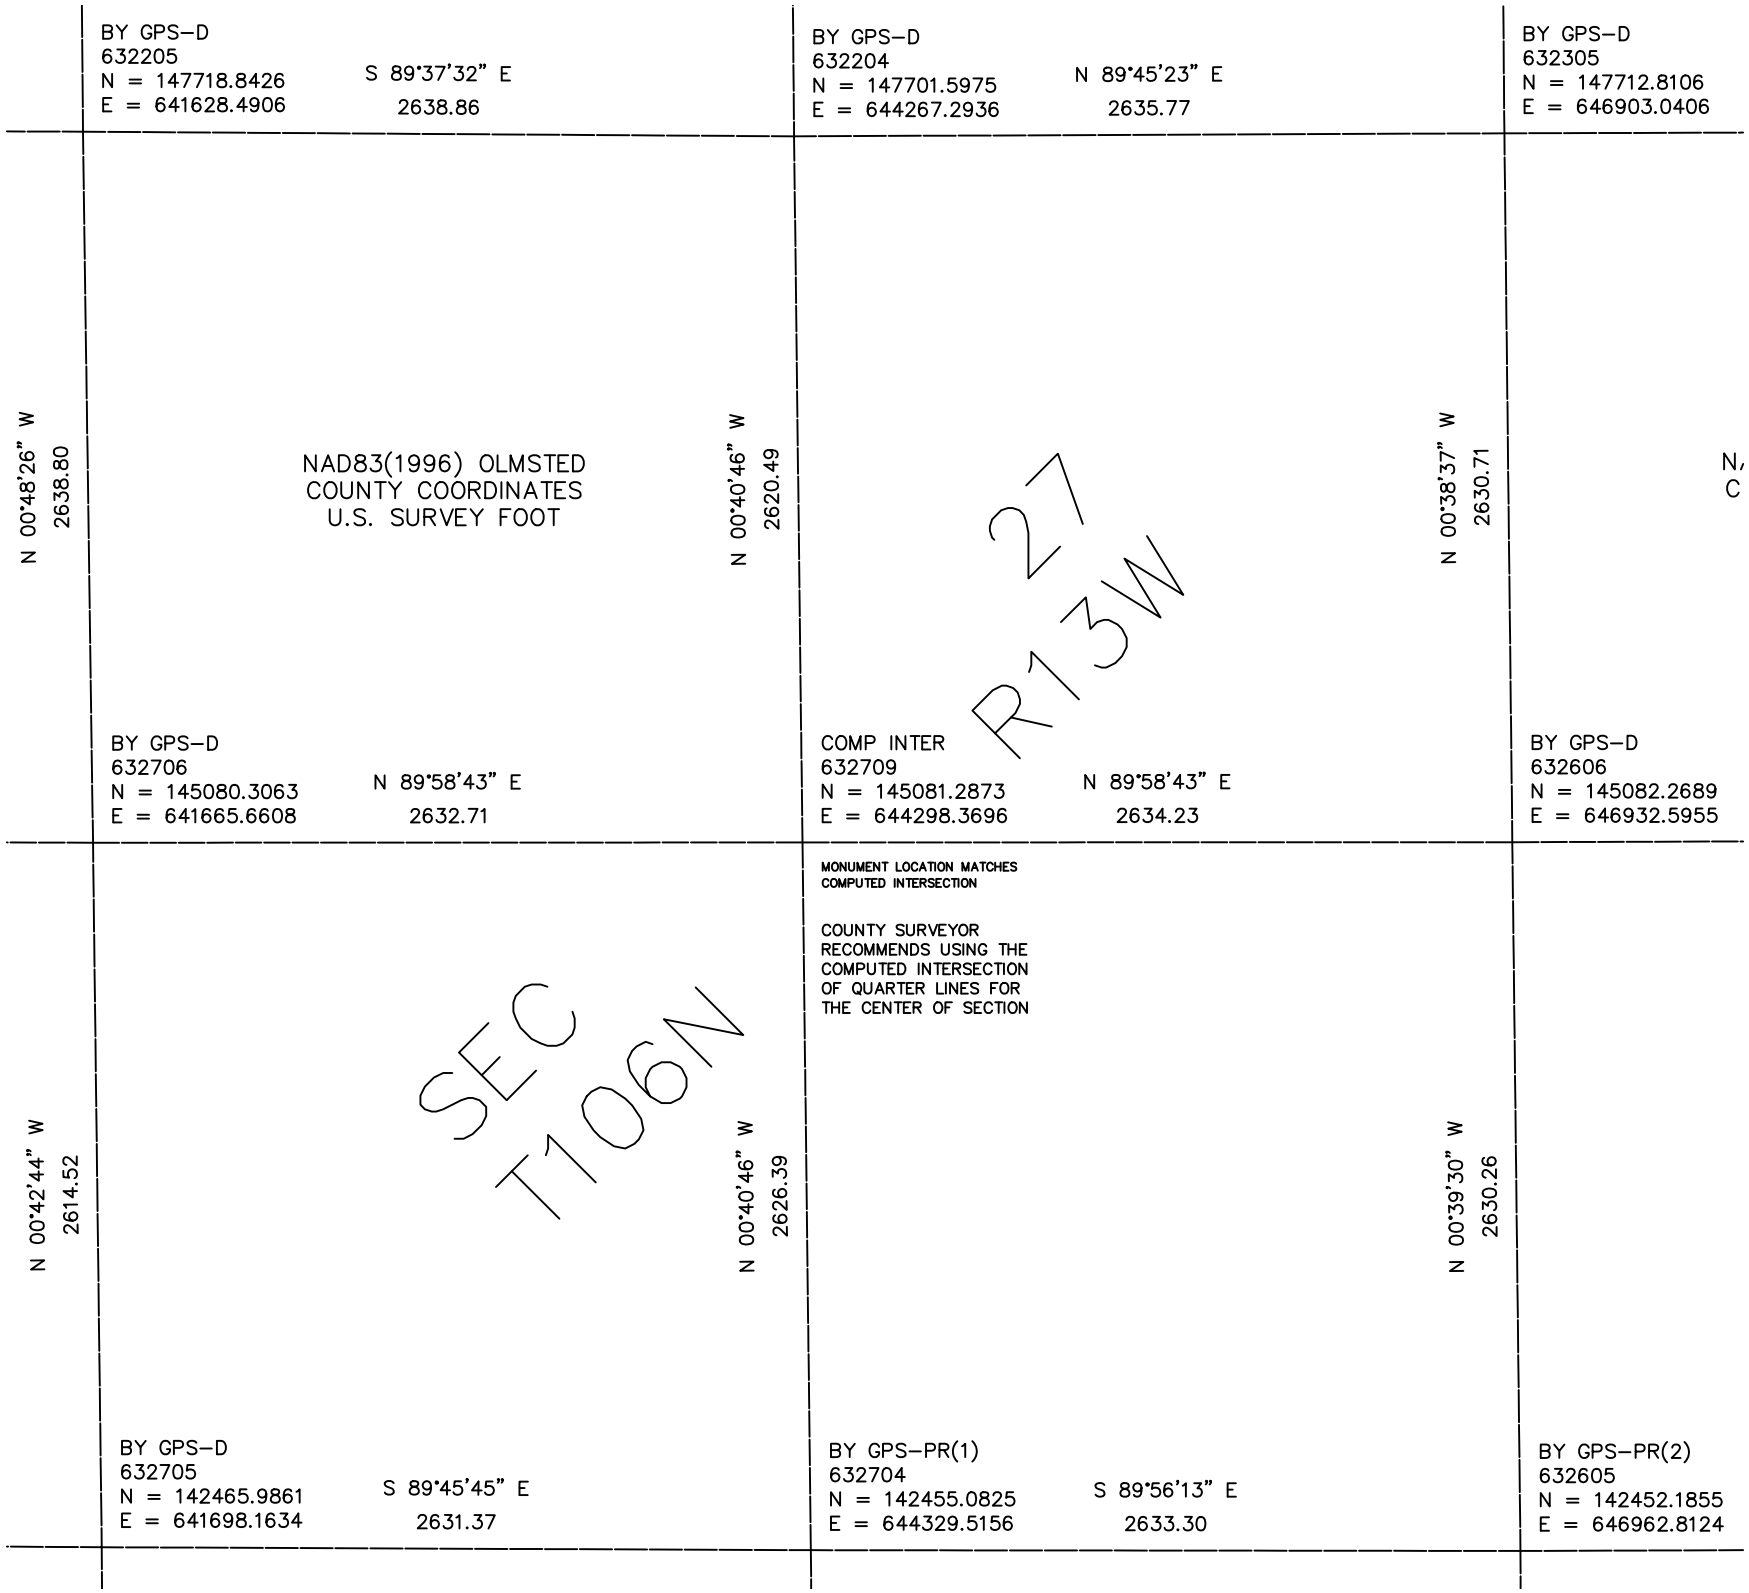

BY GPS–D
632205
N = 147718.8426
E = 641628.4906
S 89°37'32" E
2638.86
BY GPS–D
632204
N = 147701.5975
E = 644267.2936
N 89°45'23" E
2635.77
BY GPS–D
632305
N = 147712.8106
E = 646903.0406
N 00°48'26" W
2638.80
NAD83(1996) OLMSTED
COUNTY COORDINATES
U.S. SURVEY FOOT
N 00°40'46" W
2620.49
27
R13W
N 00°38'37" W
2630.71
N,
C
BY GPS–D
632706
N = 145080.3063
E = 641665.6608
N 89°58'43" E
2632.71
COMP INTER
632709
N = 145081.2873
E = 644298.3696
N 89°58'43" E
2634.23
BY GPS–D
632606
N = 145082.2689
E = 646932.5955
MONUMENT LOCATION MATCHES
COMPUTED INTERSECTION
COUNTY SURVEYOR
RECOMMENDS USING THE
COMPUTED INTERSECTION
OF QUARTER LINES FOR
THE CENTER OF SECTION
N 00°42'44" W
2614.52
SEC
T106N
N 00°40'46" W
2626.39
N 00°39'30" W
2630.26
BY GPS–D
632705
N = 142465.9861
E = 641698.1634
S 89°45'45" E
2631.37
BY GPS–PR(1)
632704
N = 142455.0825
E = 644329.5156
S 89°56'13" E
2633.30
BY GPS–PR(2)
632605
N = 142452.1855
E = 646962.8124