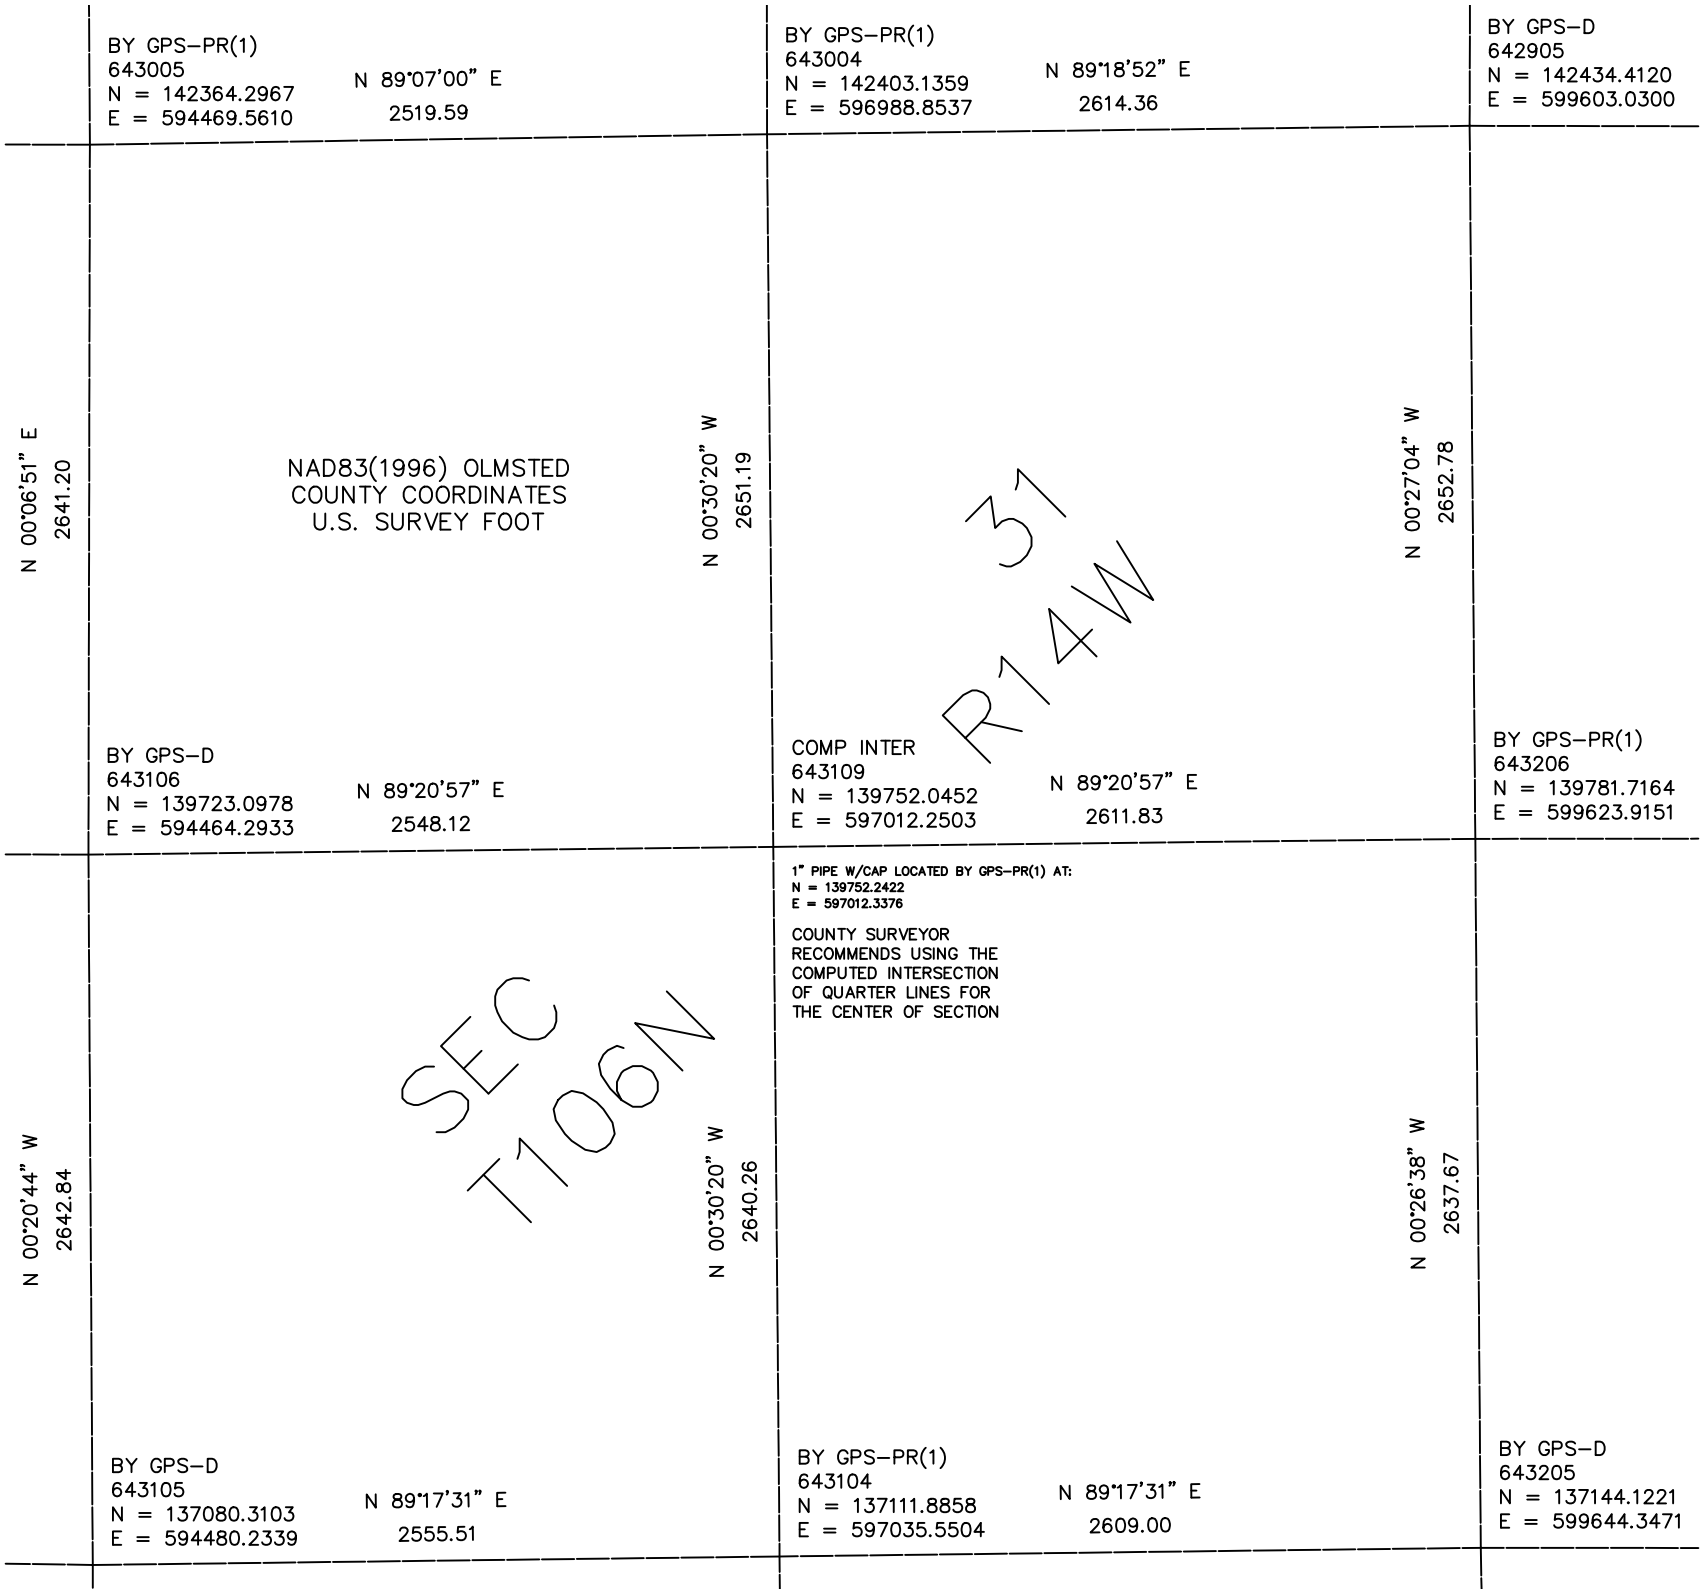

BY GPS–PR(1)
643005
N = 142364.2967
E = 594469.5610
N 89°07'00" E
2519.59
BY GPS–PR(1)
643004
N = 142403.1359
E = 596988.8537
N 89°18'52" E
2614.36
BY GPS–D
642905
N = 142434.4120
E = 599603.0300
N 00°06'51" E
2641.20
NAD83(1996) OLMSTED
COUNTY COORDINATES
U.S. SURVEY FOOT
N 00°30'20" W
2651.19
N 00°27'04" W
2652.78
31
R14W
BY GPS–D
643106
N = 139723.0978
E = 594464.2933
N 89°20'57" E
2548.12
COMP INTER
643109
N = 139752.0452
E = 597012.2503
N 89°20'57" E
2611.83
BY GPS–PR(1)
643206
N = 139781.7164
E = 599623.9151
1" PIPE W/CAP LOCATED BY GPS–PR(1) AT:
N = 139752.2422
E = 597012.3376
COUNTY SURVEYOR
RECOMMENDS USING THE
COMPUTED INTERSECTION
OF QUARTER LINES FOR
THE CENTER OF SECTION
N 00°20'44" W
2642.84
SEC
T106N
N 00°30'20" W
2640.26
N 00°26'38" W
2637.67
BY GPS–D
643105
N = 137080.3103
E = 594480.2339
N 89°17'31" E
2555.51
BY GPS–PR(1)
643104
N = 137111.8858
E = 597035.5504
N 89°17'31" E
2609.00
BY GPS–D
643205
N = 137144.1221
E = 599644.3471