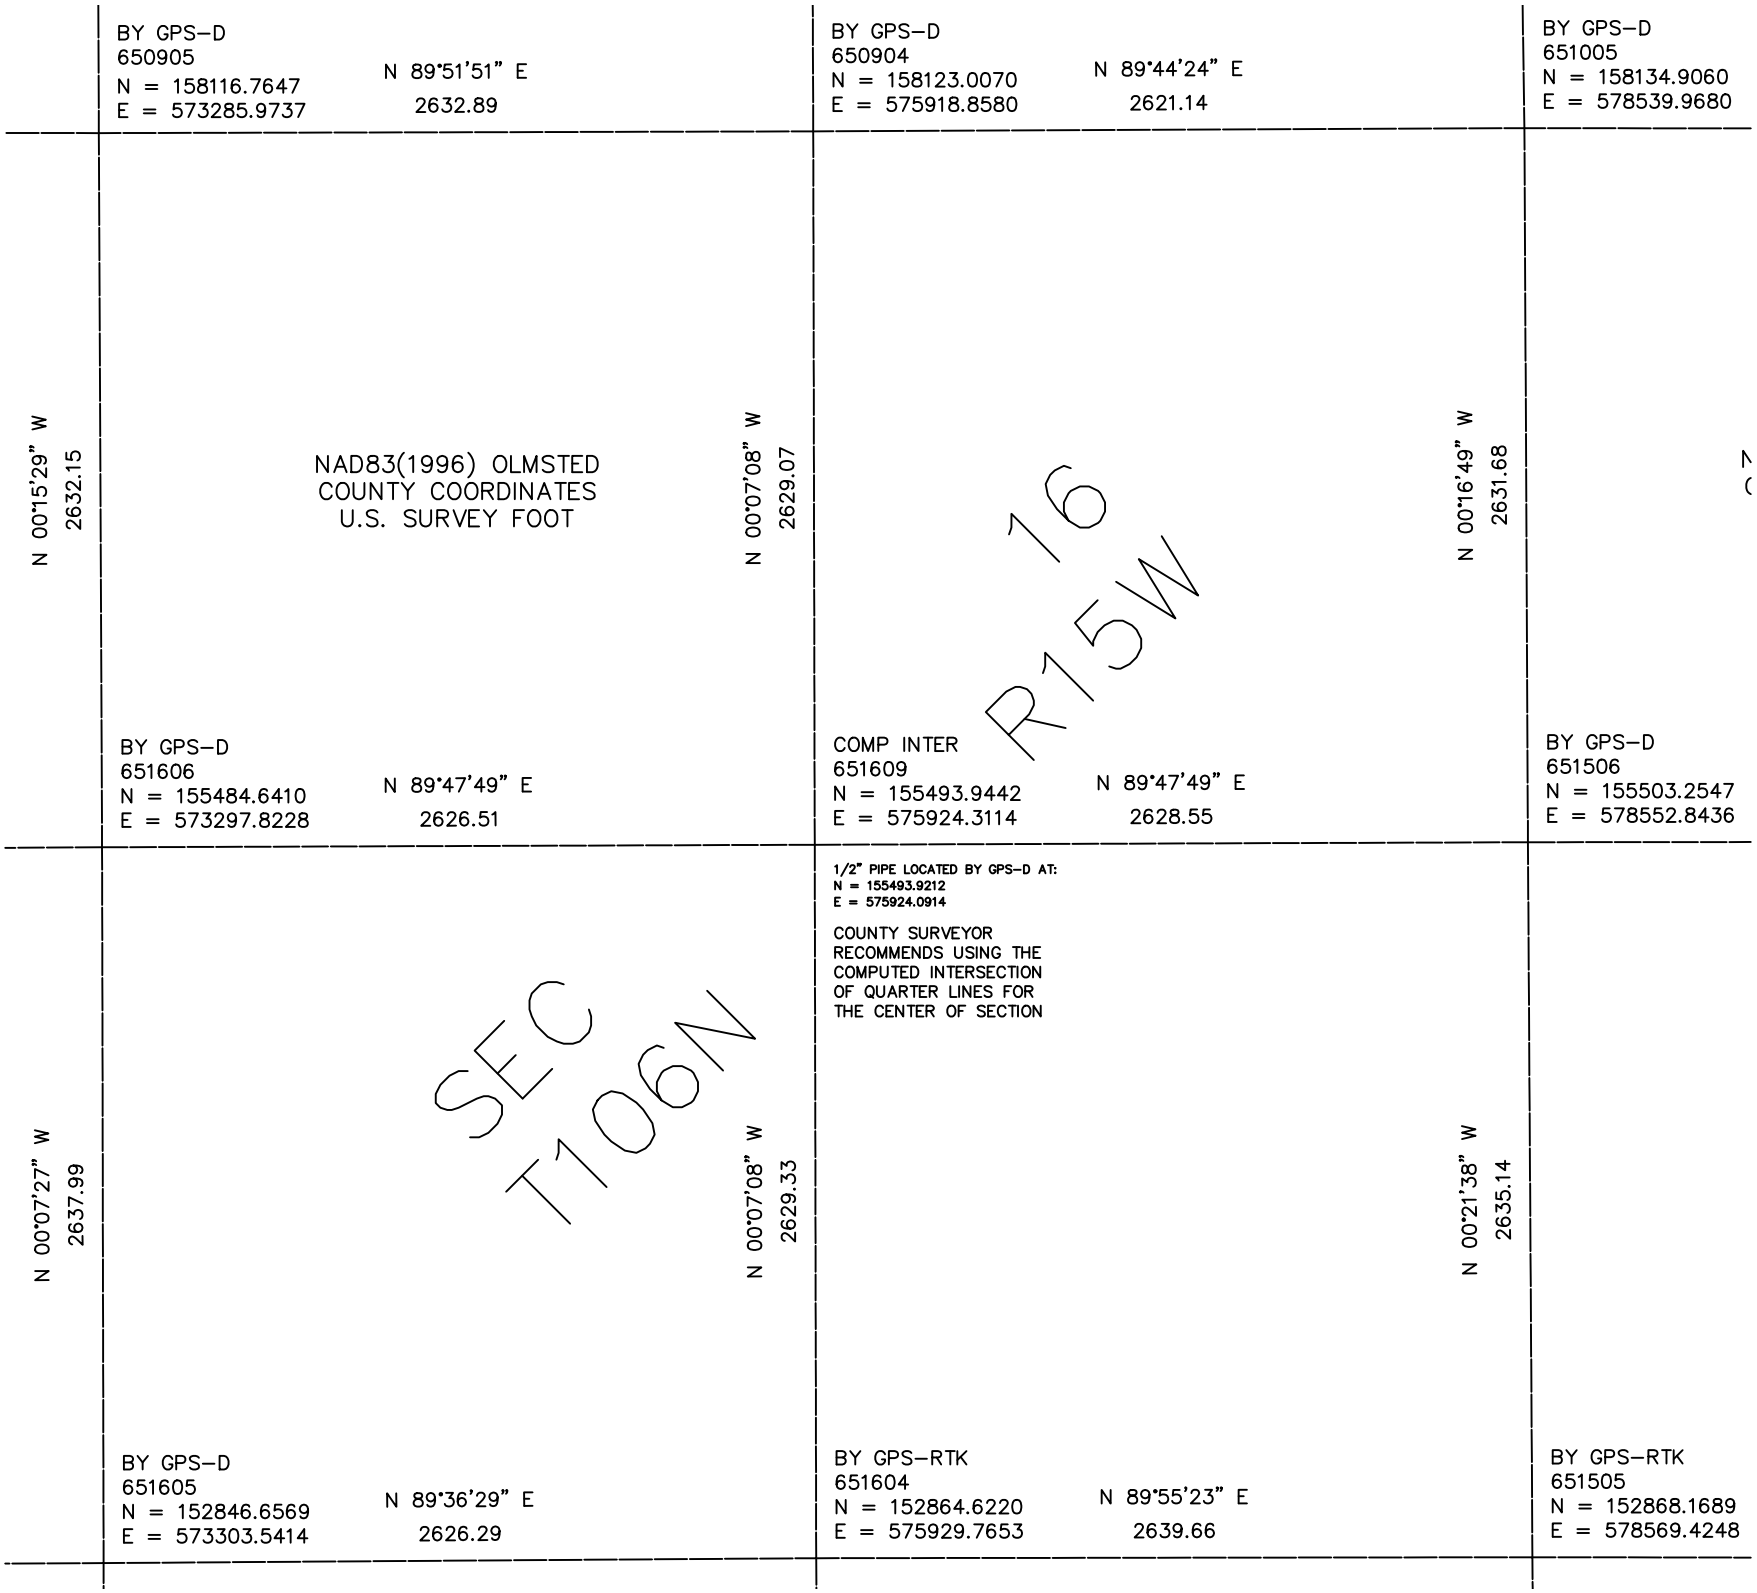

BY GPS–D
650905
N = 158116.7647
E = 573285.9737
N 89°51'51" E
2632.89
BY GPS–D
650904
N = 158123.0070
E = 575918.8580
N 89°44'24" E
2621.14
BY GPS–D
651005
N = 158134.9060
E = 578539.9680
N 00°15'29" W
2632.15
NAD83(1996) OLMSTED
COUNTY COORDINATES
U.S. SURVEY FOOT
N 00°07'08" W
2629.07
16
R15W
N 00°16'49" W
2631.68
BY GPS–D
651606
N = 155484.6410
E = 573297.8228
N 89°47'49" E
2626.51
COMP INTER
651609
N = 155493.9442
E = 575924.3114
N 89°47'49" E
2628.55
BY GPS–D
651506
N = 155503.2547
E = 578552.8436
N 00°07'27" W
2637.99
SEC
T106N
N 00°07'08" W
2629.33
1/2" PIPE LOCATED BY GPS–D AT:
N = 155493.9212
E = 575924.0914
COUNTY SURVEYOR
RECOMMENDS USING THE
COMPUTED INTERSECTION
OF QUARTER LINES FOR
THE CENTER OF SECTION
N 00°21'38" W
2635.14
BY GPS–D
651605
N = 152846.6569
E = 573303.5414
N 89°36'29" E
2626.29
BY GPS–RTK
651604
N = 152864.6220
E = 575929.7653
N 89°55'23" E
2639.66
BY GPS–RTK
651505
N = 152868.1689
E = 578569.4248