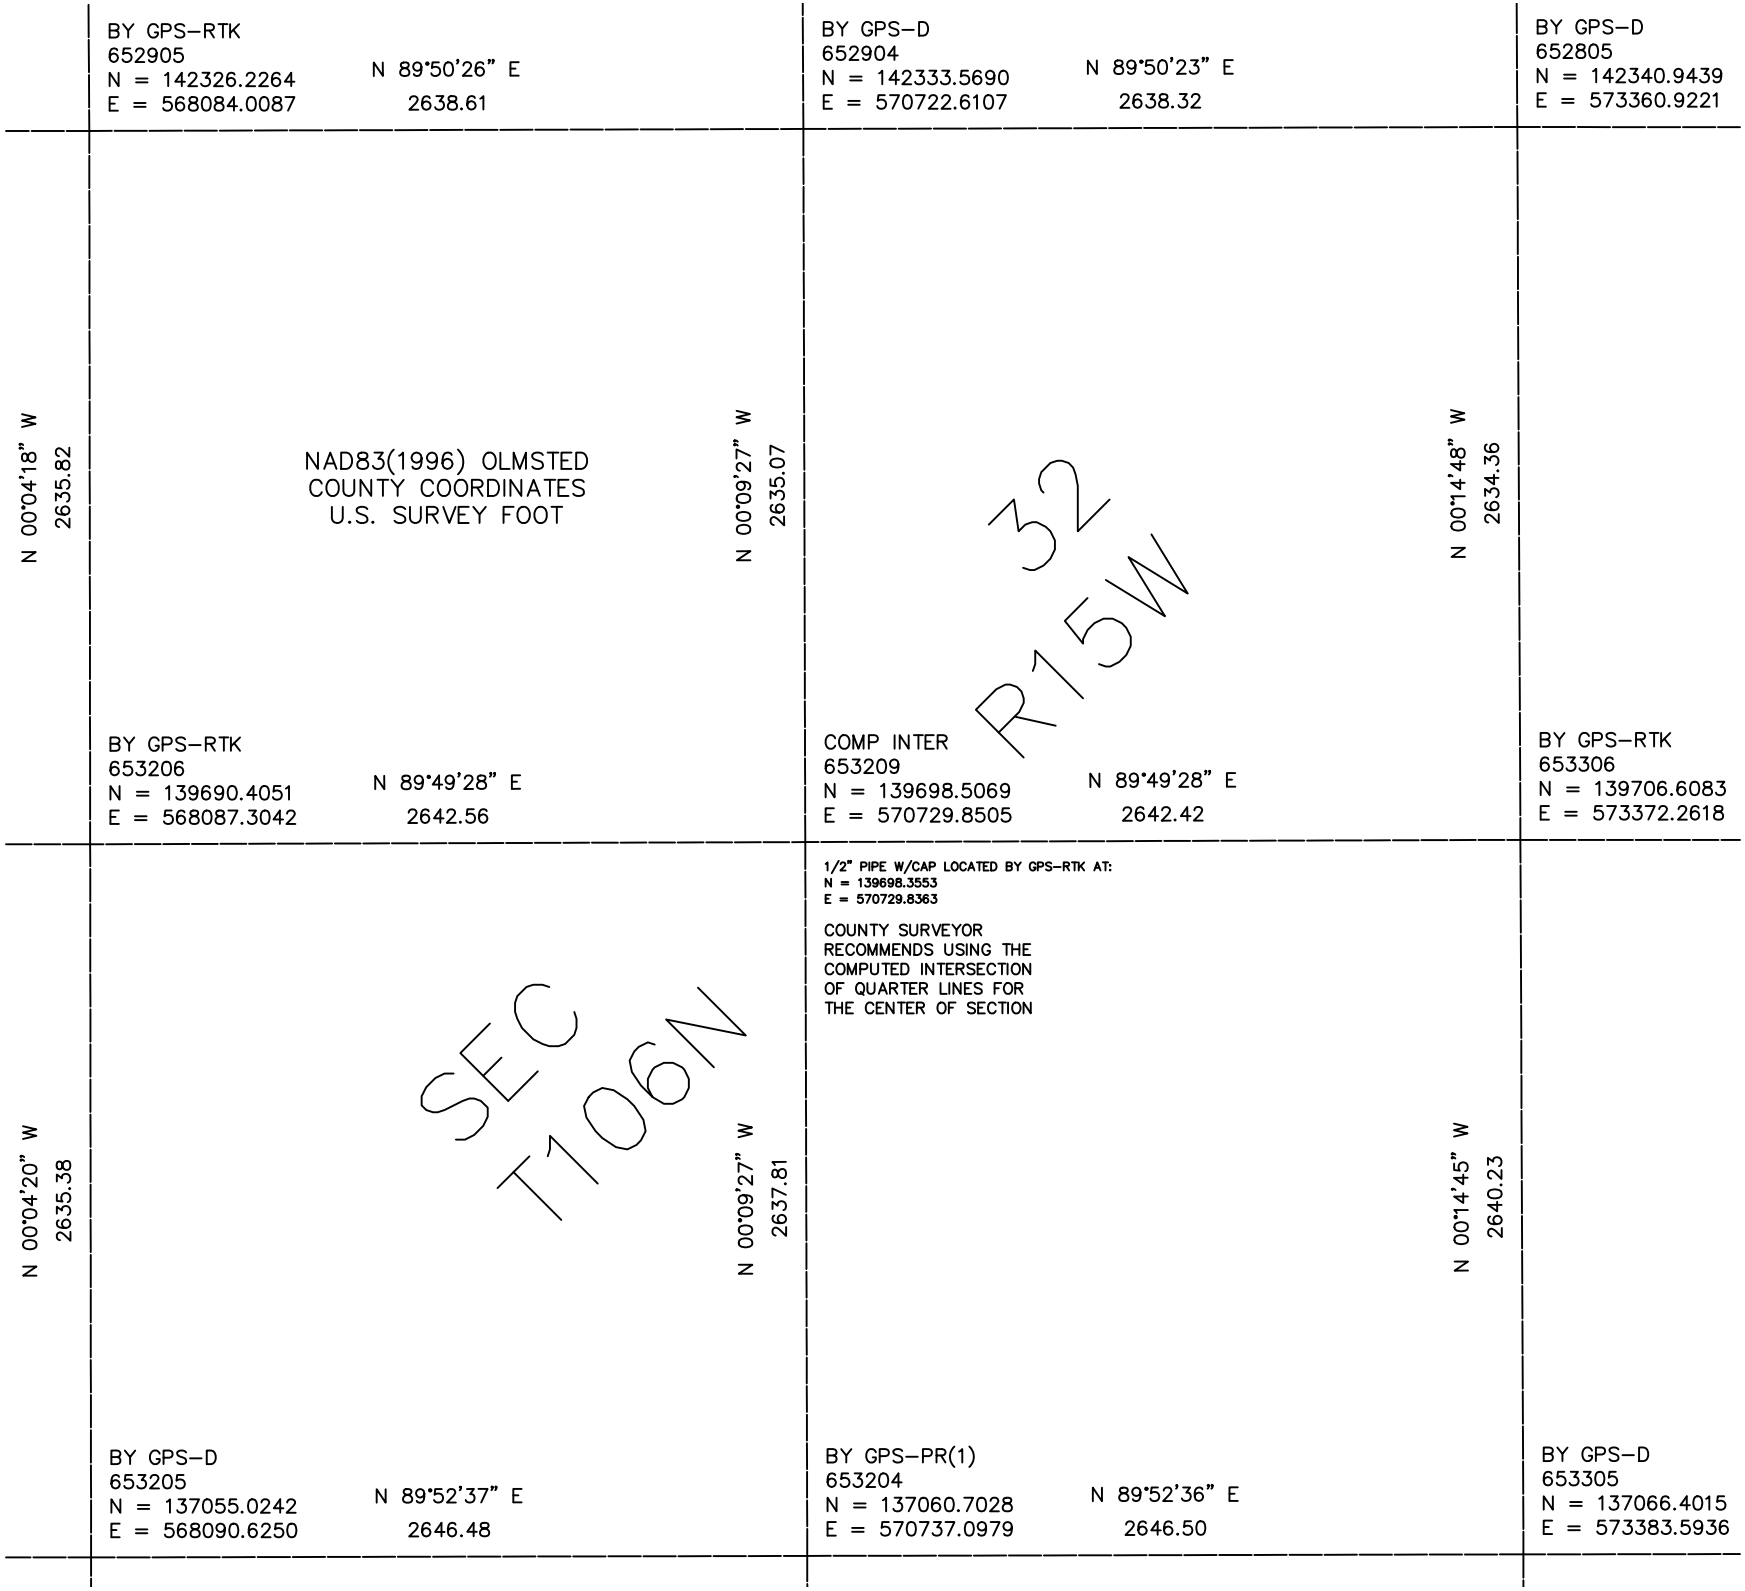

BY GPS–RTK
652905
N = 142326.2264
E = 568084.0087
N 89°50'26" E
2638.61
BY GPS–D
652904
N = 142333.5690
E = 570722.6107
N 89°50'23" E
2638.32
BY GPS–D
652805
N = 142340.9439
E = 573360.9221
N 00°04'18" W
2635.82
NAD83(1996) OLMSTED
COUNTY COORDINATES
U.S. SURVEY FOOT
N 00°09'27" W
2635.07
32
R15W
N 00°14'48" W
2634.36
BY GPS–RTK
653206
N = 139690.4051
E = 568087.3042
N 89°49'28" E
2642.56
COMP INTER
653209
N = 139698.5069
E = 570729.8505
N 89°49'28" E
2642.42
BY GPS–RTK
653306
N = 139706.6083
E = 573372.2618
N 00°04'20" W
2635.38
SEC
T106N
N 00°09'27" W
2637.81
1/2" PIPE W/CAP LOCATED BY GPS–RTK AT:
N = 139698.3553
E = 570729.8363
COUNTY SURVEYOR
RECOMMENDS USING THE
COMPUTED INTERSECTION
OF QUARTER LINES FOR
THE CENTER OF SECTION
N 00°14'45" W
2640.23
BY GPS–D
653205
N = 137055.0242
E = 568090.6250
N 89°52'37" E
2646.48
BY GPS–PR(1)
653204
N = 137060.7028
E = 570737.0979
N 89°52'36" E
2646.50
BY GPS–D
653305
N = 137066.4015
E = 573383.5936