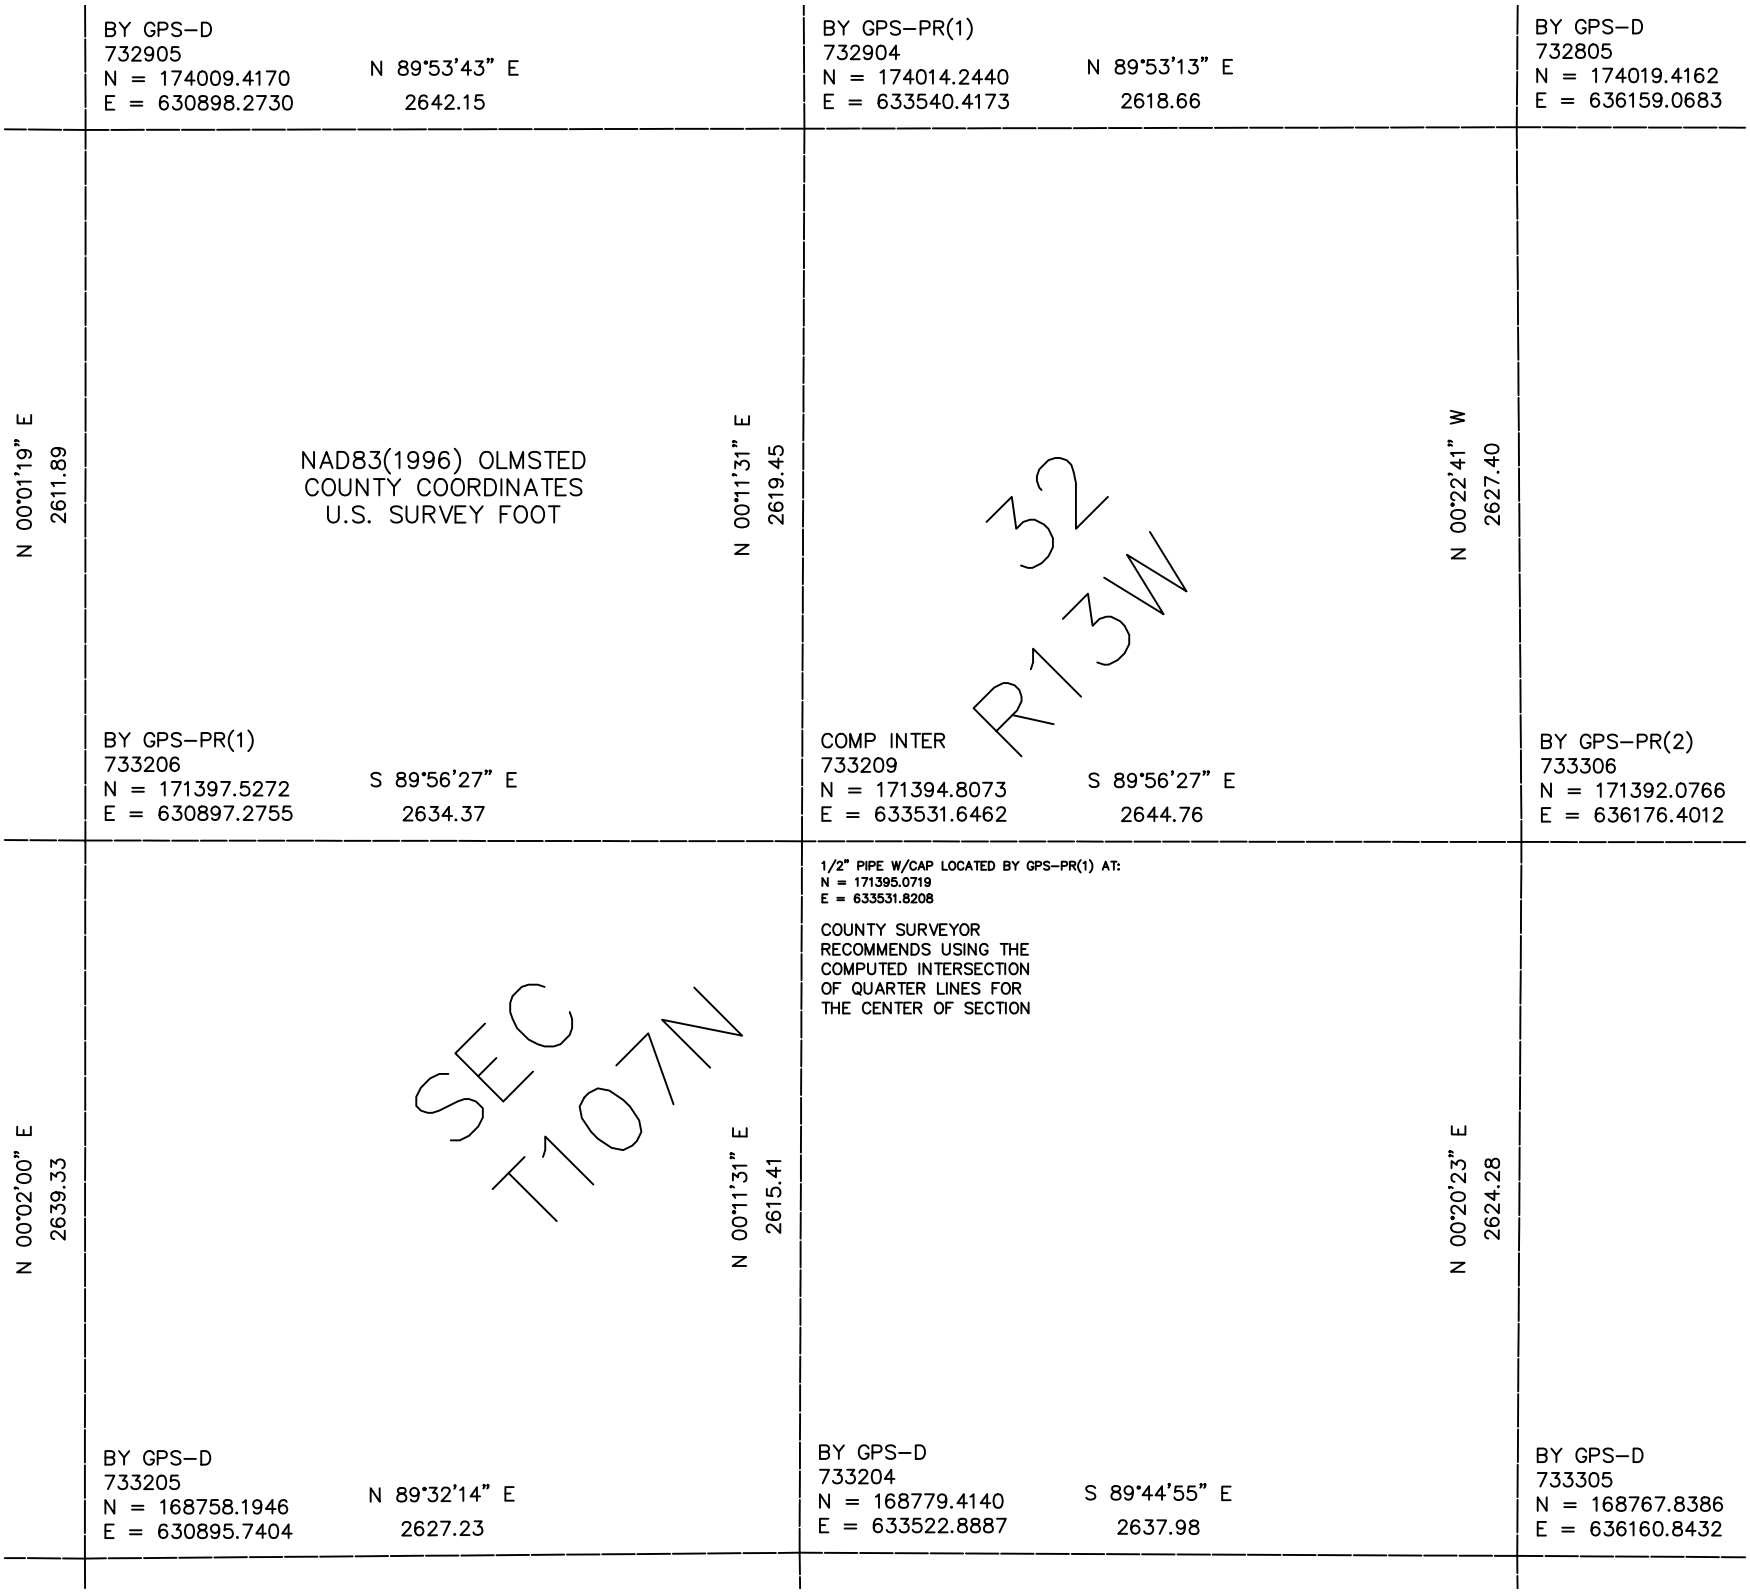

BY GPS–D
732905
N = 174009.4170
E = 630898.2730
N 89°53'43" E
2642.15
BY GPS–PR(1)
732904
N = 174014.2440
E = 633540.4173
N 89°53'13" E
2618.66
BY GPS–D
732805
N = 174019.4162
E = 636159.0683
N 00°01'19" E
2611.89
NAD83(1996) OLMSTED
COUNTY COORDINATES
U.S. SURVEY FOOT
N 00°11'31" E
2619.45
32
R13W
N 00°22'41" W
2627.40
BY GPS–PR(1)
733206
N = 171397.5272
E = 630897.2755
S 89°56'27" E
2634.37
COMP INTER
733209
N = 171394.8073
E = 633531.6462
S 89°56'27" E
2644.76
BY GPS–PR(2)
733306
N = 171392.0766
E = 636176.4012
1/2" PIPE W/CAP LOCATED BY GPS–PR(1) AT:
N = 171395.0719
E = 633531.8208
COUNTY SURVEYOR
RECOMMENDS USING THE
COMPUTED INTERSECTION
OF QUARTER LINES FOR
THE CENTER OF SECTION
N 00°02'00" E
2639.33
SEC
T107N
N 00°11'31" E
2615.41
N 00°20'23" E
2624.28
BY GPS–D
733205
N = 168758.1946
E = 630895.7404
N 89°32'14" E
2627.23
BY GPS–D
733204
N = 168779.4140
E = 633522.8887
S 89°44'55" E
2637.98
BY GPS–D
733305
N = 168767.8386
E = 636160.8432