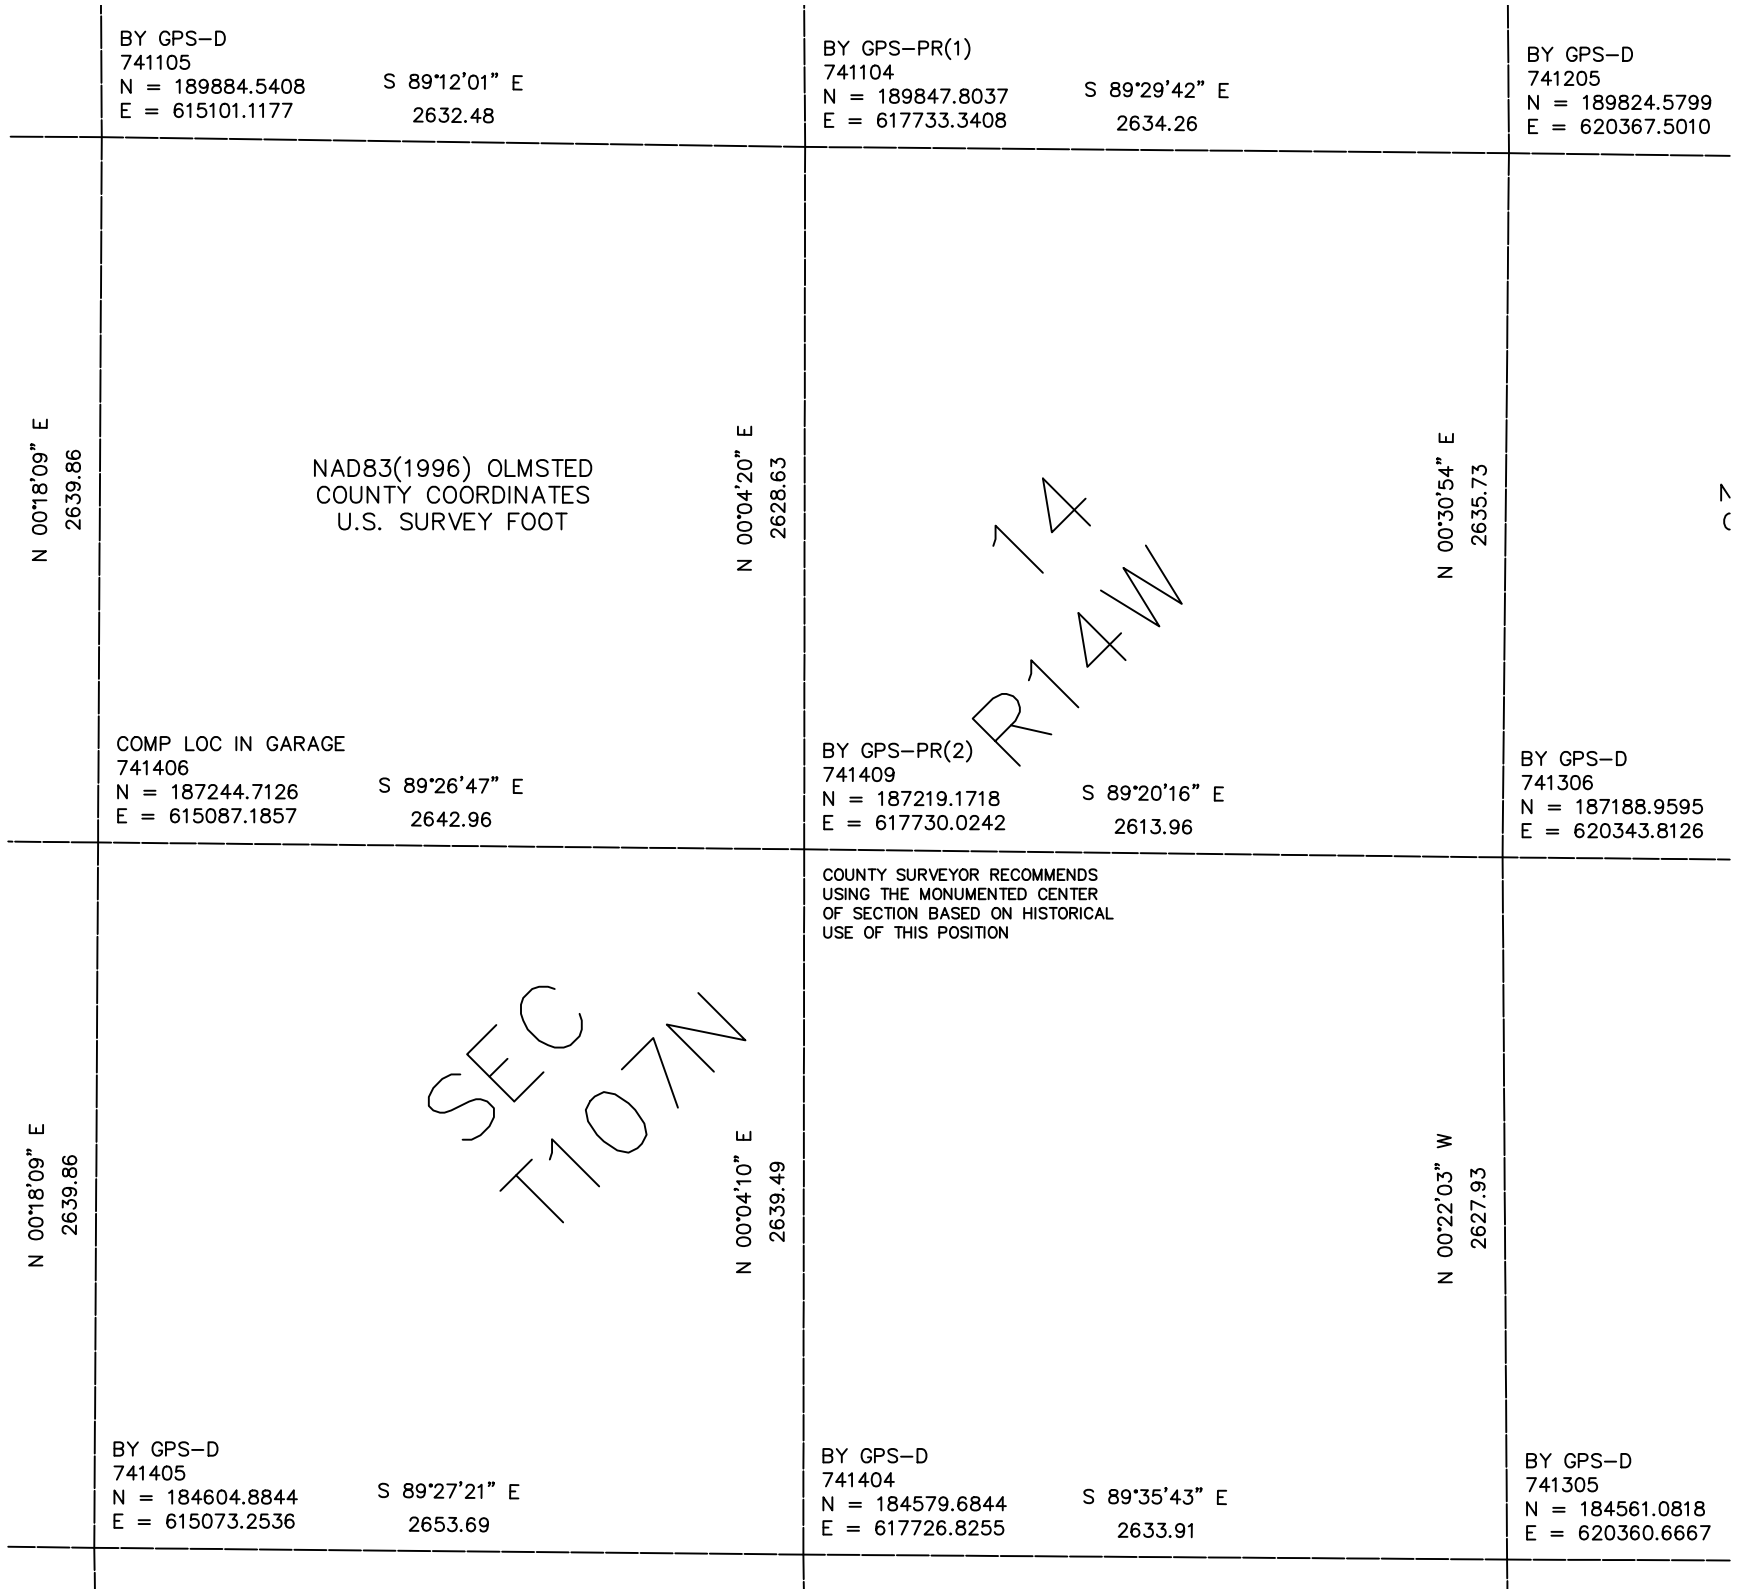

BY GPS–D
741105
N = 189884.5408
E = 615101.1177
S 89°12'01" E
2632.48
BY GPS–PR(1)
741104
N = 189847.8037
E = 617733.3408
S 89°29'42" E
2634.26
BY GPS–D
741205
N = 189824.5799
E = 620367.5010
N 00°18'09" E
2639.86
NAD83(1996) OLMSTED
COUNTY COORDINATES
U.S. SURVEY FOOT
N 00°04'20" E
2628.63
14
R14W
N 00°30'54" E
2635.73
COMP LOC IN GARAGE
741406
N = 187244.7126
E = 615087.1857
S 89°26'47" E
2642.96
BY GPS–PR(2)
741409
N = 187219.1718
E = 617730.0242
S 89°20'16" E
2613.96
BY GPS–D
741306
N = 187188.9595
E = 620343.8126
COUNTY SURVEYOR RECOMMENDS
USING THE MONUMENTED CENTER
OF SECTION BASED ON HISTORICAL
USE OF THIS POSITION
N 00°18'09" E
2639.86
SEC
T107N
N 00°04'10" E
2639.49
N 00°22'03" W
2627.93
BY GPS–D
741405
N = 184604.8844
E = 615073.2536
S 89°27'21" E
2653.69
BY GPS–D
741404
N = 184579.6844
E = 617726.8255
S 89°35'43" E
2633.91
BY GPS–D
741305
N = 184561.0818
E = 620360.6667