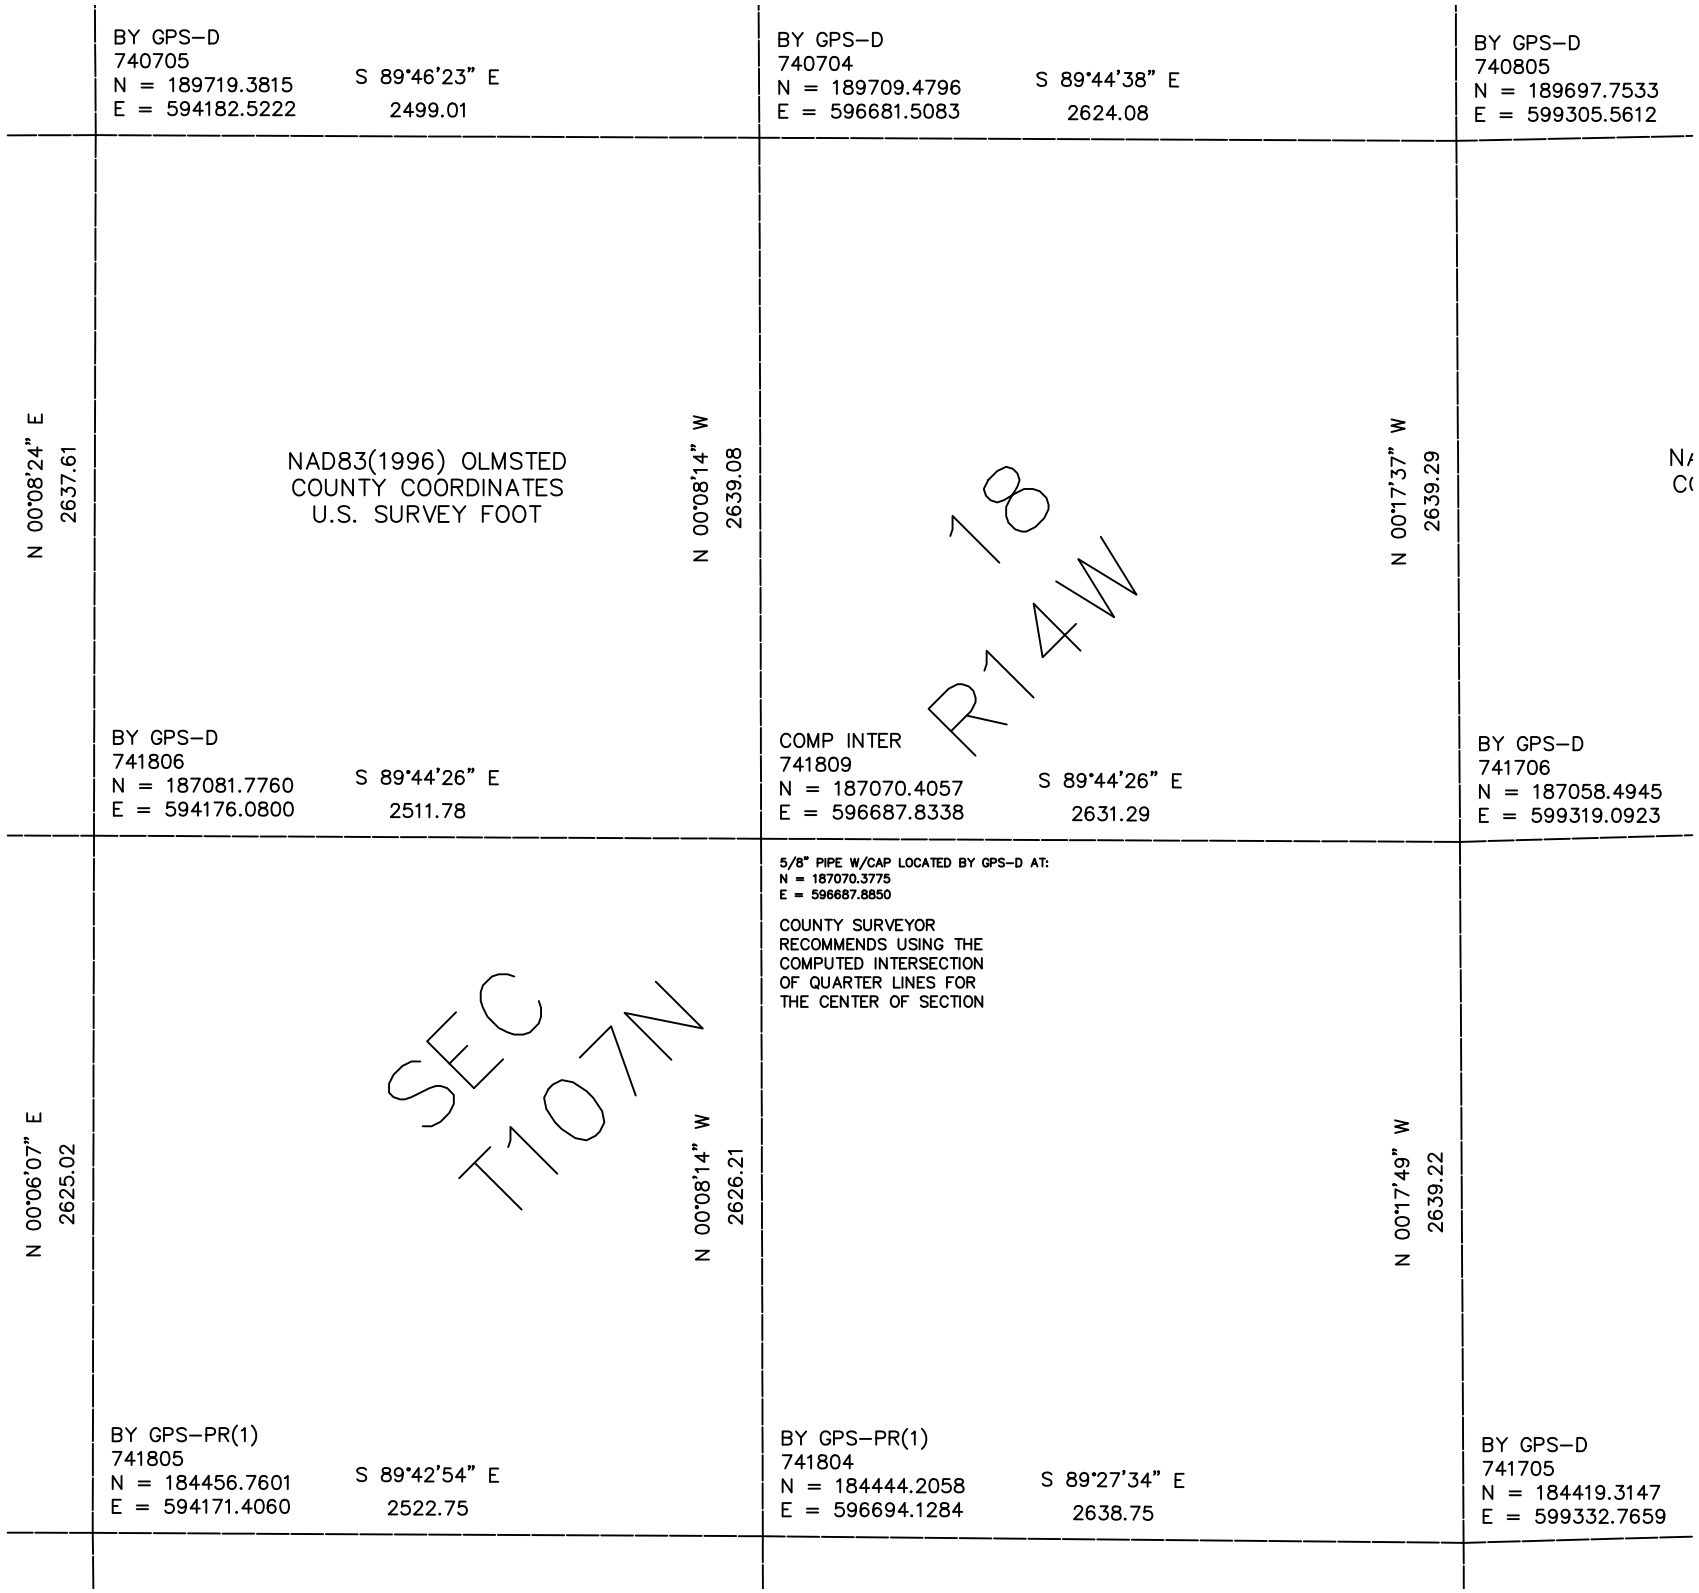

BY GPS–D
740705
N = 189719.3815
E = 594182.5222
S 89°46'23" E
2499.01
BY GPS–D
740704
N = 189709.4796
E = 596681.5083
S 89°44'38" E
2624.08
BY GPS–D
740805
N = 189697.7533
E = 599305.5612
N 00°08'24" E
2637.61
NAD83(1996) OLMSTED
COUNTY COORDINATES
U.S. SURVEY FOOT
N 00°08'14" W
2639.08
18
R14W
N 00°17'37" W
2639.29
BY GPS–D
741806
N = 187081.7760
E = 594176.0800
S 89°44'26" E
2511.78
COMP INTER
741809
N = 187070.4057
E = 596687.8338
S 89°44'26" E
2631.29
BY GPS–D
741706
N = 187058.4945
E = 599319.0923
5/8" PIPE W/CAP LOCATED BY GPS–D AT:
N = 187070.3775
E = 596687.8850
COUNTY SURVEYOR
RECOMMENDS USING THE
COMPUTED INTERSECTION
OF QUARTER LINES FOR
THE CENTER OF SECTION
N 00°06'07" E
2625.02
SEC
T107N
N 00°08'14" W
2626.21
N 00°17'49" W
2639.22
BY GPS–PR(1)
741805
N = 184456.7601
E = 594171.4060
S 89°42'54" E
2522.75
BY GPS–PR(1)
741804
N = 184444.2058
E = 596694.1284
S 89°27'34" E
2638.75
BY GPS–D
741705
N = 184419.3147
E = 599332.7659