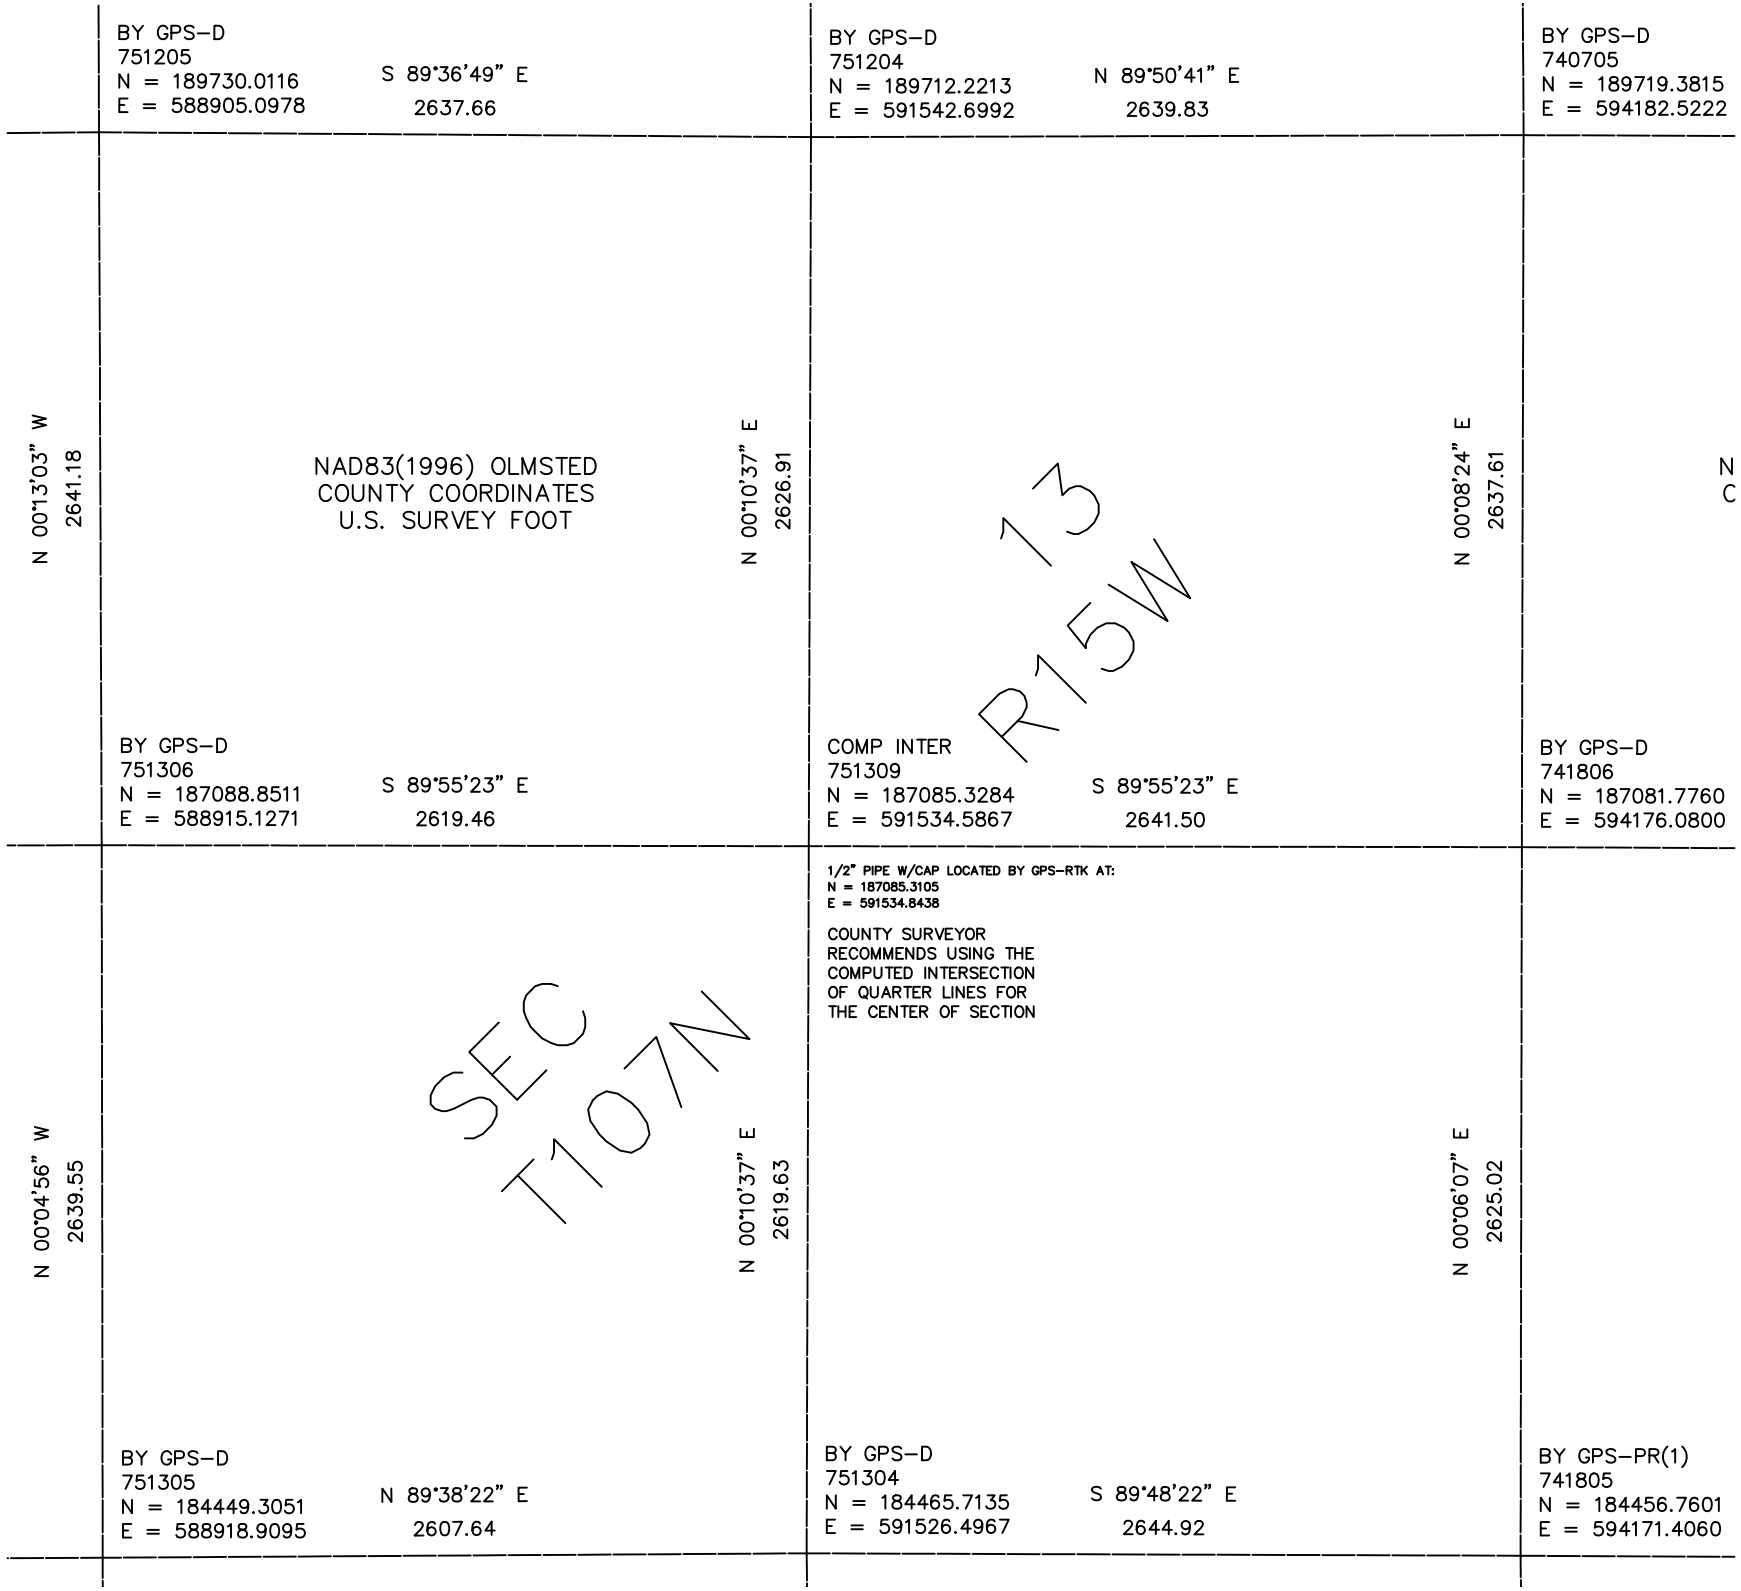

BY GPS–D
751205
N = 189730.0116
E = 588905.0978
S 89°36'49" E
2637.66
BY GPS–D
751204
N = 189712.2213
E = 591542.6992
N 89°50'41" E
2639.83
BY GPS–D
740705
N = 189719.3815
E = 594182.5222
N 00°13'03" W
2641.18
NAD83(1996) OLMSTED
COUNTY COORDINATES
U.S. SURVEY FOOT
N 00°10'37" E
2626.91
N 00°08'24" E
2637.61
13
R15W
BY GPS–D
751306
N = 187088.8511
E = 588915.1271
S 89°55'23" E
2619.46
COMP INTER
751309
N = 187085.3284
E = 591534.5867
S 89°55'23" E
2641.50
BY GPS–D
741806
N = 187081.7760
E = 594176.0800
1/2" PIPE W/CAP LOCATED BY GPS–RTK AT:
N = 187085.3105
E = 591534.8438
COUNTY SURVEYOR
RECOMMENDS USING THE
COMPUTED INTERSECTION
OF QUARTER LINES FOR
THE CENTER OF SECTION
N 00°04'56" W
2639.55
SEC
T107N
N 00°10'37" E
2619.63
N 00°06'07" E
2625.02
BY GPS–D
751305
N = 184449.3051
E = 588918.9095
N 89°38'22" E
2607.64
BY GPS–D
751304
N = 184465.7135
E = 591526.4967
S 89°48'22" E
2644.92
BY GPS–PR(1)
741805
N = 184456.7601
E = 594171.4060