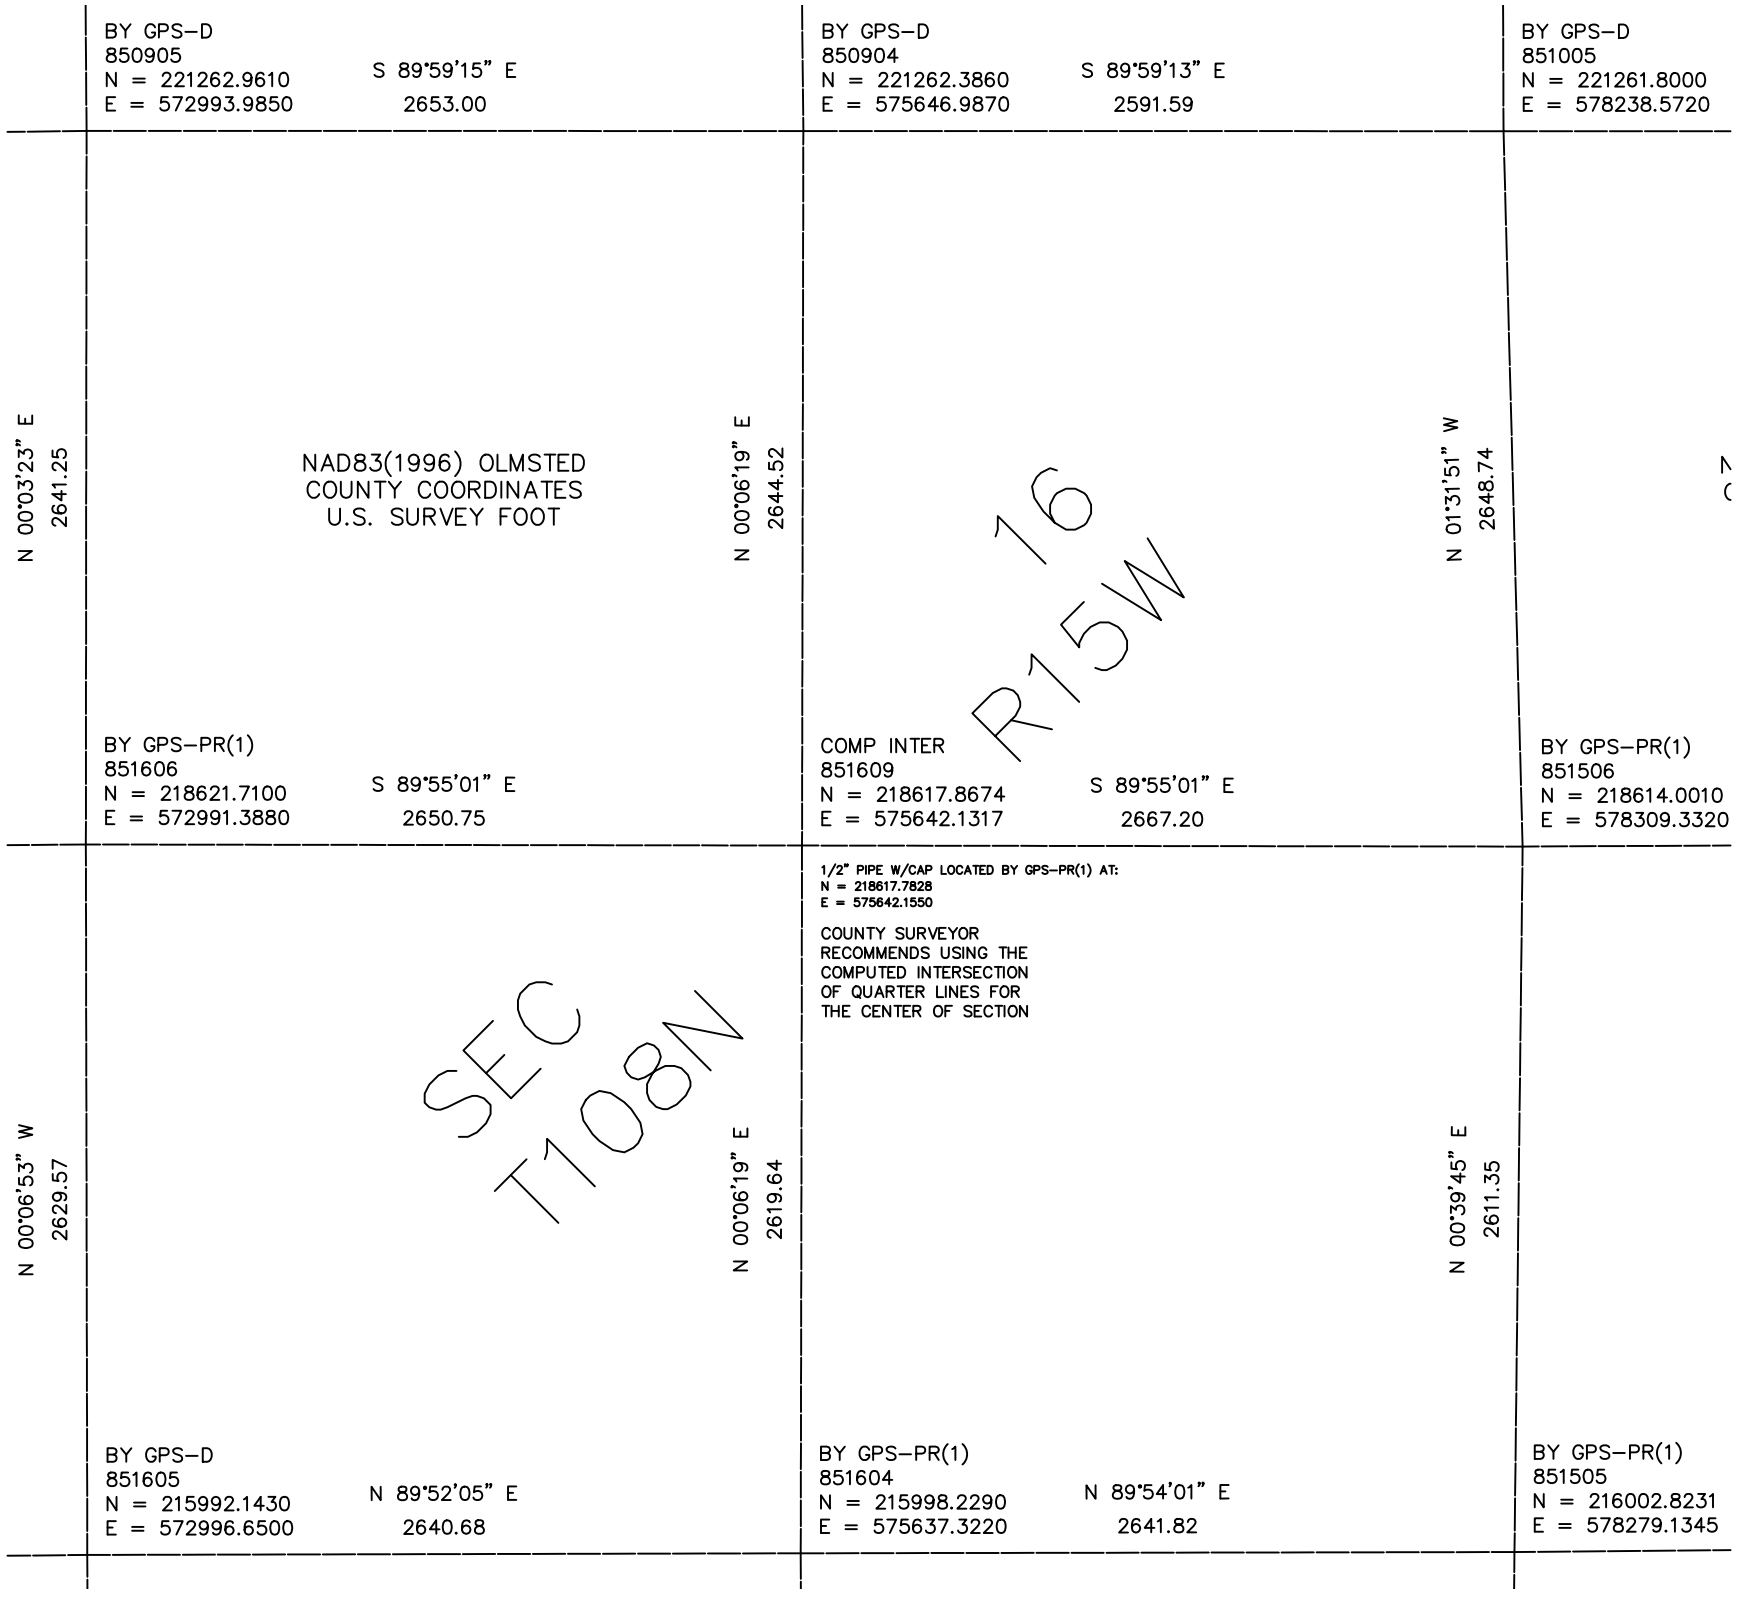

BY GPS–D
850905
N = 221262.9610
E = 572993.9850
S 89°59'15" E
2653.00
BY GPS–D
850904
N = 221262.3860
E = 575646.9870
S 89°59'13" E
2591.59
BY GPS–D
851005
N = 221261.8000
E = 578238.5720
N 00°03'23" E
2641.25
NAD83(1996) OLMSTED
COUNTY COORDINATES
U.S. SURVEY FOOT
N 00°06'19" E
2644.52
16
R15W
N 01°31'51" W
2648.74
BY GPS–PR(1)
851606
N = 218621.7100
E = 572991.3880
S 89°55'01" E
2650.75
COMP INTER
851609
N = 218617.8674
E = 575642.1317
S 89°55'01" E
2667.20
BY GPS–PR(1)
851506
N = 218614.0010
E = 578309.3320
1/2" PIPE W/CAP LOCATED BY GPS–PR(1) AT:
N = 218617.7828
E = 575642.1550
COUNTY SURVEYOR
RECOMMENDS USING THE
COMPUTED INTERSECTION
OF QUARTER LINES FOR
THE CENTER OF SECTION
N 00°06'53" W
2629.57
SEC
T108N
N 00°06'19" E
2619.64
N 00°39'45" E
2611.35
BY GPS–D
851605
N = 215992.1430
E = 572996.6500
N 89°52'05" E
2640.68
BY GPS–PR(1)
851604
N = 215998.2290
E = 575637.3220
N 89°54'01" E
2641.82
BY GPS–PR(1)
851505
N = 216002.8231
E = 578279.1345