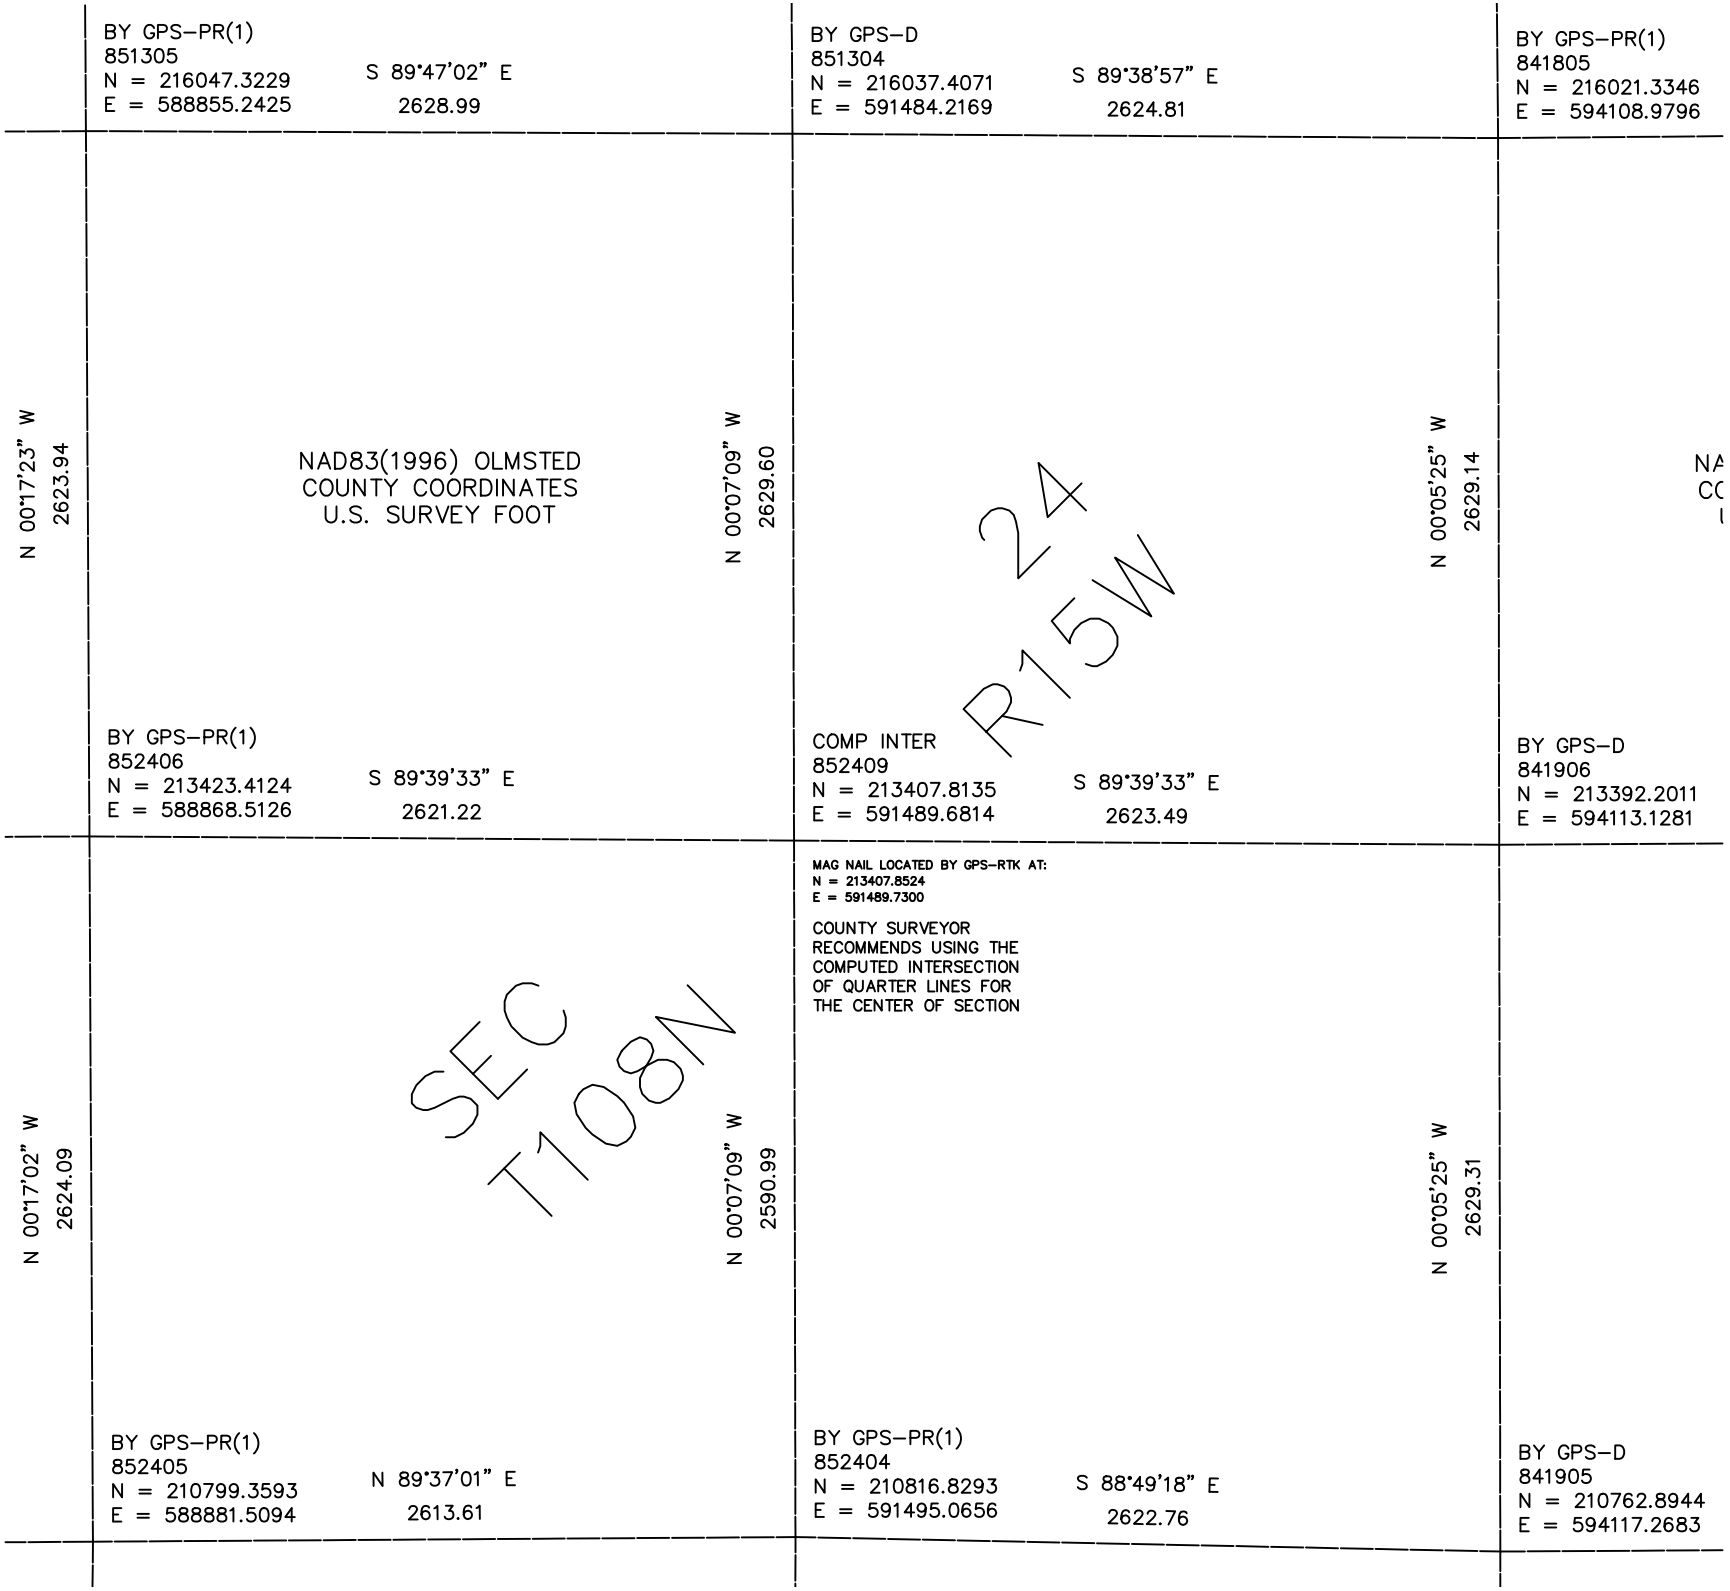

BY GPS–PR(1)
851305
N = 216047.3229
E = 588855.2425
S 89°47'02" E
2628.99
BY GPS–D
851304
N = 216037.4071
E = 591484.2169
S 89°38'57" E
2624.81
BY GPS–PR(1)
841805
N = 216021.3346
E = 594108.9796
N 00°17'23" W
2623.94
NAD83(1996) OLMSTED
COUNTY COORDINATES
U.S. SURVEY FOOT
N 00°07'09" W
2629.60
24
R15W
N 00°05'25" W
2629.14
BY GPS–PR(1)
852406
N = 213423.4124
E = 588868.5126
S 89°39'33" E
2621.22
COMP INTER
852409
N = 213407.8135
E = 591489.6814
S 89°39'33" E
2623.49
BY GPS–D
841906
N = 213392.2011
E = 594113.1281
MAG NAIL LOCATED BY GPS–RTK AT:
N = 213407.8524
E = 591489.7300
COUNTY SURVEYOR
RECOMMENDS USING THE
COMPUTED INTERSECTION
OF QUARTER LINES FOR
THE CENTER OF SECTION
N 00°17'02" W
2624.09
SEC
T108N
N 00°07'09" W
2590.99
N 00°05'25" W
2629.31
BY GPS–PR(1)
852405
N = 210799.3593
E = 588881.5094
N 89°37'01" E
2613.61
BY GPS–PR(1)
852404
N = 210816.8293
E = 591495.0656
S 88°49'18" E
2622.76
BY GPS–D
841905
N = 210762.8944
E = 594117.2683