
Township No. 104 N., Range No. 15 West 5th. Mer:

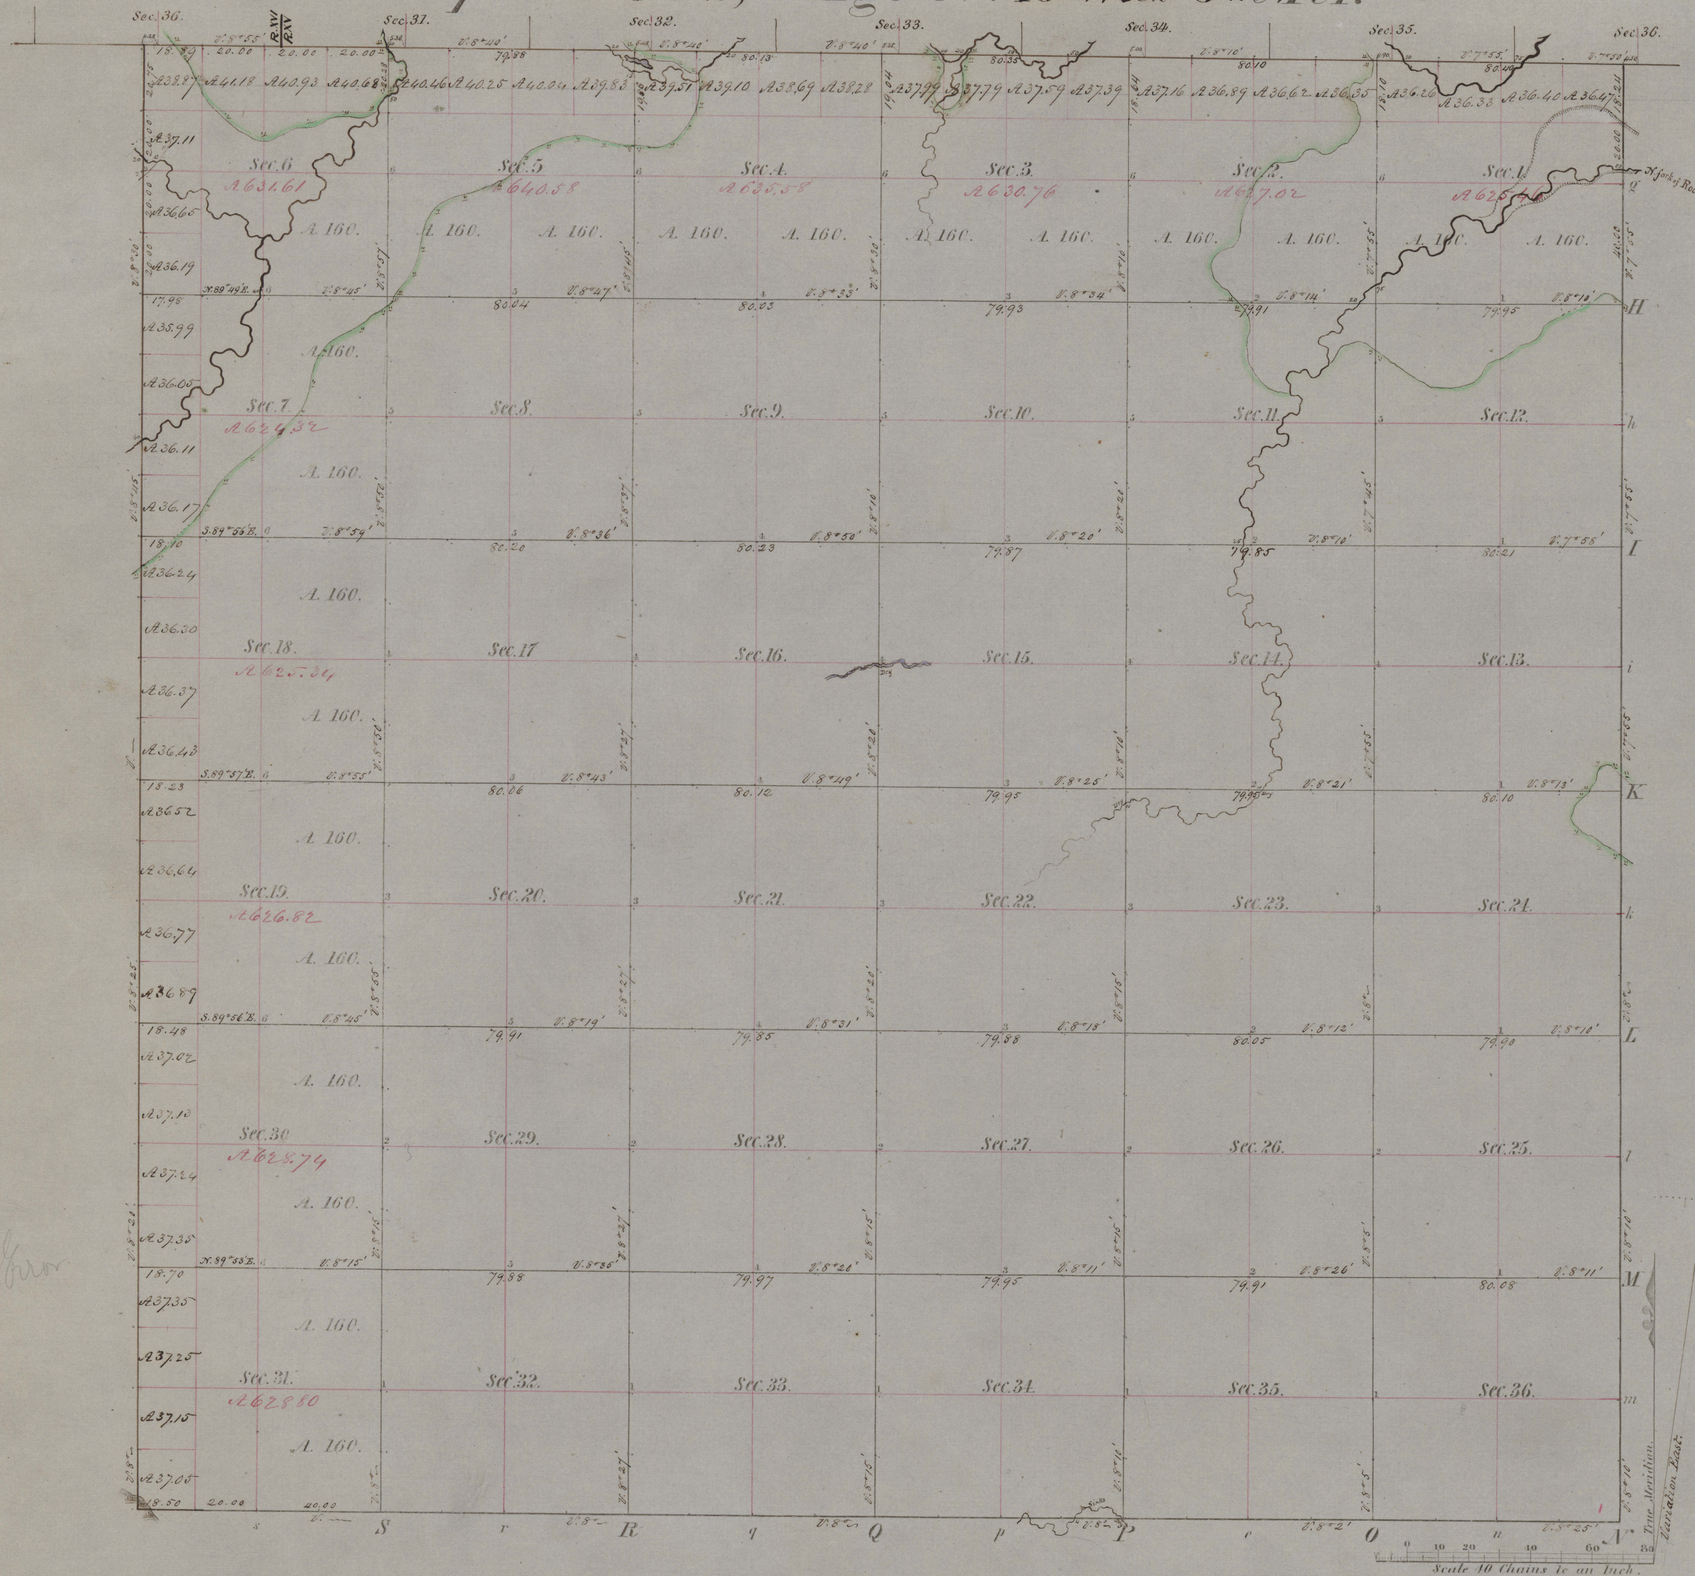

Meanders of

Posts	Courses	Ch.Lks.	Posts	Courses	Ch.Lks.	Posts	Courses	Ch.Lks.

Total number of Acres 22.925.03

	Surveys Designated	By Whom Surveyed	Date of Contract	Amount of Surveys	When Surveyed	When pd for and chd in the Surr Genls acct
S.W.&E.	Township lines	John Ball	June 9th. 1853	M. Chs Lks. 17 " 77 " 49	July, 1853.	
	Subdivisions	John Quigley	July 14th. 1853	59. 67 " 19	August 1853.	
N. Boundary	1st Standard Parallel.	E. S. Norris	June 2nd. 1853	5 " 79 " 75	September 1853.	

The above Map of Township No. 104 North of Range No. 15 West of the 5th. Principal Meridian Minnesota Territory is strictly conformable to the field notes of the survey thereof on file in this Office, which have been examined and approved.

Surveyor Generals Office,
Dubuque, December 24th. 1853.

Warren Sawyer
Surr. Genl.