
Township No. 105 N. Range No. 11 West, 5th Mer.

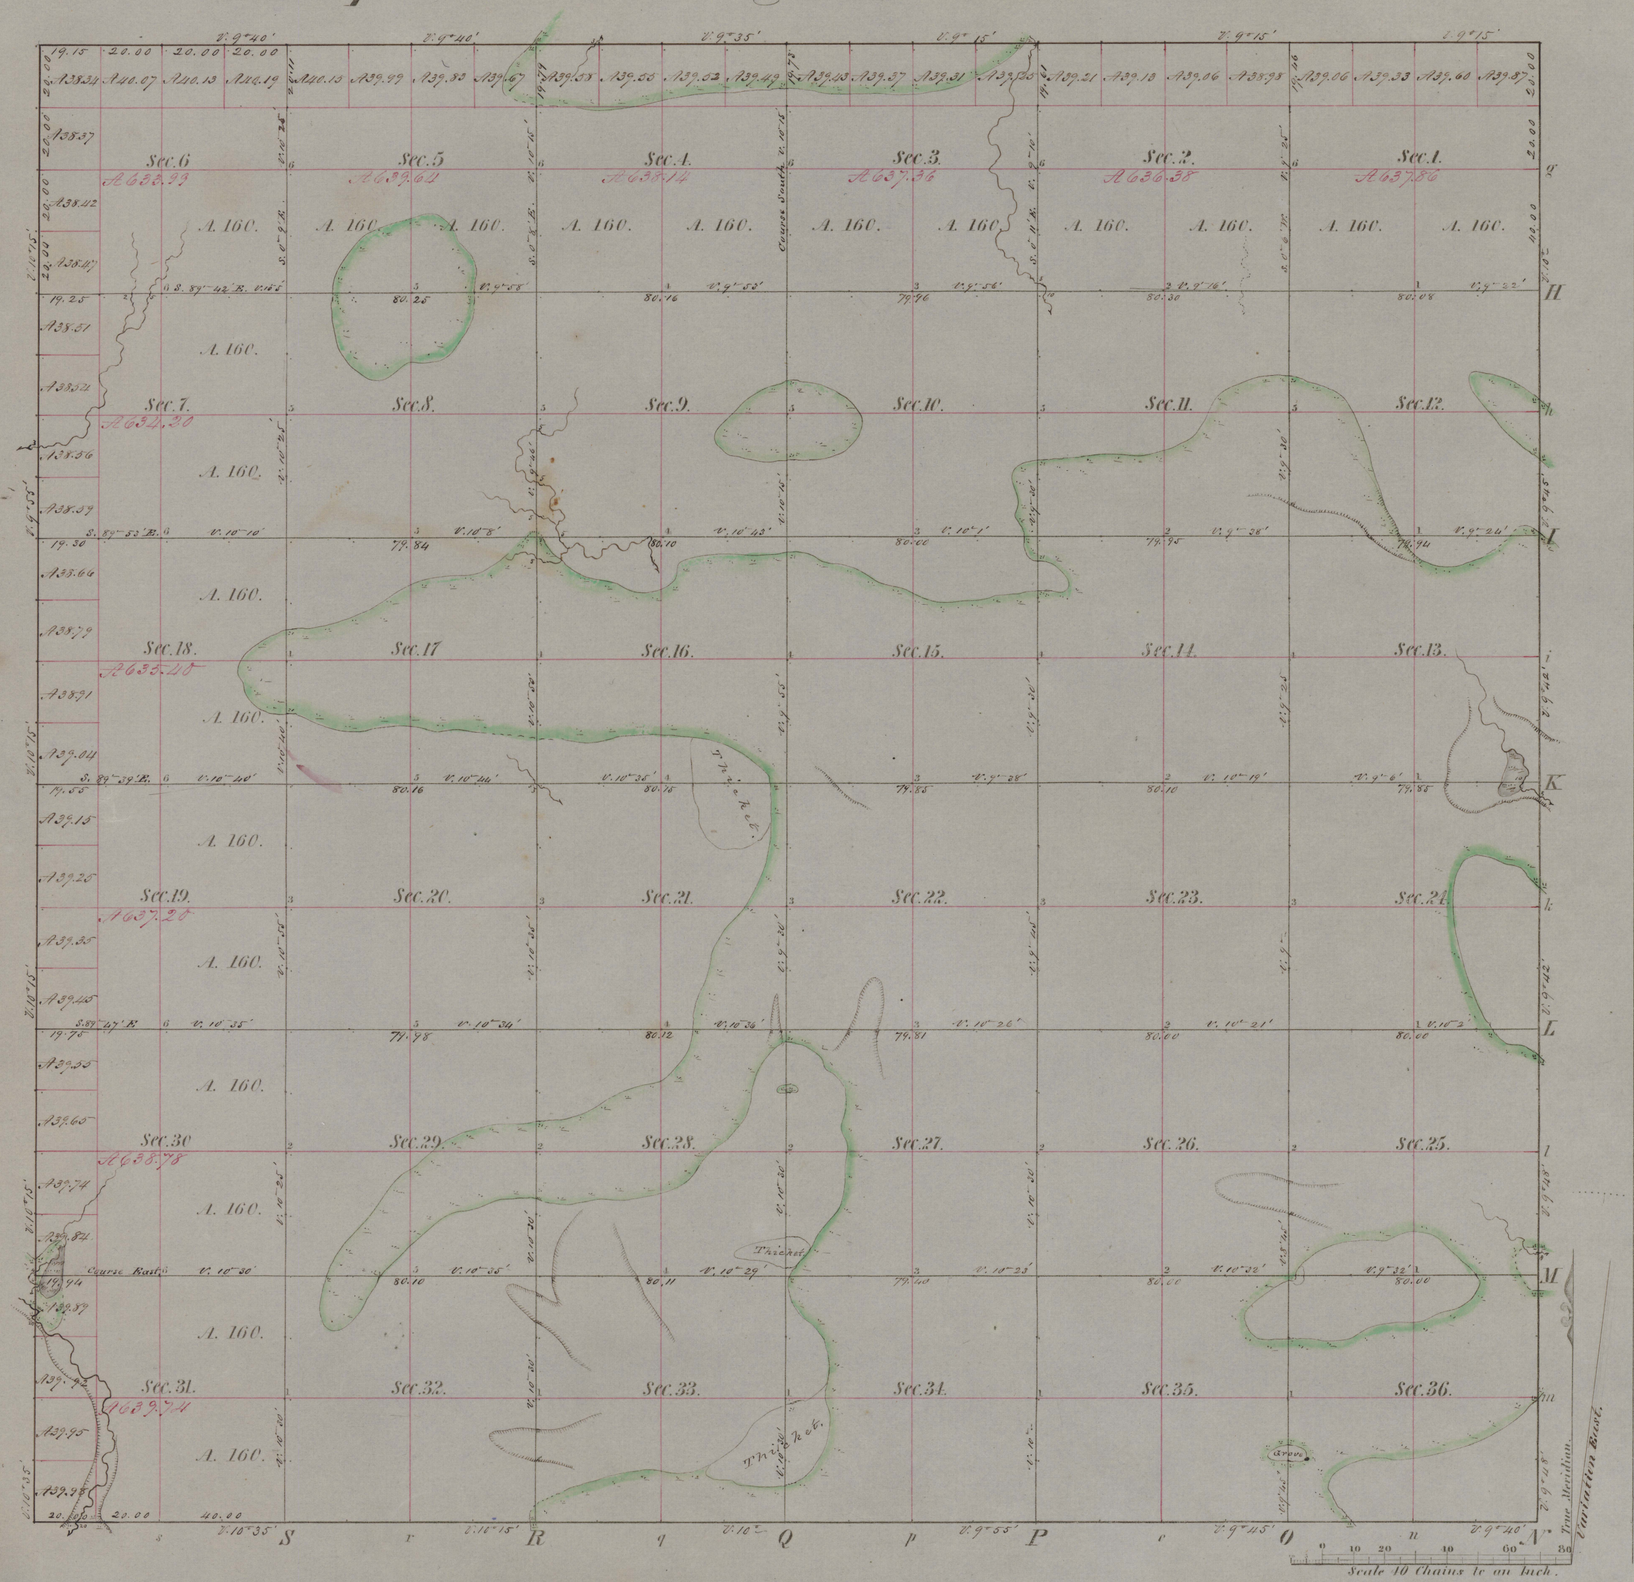

Meanders of

Posts	Courses	Ch.s Lk.s	Posts	Courses	Ch.s Lk.s	Posts	Courses	Ch.s Lk.s

Total number of Acres 23658.69

	Surveys Designated	By Whom Surveyed	Date of Contract	Amount of Surveys	When Surveyed	When p.d for and ch.s in the Sur.r Gen.ls acc.t
				M. Ch.s Lks.		
S. & E.	Township lines	E. V. Norris	June 2d 1853	12. 00. 00	June & Sept.r 1853	
	Subdivisions	Wm A. Jones	August 20th 1853	59. 76. 70	August 1853	
W. & N.	Township lines	John Ball	August 12th 1853	11. 79. 15	September 1853	

The above Map of Township No 105 North, of Range No 11 West of the 5th Principal Meridian, Minnesota is strictly conformable to the field notes of the survey thereof on file in this Office, which have been examined and approved.

Surveyor Generals Office.
Dubuque, March 30th 1854.

Warren Lewis
Sur.r Gen.l