
Township No. 105 N., Range No. 12 West 5th. Mer.

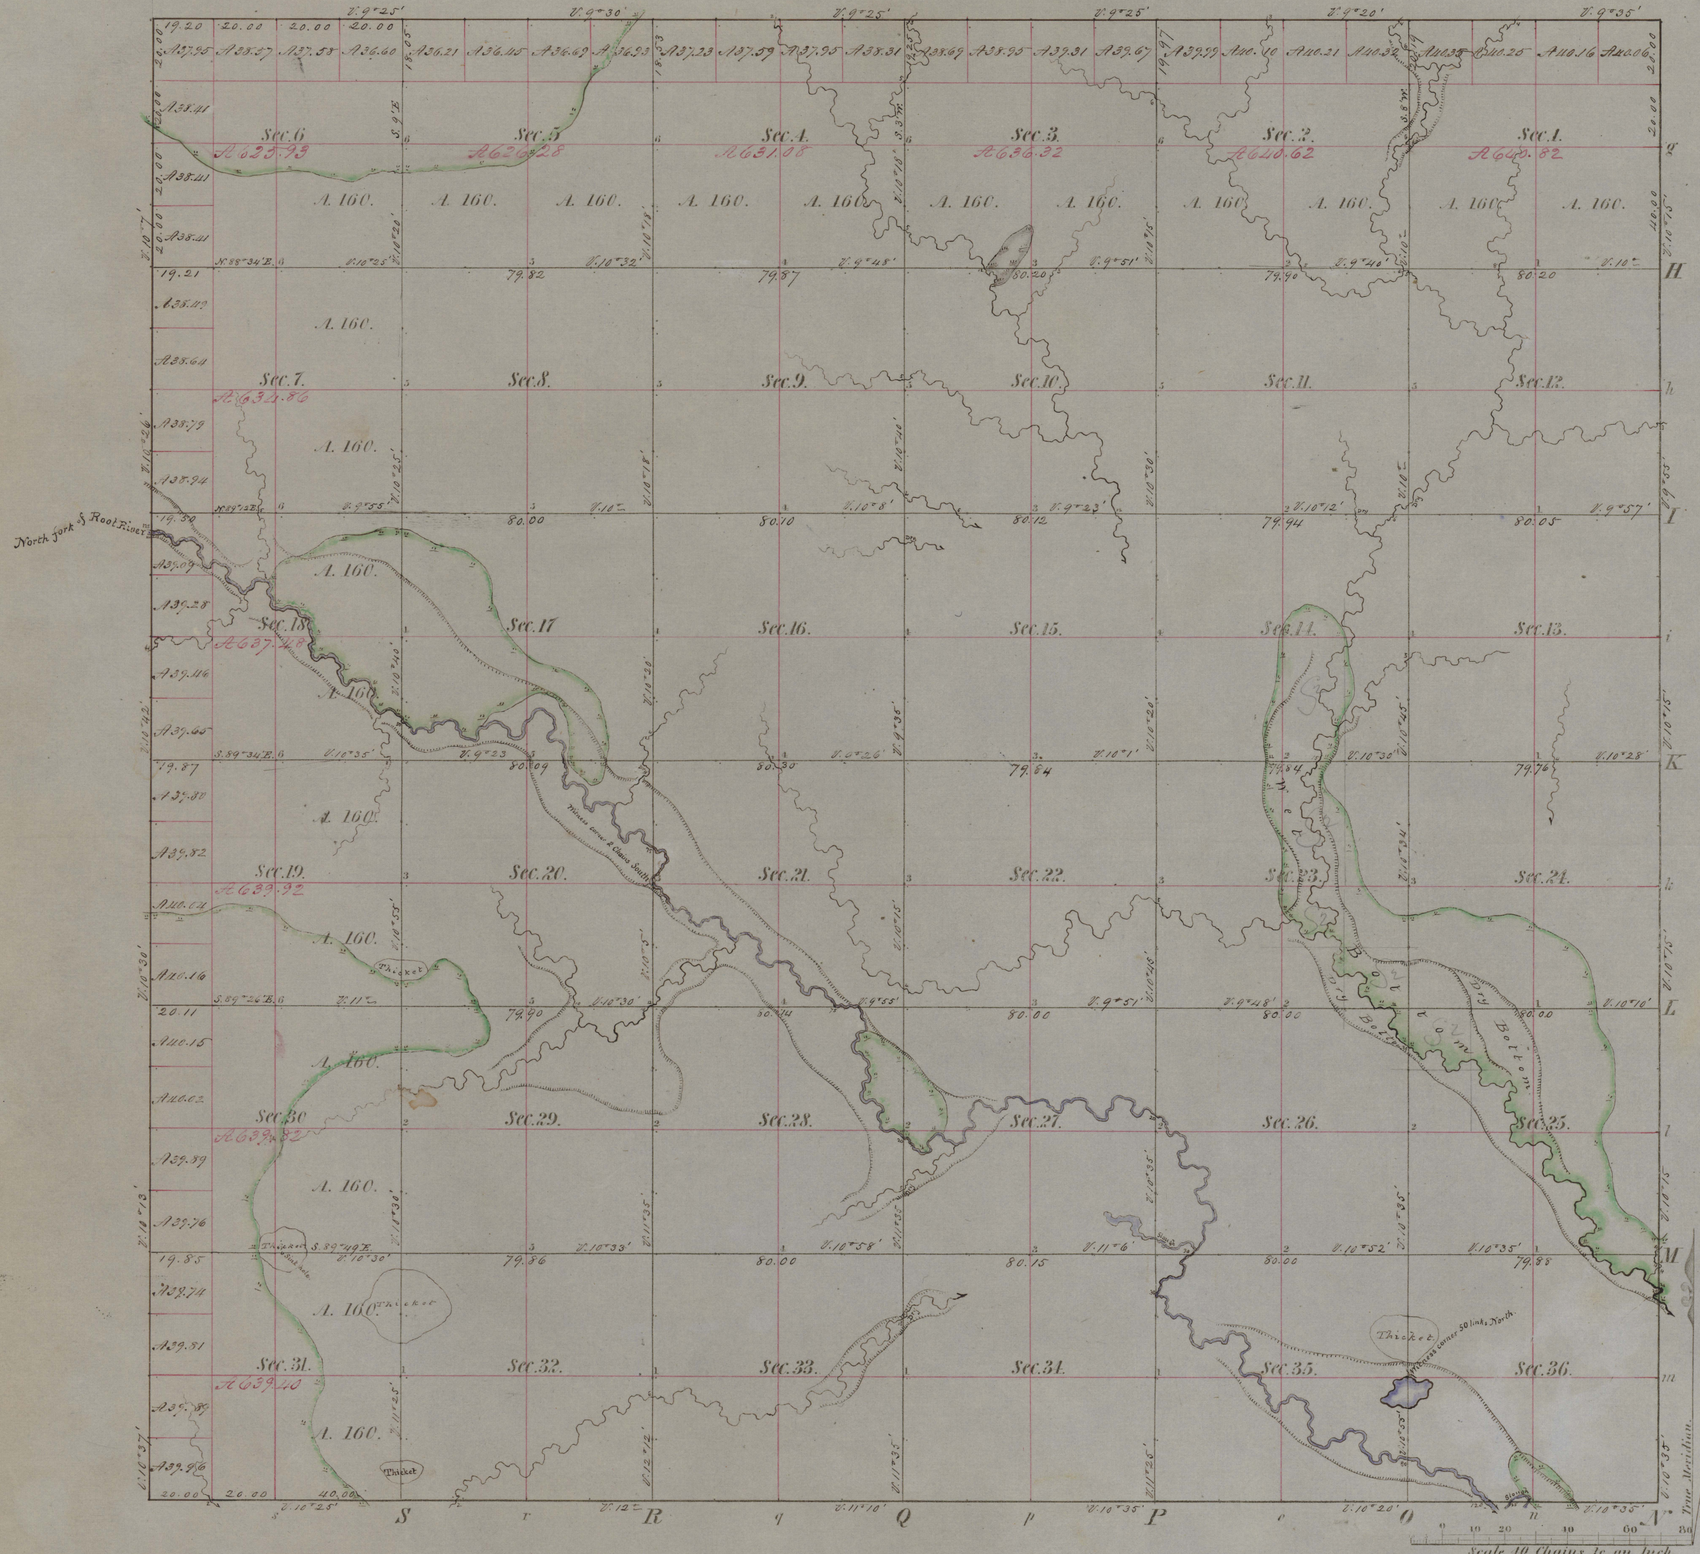

Meanders of								
Posts	Courses	Ch.s Lk.s	Posts	Courses	Ch.s Lk.s	Posts	Courses	Ch.s Lk.s

Total number of Acres. 22993.53

	Surveys Designated	By Whom Surveyed	Date of Contract	Amount of Surveys	When Surveyed	When p.d for and ch.d in the Sur.r Gen.ls acc.t
E. W. & N.	Township lines	John Ball	August 12th 1853	M. 17 Chs 79 Lks 20	September 1853.	
	Subdivisions	Wm. A. Jones	August 20th 1853	59 " 74 " 19	October 1853.	
S. Boundary	1st. Standard Parallel.	E. S. Morris	June 2nd. 1853.	6 " 00 " 00	September 1853.	

The above Map of Township No 105 North of Range No 12 West of the 5th. Principal Meridian Minnesota Territory is strictly conformable to the field notes of the survey thereof on file in this Office, which have been examined and approved.

Surveyor Generals Office.
Dubuque, March 30th. 1854.

Warren Lewis
Sur.r Gen.l