
Township No. 105 N., Range No. 14 West 5th Mer:

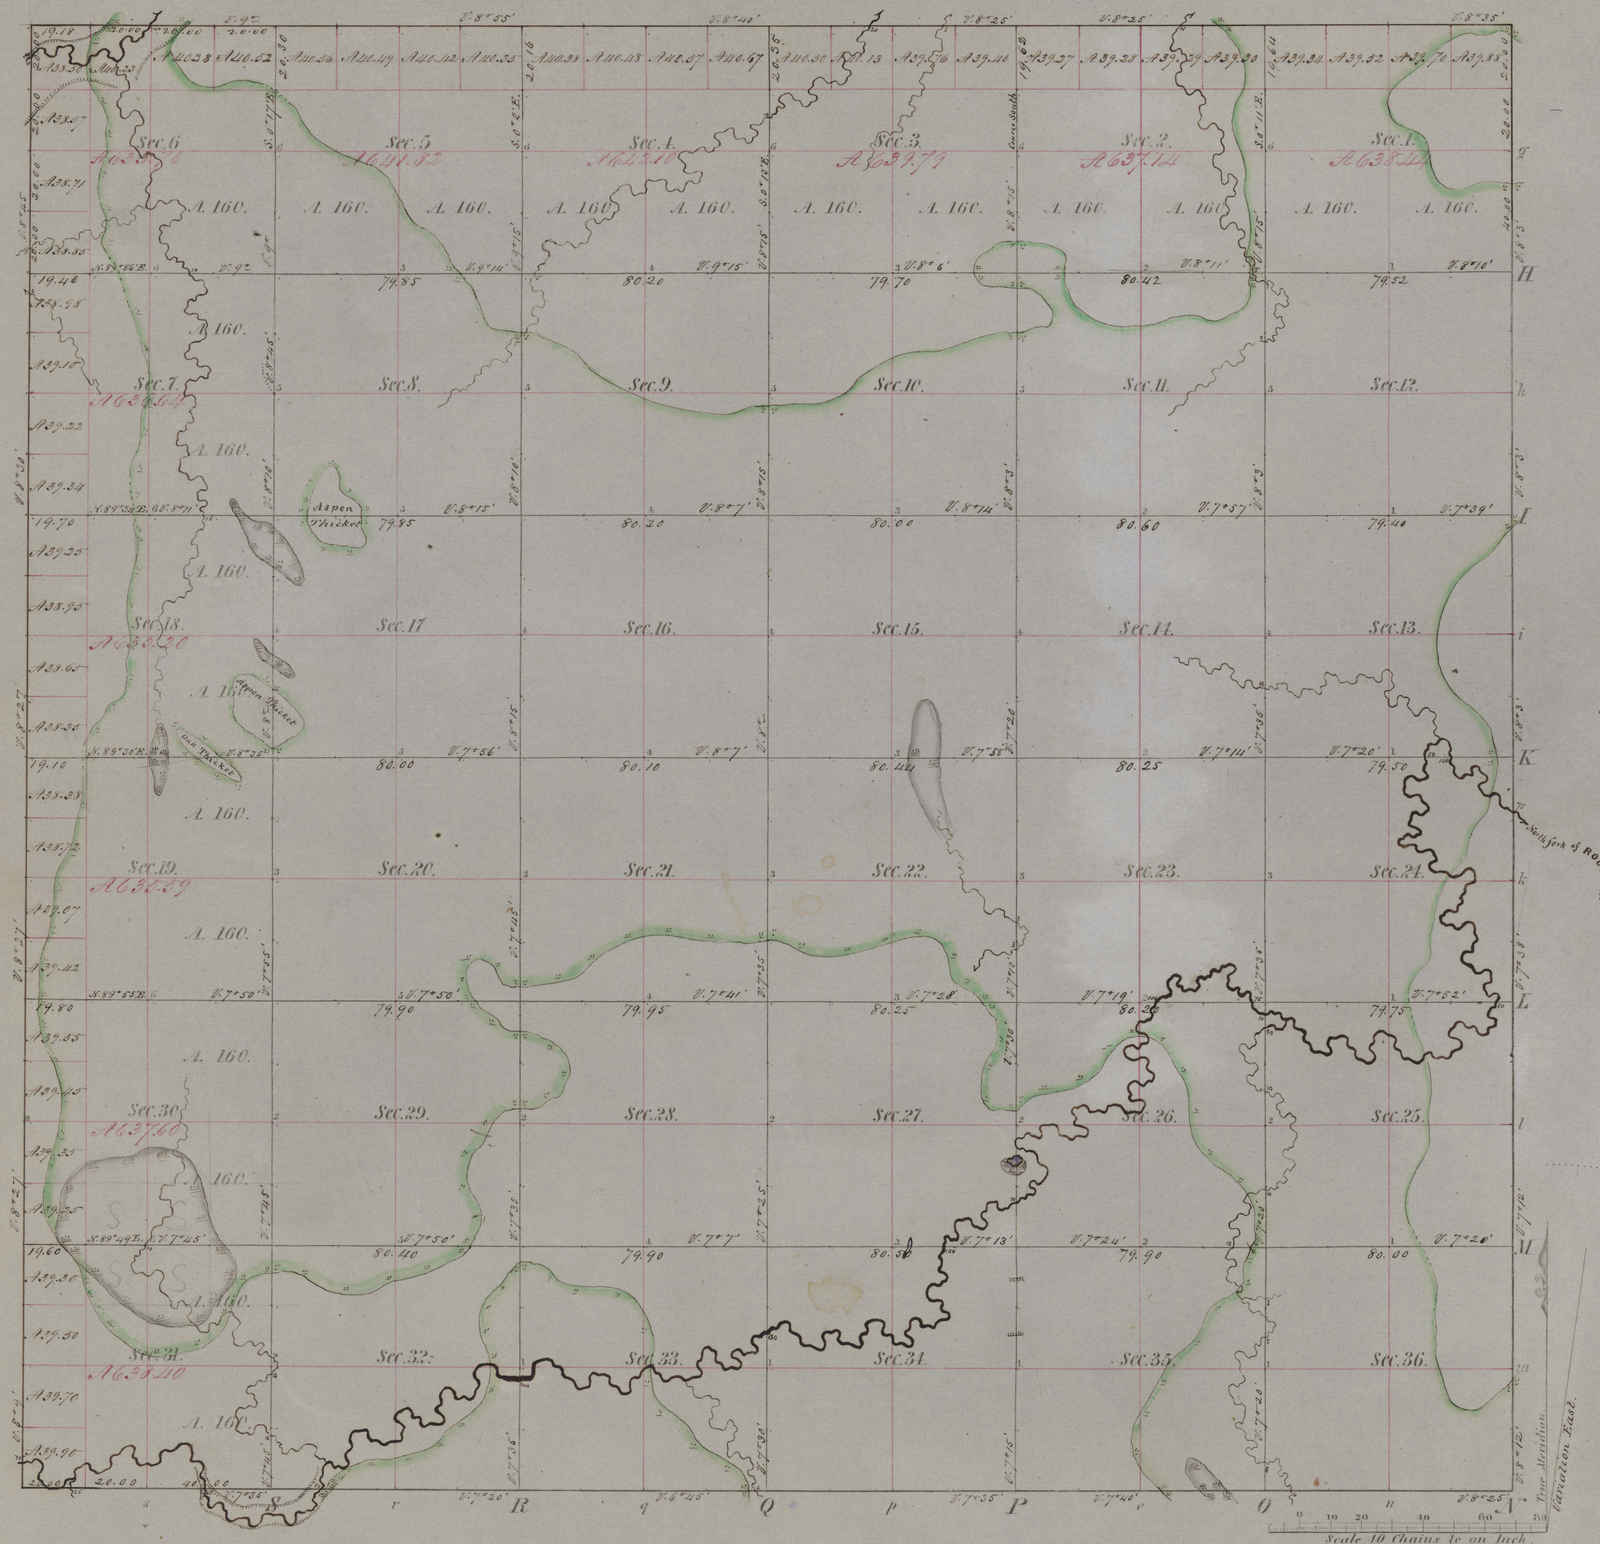

Meanders of

Posts	Courses	Ch.Lks	Posts	Courses	Ch.Lks	Posts	Courses	Ch.Lks

Total number of Acres 23018.45

	Surveys Designated	By Whom Surveyed	Date of Contract	Amount of Surveys	When Surveyed	When pd for and ch.d in the Sur. Gen.ls acc.t
E.W&N.	Township lines	John Ball	August 12th 1853	M. 17 - Chs 79 - Lks 18.	October, 1853.	
	Subdivisions	Wm. B. Yerby	October, 20th 1853	59 - 78 - 51	Oct & Nov. 1853.	
S. Boundary	1st. Standard Parallel	E. S. Norris	June 2nd. 1853	6 - 00 - 00	September 1853.	

The above Map of Township No 105 North of Range No 14 West of the 5th. Principal Meridian Minnesota Territory is strictly conformable to the field notes of the survey thereof on file in this Office, which have been examined and approved.

Surveyor Generals Office
Dubuque, August 5th 1854

Warner Lewis
Sur. Gen.l