
Township No. 105 N; Range No. 15 West of the 5th Mer.

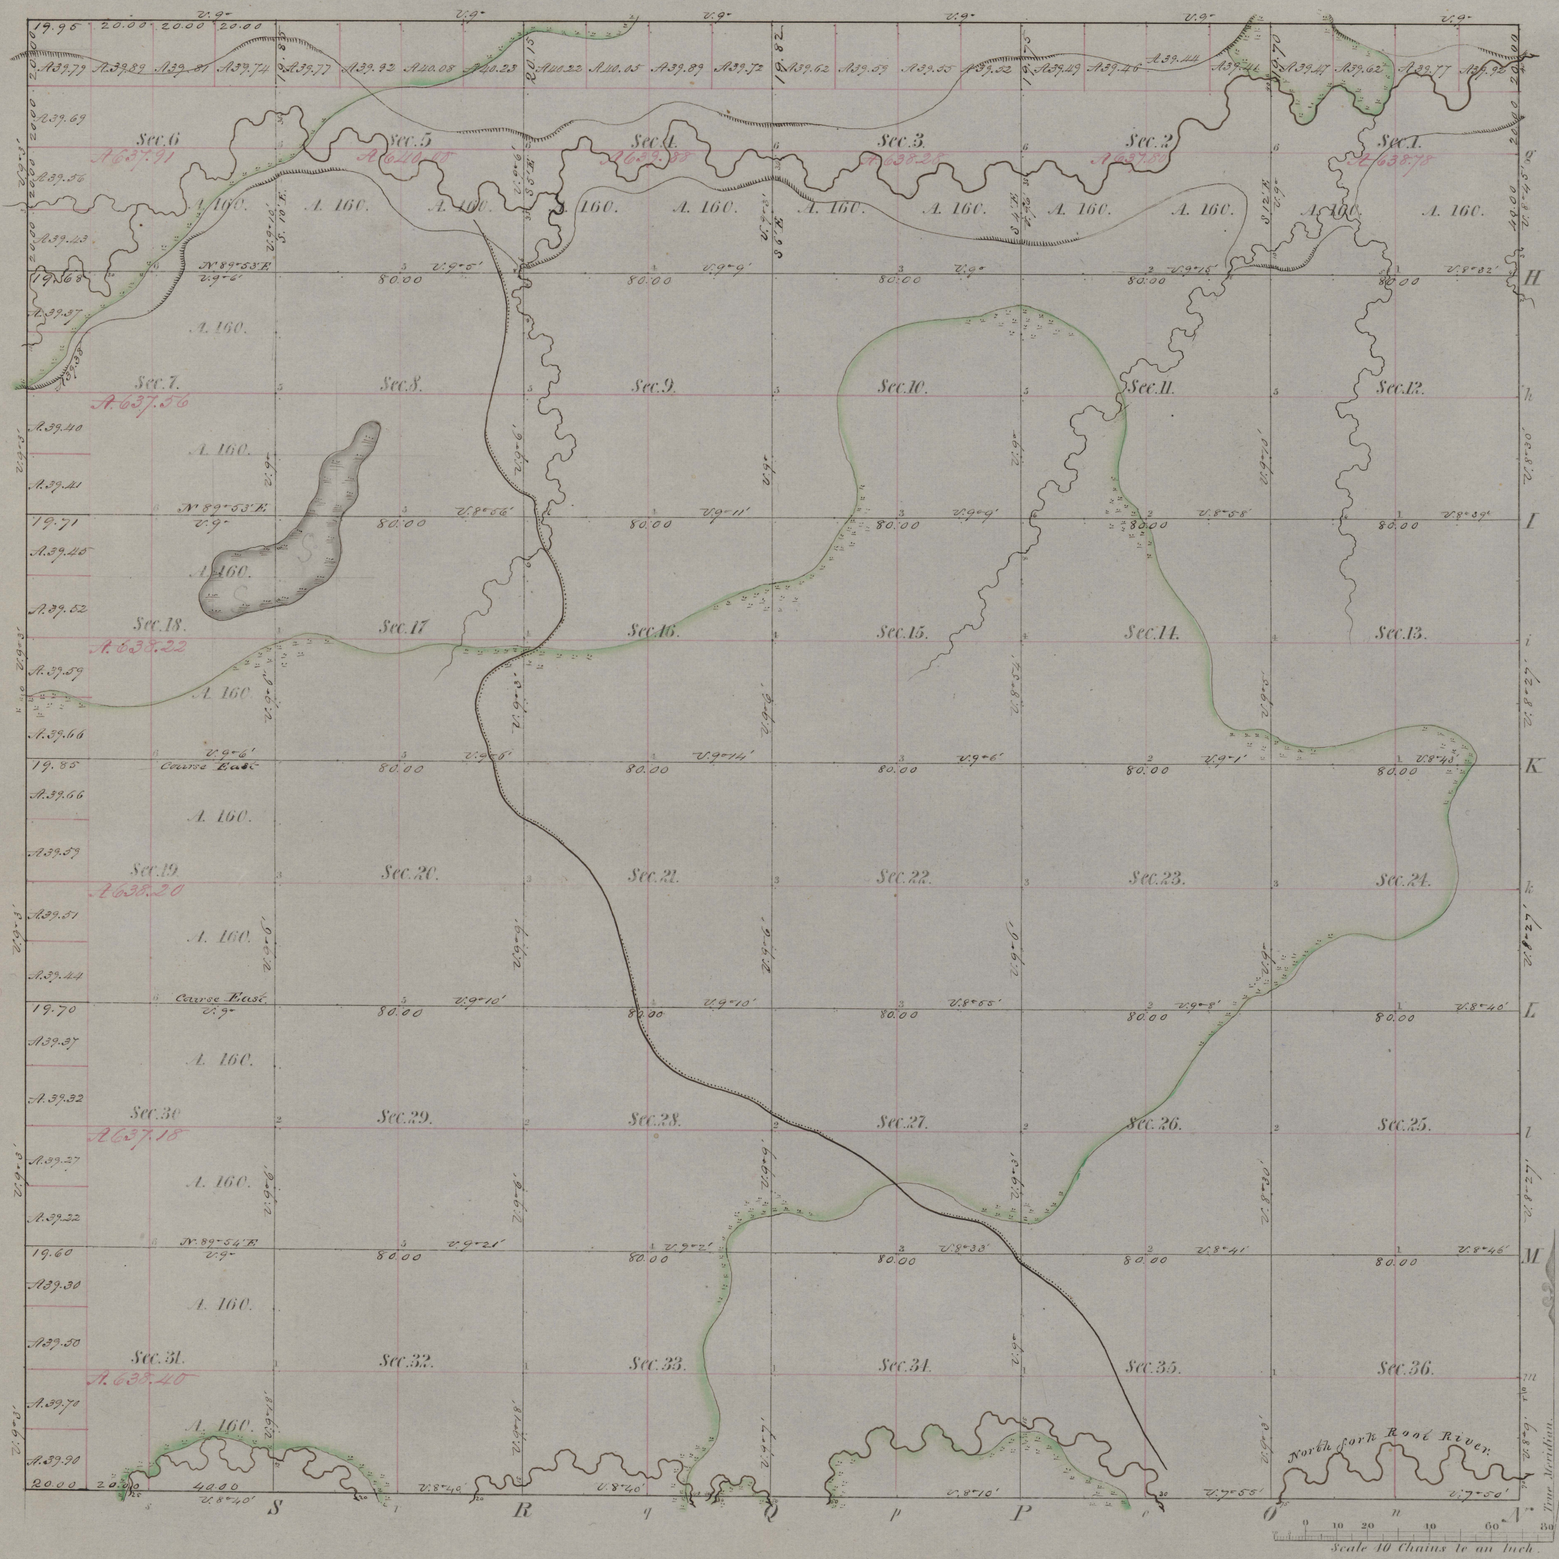

Meanders of

Posts	Courses	Ch.s Lk.s	Posts	Courses	Ch.s Lk.s	Posts	Courses	Ch.s Lk.s

Total number of Acres. 23122.21

	Surveys Designated	By Whom Surveyed	Date of Contract	Amount of Surveys	When Surveyed	When p.d for and ch.s in the Sur.r Gen.ls acc.t
R.N.W.	Township lines	John Ball	August 12th 1853	M. 23. Ch.s 79. Lk.s 95	October 1853	
	Subdivisions	M.G. Harrick	May 3d 1854	59 . 77 . 81	May 1854	
S	Township lines	C.S. Norris	June 2d 1853	6. 00. 00	Sept.r 1853	

The above Map of Township No. 105 N of Range No. 15 West of the 5th Principal Meridian Minnesota is strictly conformable to the field notes of the survey thereof on file in this Office, which have been examined and approved.

Surveyor General's Office.
Dubuque July 21st 1854

Warner Lewis
Sur.r Gen.l