
Township N.o 106 N: Range N.o 11 West, 5th Mer:

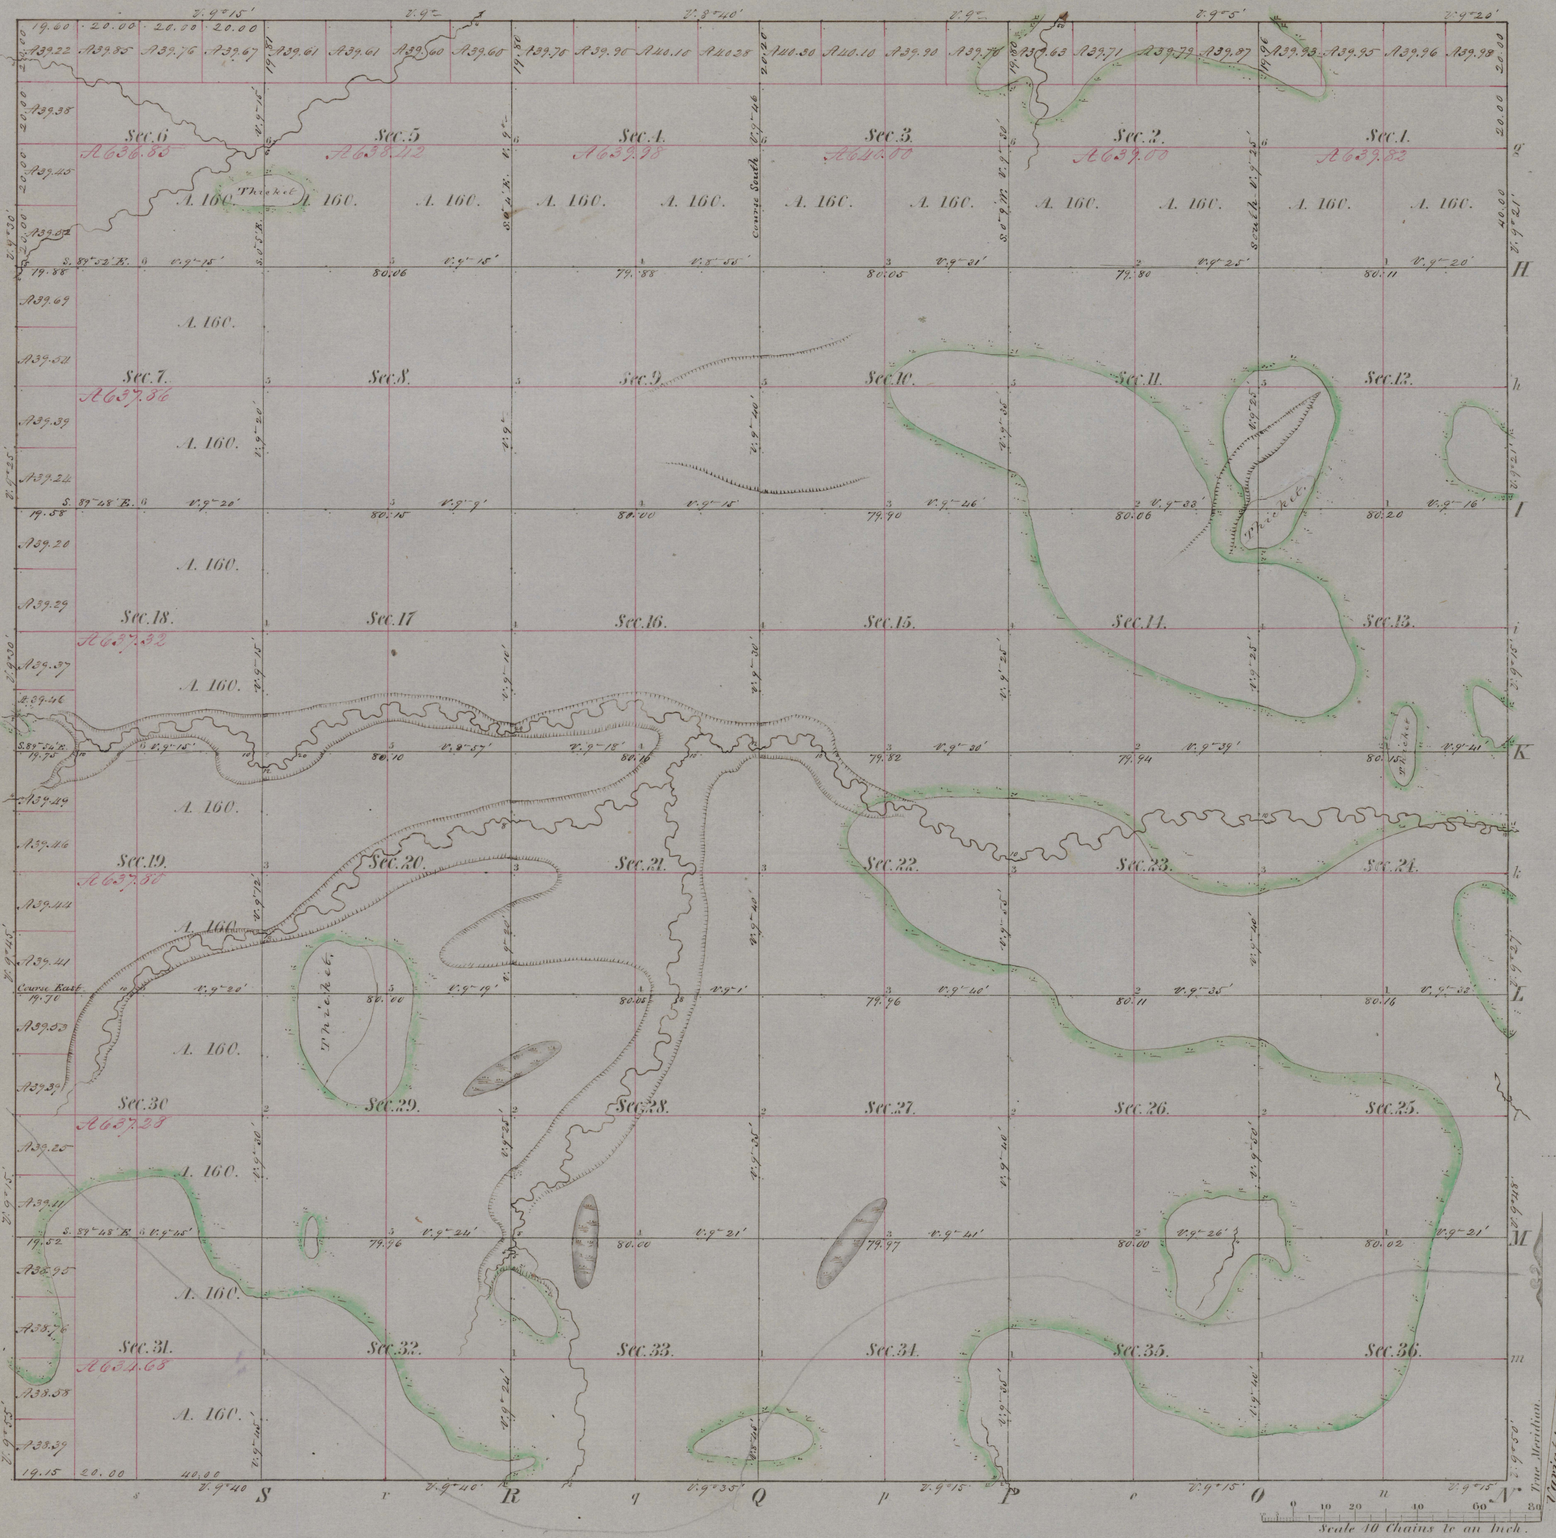

Total number of Acres. 23019.01

	Surveys Designated	By Whom Surveyed	Date of Contract	Amount of Surveys	When Surveyed	When p.d for and ch.d in the Sur.r Gen.ls acc.t
S.W.⅓N.	Township lines	John Ball	August 12.th 1853	M. 17, Chs. 78. lks. 75	September 1853	
	Subdivisions	Wm. A. Jones	August 20.th 1853	59. 78. 55.	October 1853	
E.	Township line	E. A. Norris	June 2.d 1853	6. 00. 00.	June 1853	

The above Map of Township N.o 106 North, of Range N.o 11 West, of the 5th Principal Meridian, Minnesota is strictly conformable to the field notes of the survey thereof on file in this Office, which have been examined and approved.

Surveyor Generals Office.
Dubuque, March 30th. 1854.

Warner Lewis
Sur.r Gen.l

Meanders of								
Posts	Courses	Ch.s Lk.s	Posts	Courses	Ch.s Lk.s	Posts	Courses	Ch.s Lk.s