
Township N.o 106 N., Range N.o 12 West 5th. Mer.

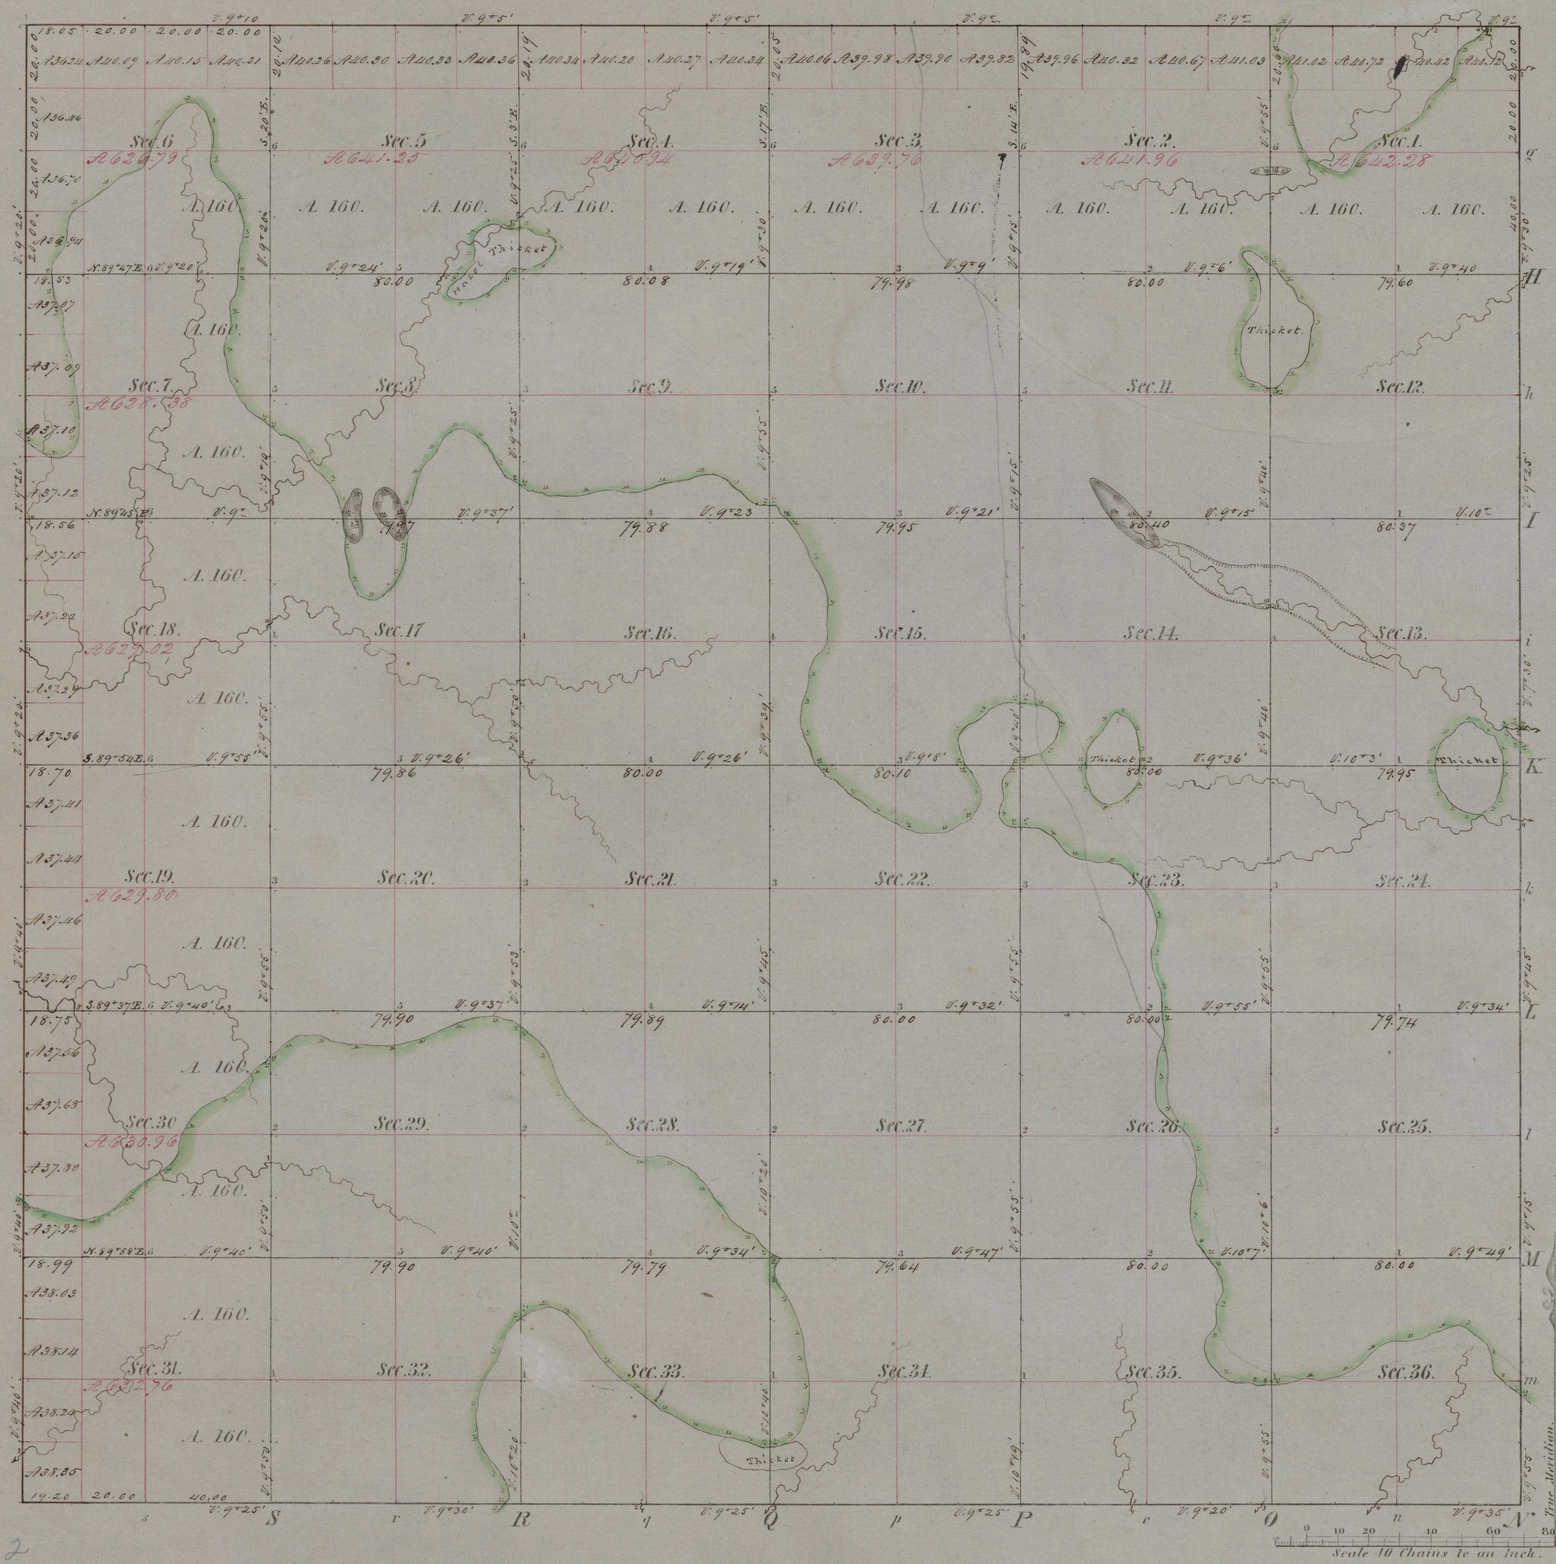

Total number of Acres. 23983.90

Surveys Designated	By Whom Surveyed	Date of Contract	Amount of Surveys	When Surveyed	When p.d for and ch.d in the Sur.r Gen.ls acc.t
Township lines	John Ball	August 12th. 1853	M. Ch.s Lks. 23 . 77 . 25	September 1853.	
Subdivisions	Wm. A. Jones	August 20th. 1853	59 . 73 . 38	October, 1853.	

The above Map of Township N.o 106 North of Range N.o 12 West of the 5th. Principal Meridian Minnesota Territory is strictly conformable to the field notes of the survey thereof on file in this Office, which have been examined and approved.

Surveyor Generals Office,
Dubuque, March 30th. 1854.

Warren Lewis
Sur.r Gen.l

Meanders of

Posts	Courses	Ch.s Lk.s	Posts	Courses	Ch.s Lk.s	Posts	Courses	Ch.s Lk.s