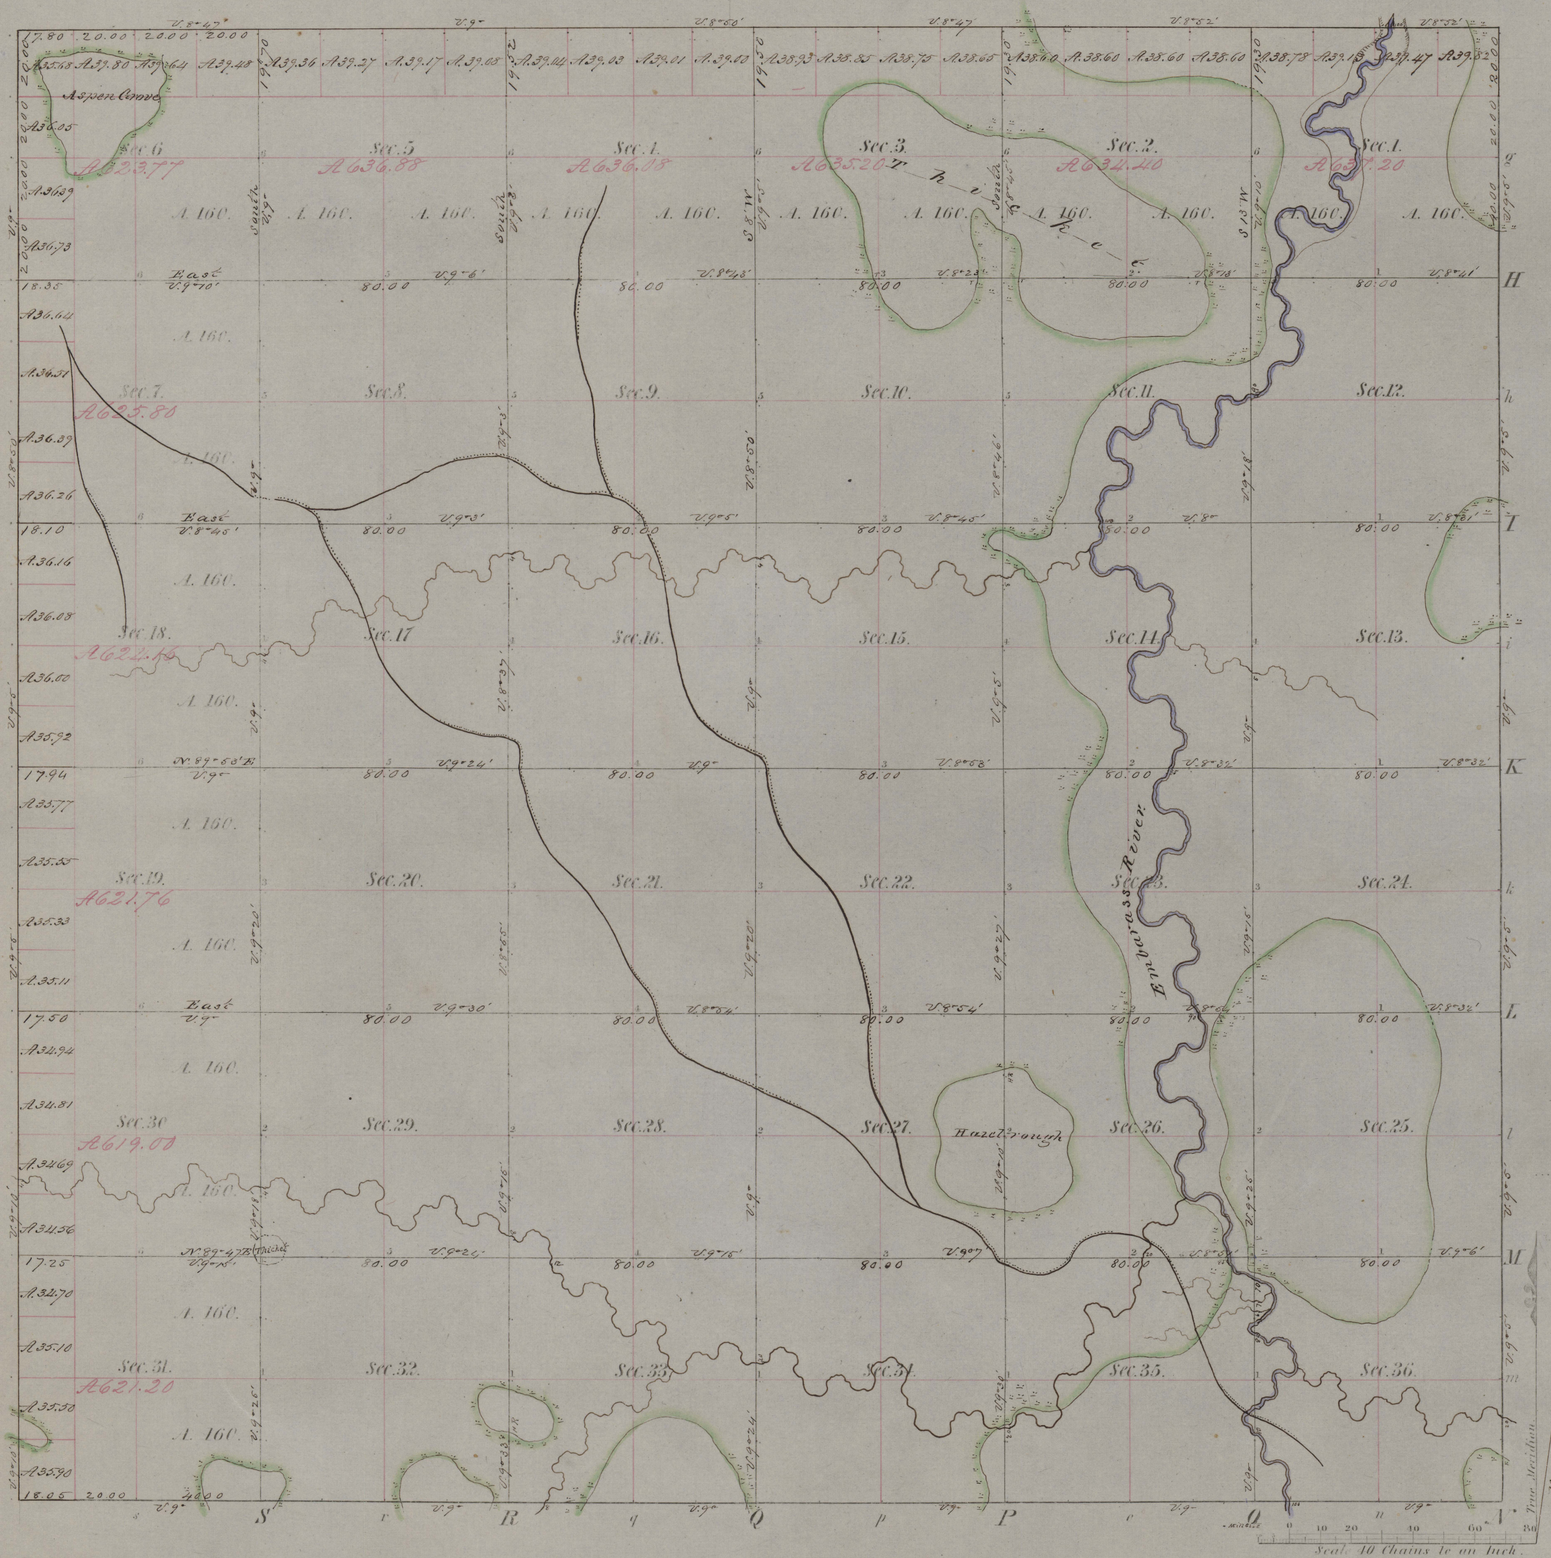
Township No. 107 N; Range No. 14 West of the 5th Mer.


Aspen Grove
Sec.6 A623.77
Sec.5 A636.88
Sec.4. A636.15
Sec.3. A635.20
Sec.2. A634.20
Sec.1. A633.20
Sec.7. A625.80
Sec.18. A622.45
Sec.19. A621.76
Sec.30 A619.01
Sec.31. A621.20
Hazel Grove
