
Township N.o 107 N; Range N.o 15 West 5th Mer:

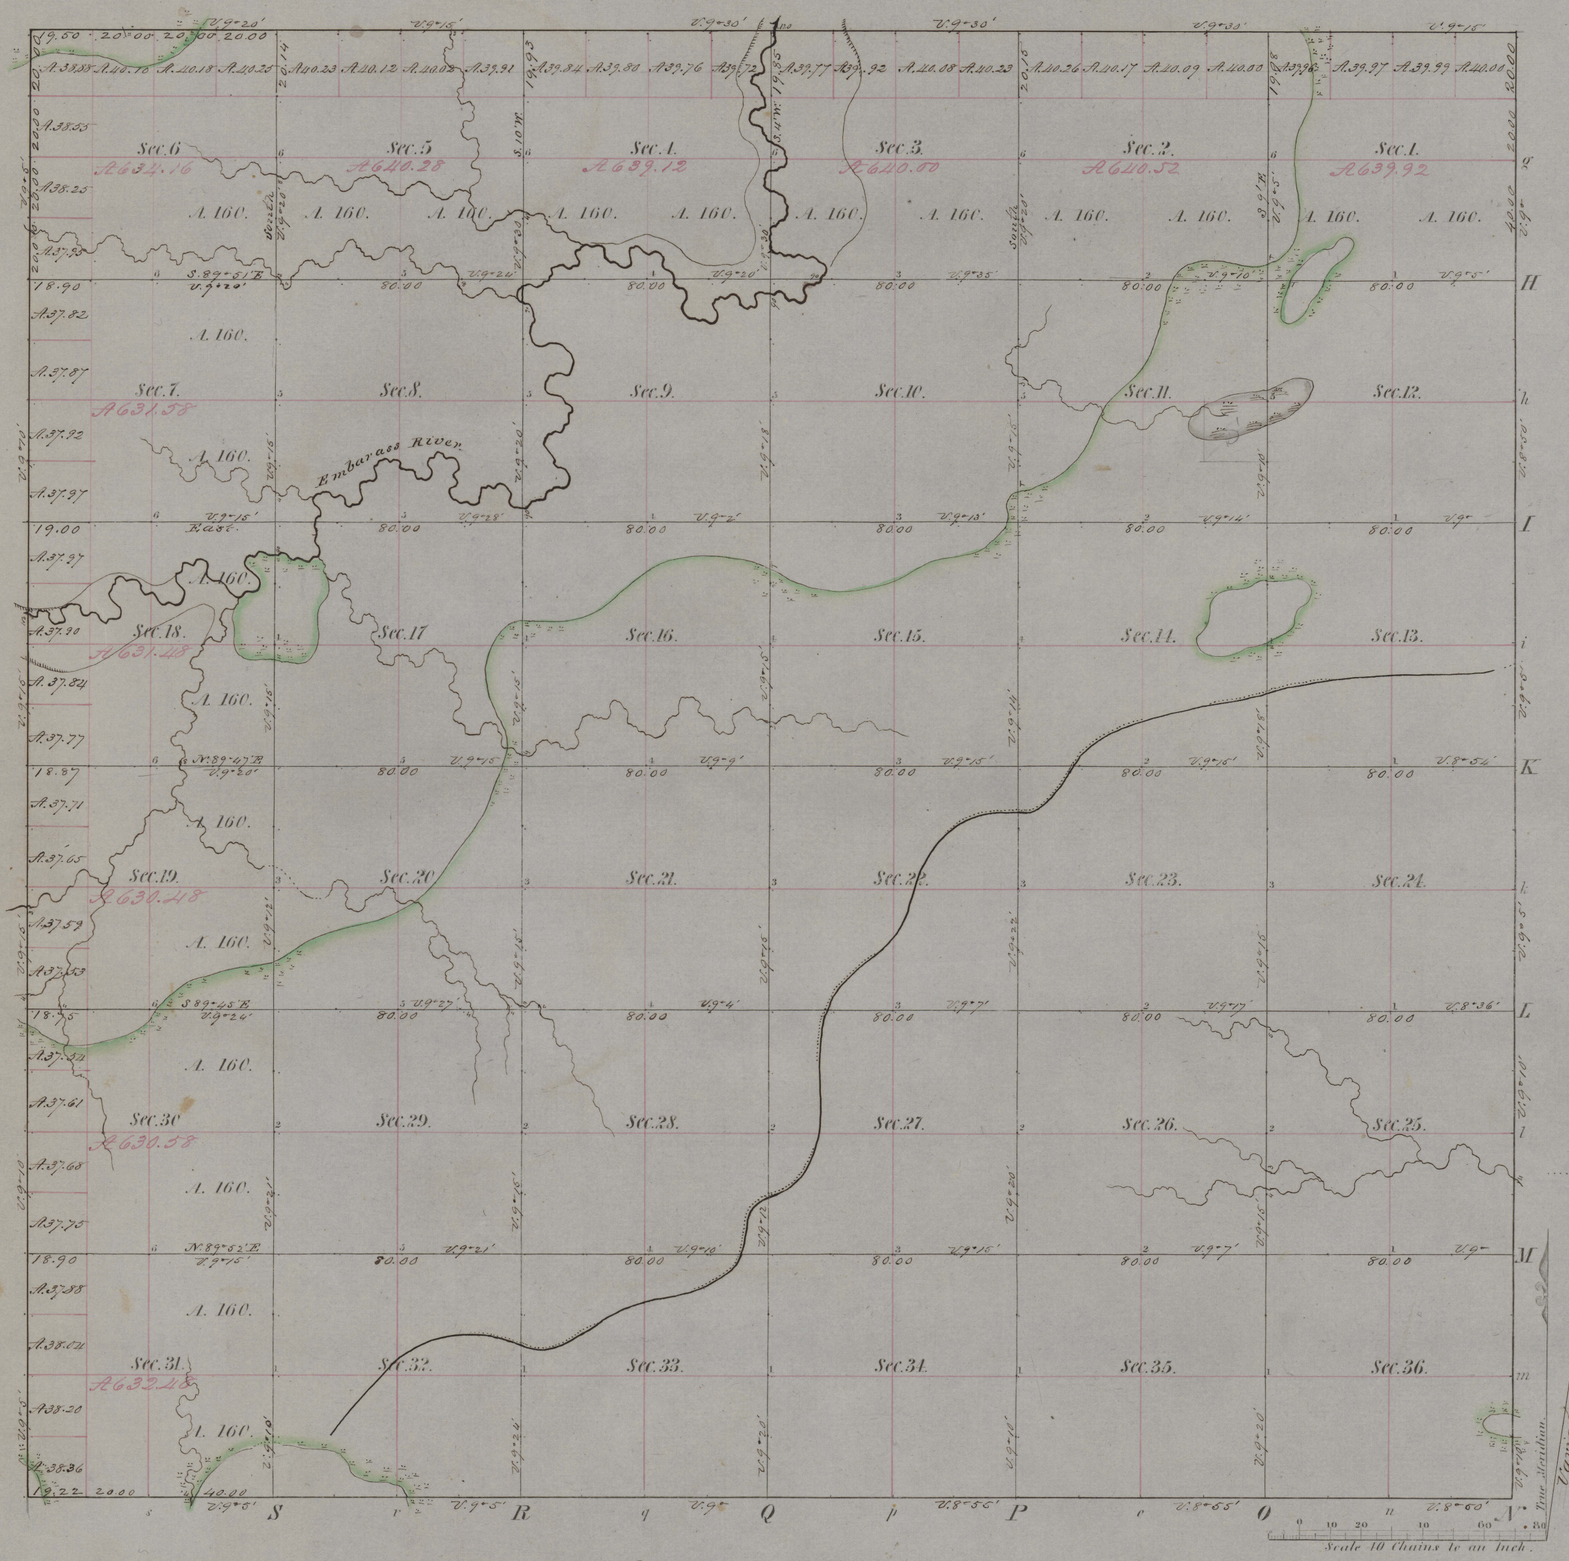

Total number of Acres. 22990.60

Surveys Designated	By Whom Surveyed	Date of Contract	Amount of Surveys	When Surveyed	When p.d for and ch.d in the Sur.r Gen.ls acc.t
Township lines	John Ball	August 15th 1853	M. Chs 23. 78. lks. 72	October 1853	
Subdivisions	M. D. Harriett	May 3. 1854	59. 74. 47	May & June 1854	

The above Map of Township N.o 107 N of Range N.o 15 West of the 5th Principal Meridian Minnesota is strictly conformable to the field notes of the survey thereof on file in this Office, which have been examined and approved.

Surveyor Generals Office.
Dubuque July 31st. 1854

Warren Foster
Sur.r Gen.l

Meanders of

Posts	Courses	Ch.s Lk.s	Posts	Courses	Ch.s Lk.s	Posts	Courses	Ch.s Lk.s