
Township No. 108 N. Range No. 13 West of the 5th Mer.

Meanders of

Posts	Courses	Ch.s Lk.s	Posts	Courses	Ch.s Lk.s	Posts	Courses	Ch.s Lk.s

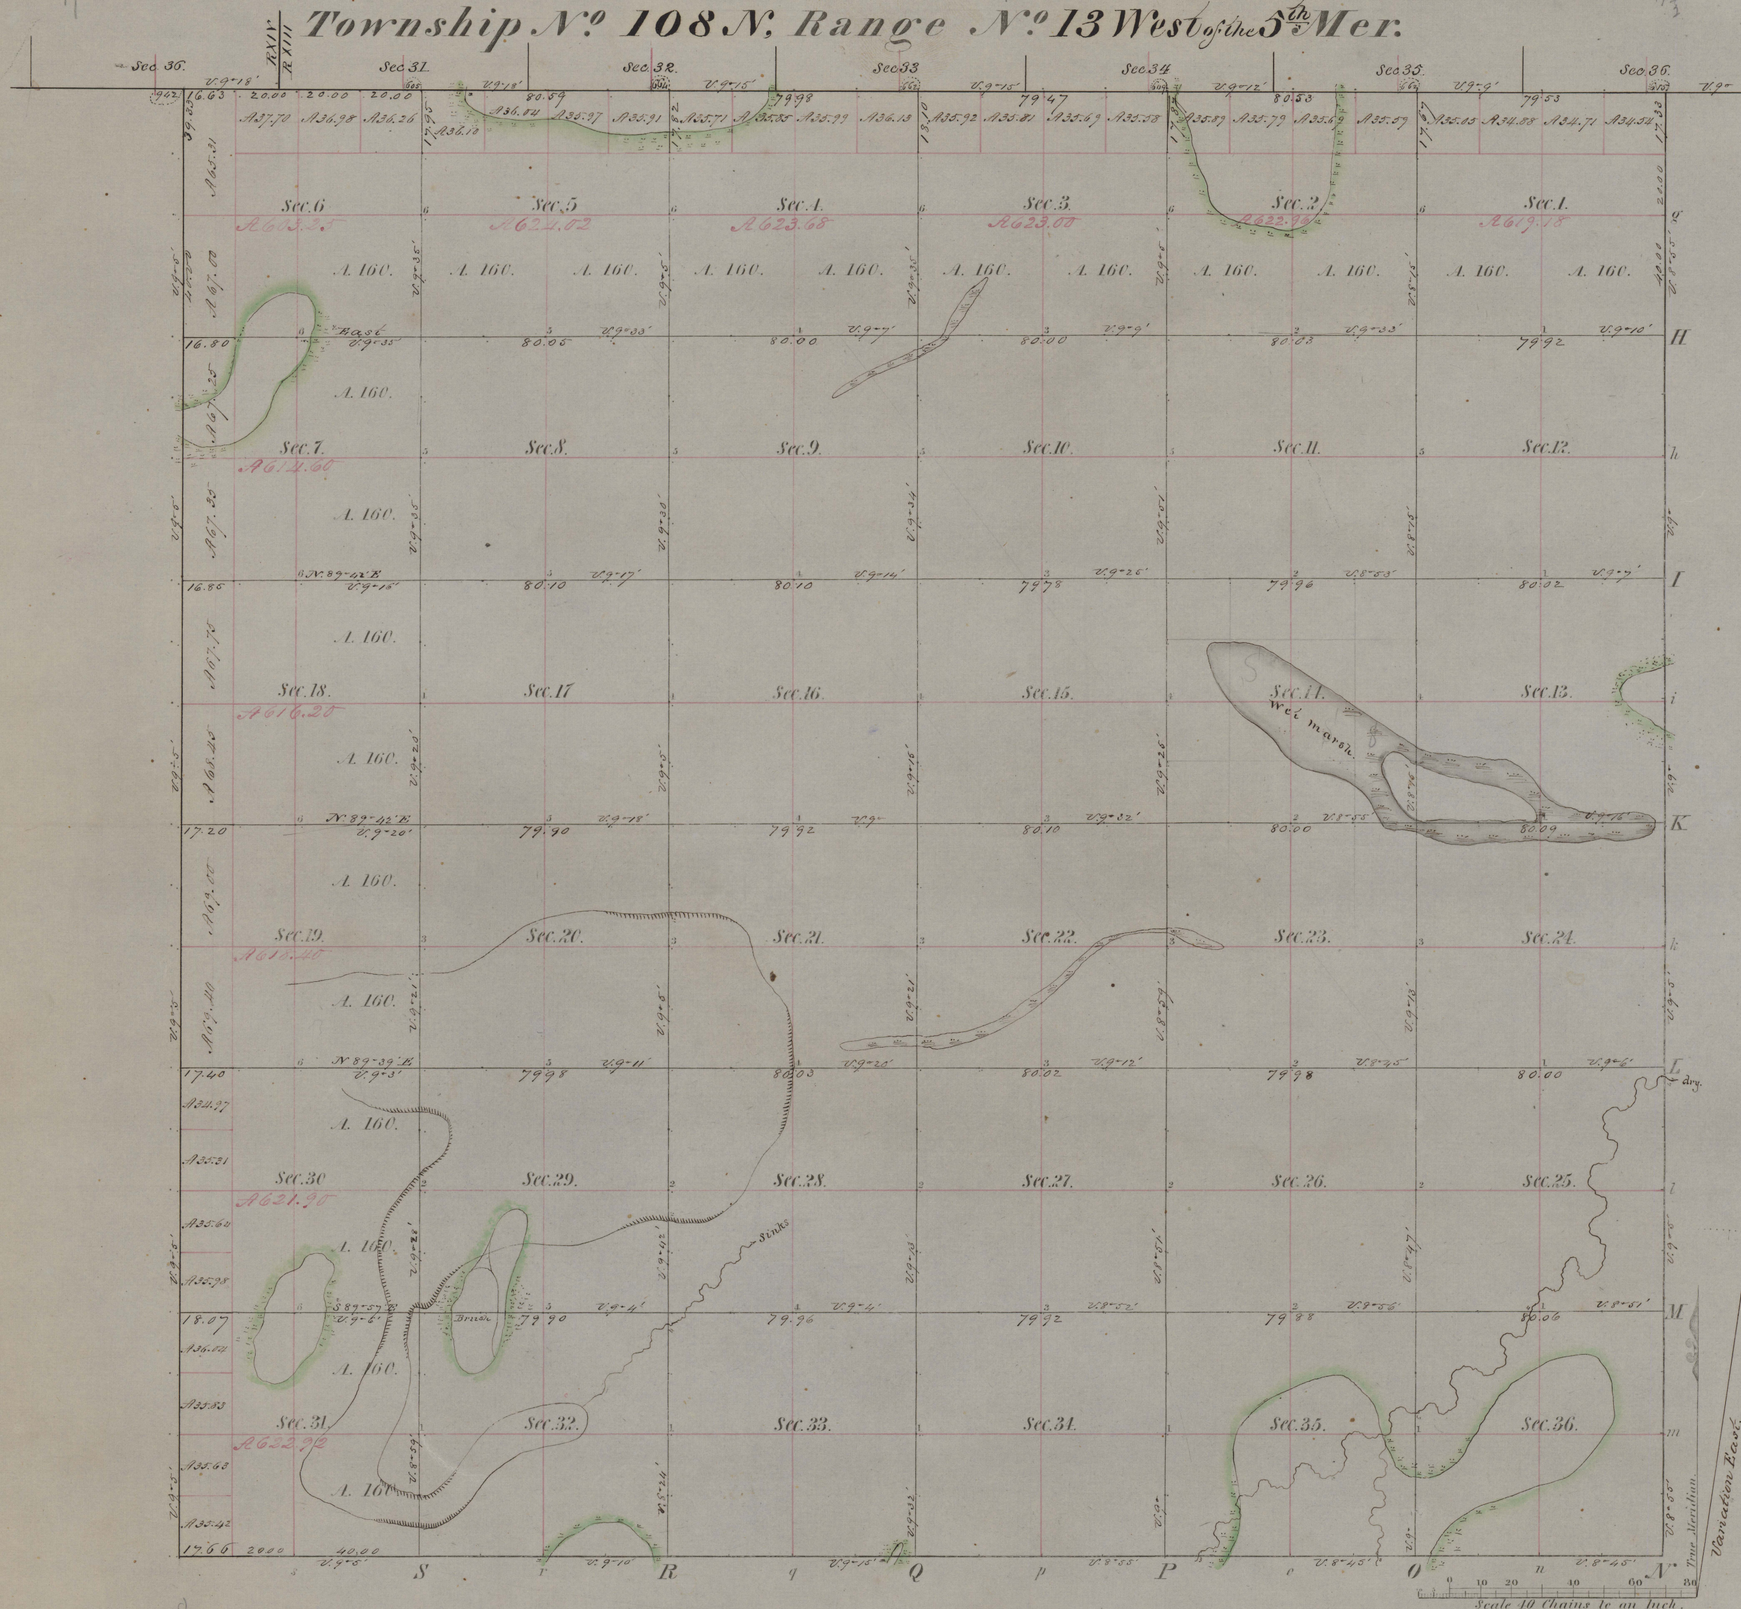

Total number of Acres. 22810.11

	Surveys Designated	By Whom Surveyed	Date of Contract	Amount of Surveys	When Surveyed	When p.d for and ch.d in the Sur.r Gen.ls acc.t
				M. Chs. Lks.		
E,S,W.	Township lines	John Ball	August 12.th 1853	17. 74. 32	October 1853	
	Subdivisions	Wm. B. Gerby	Octo. 20th 1853	59. 55. 43	May 1854	
N.	Township line	C. L. Norris	June 2.d 1853	5. 76. 73	September 1853	

The above Map, of Township No. 108 N. of Range No. 13 West of the 5th Principal Meridian Minnesota is strictly conformable to the field notes of the survey thereof on file in this Office, which have been examined and approved.

Surveyor General's Office,
Dubuque August 5th 1854

Warren Lewis
Sur.r Gen.l