
9

9½

Township N.o 108 N; Range N.o 14 West of the 5th Mer:

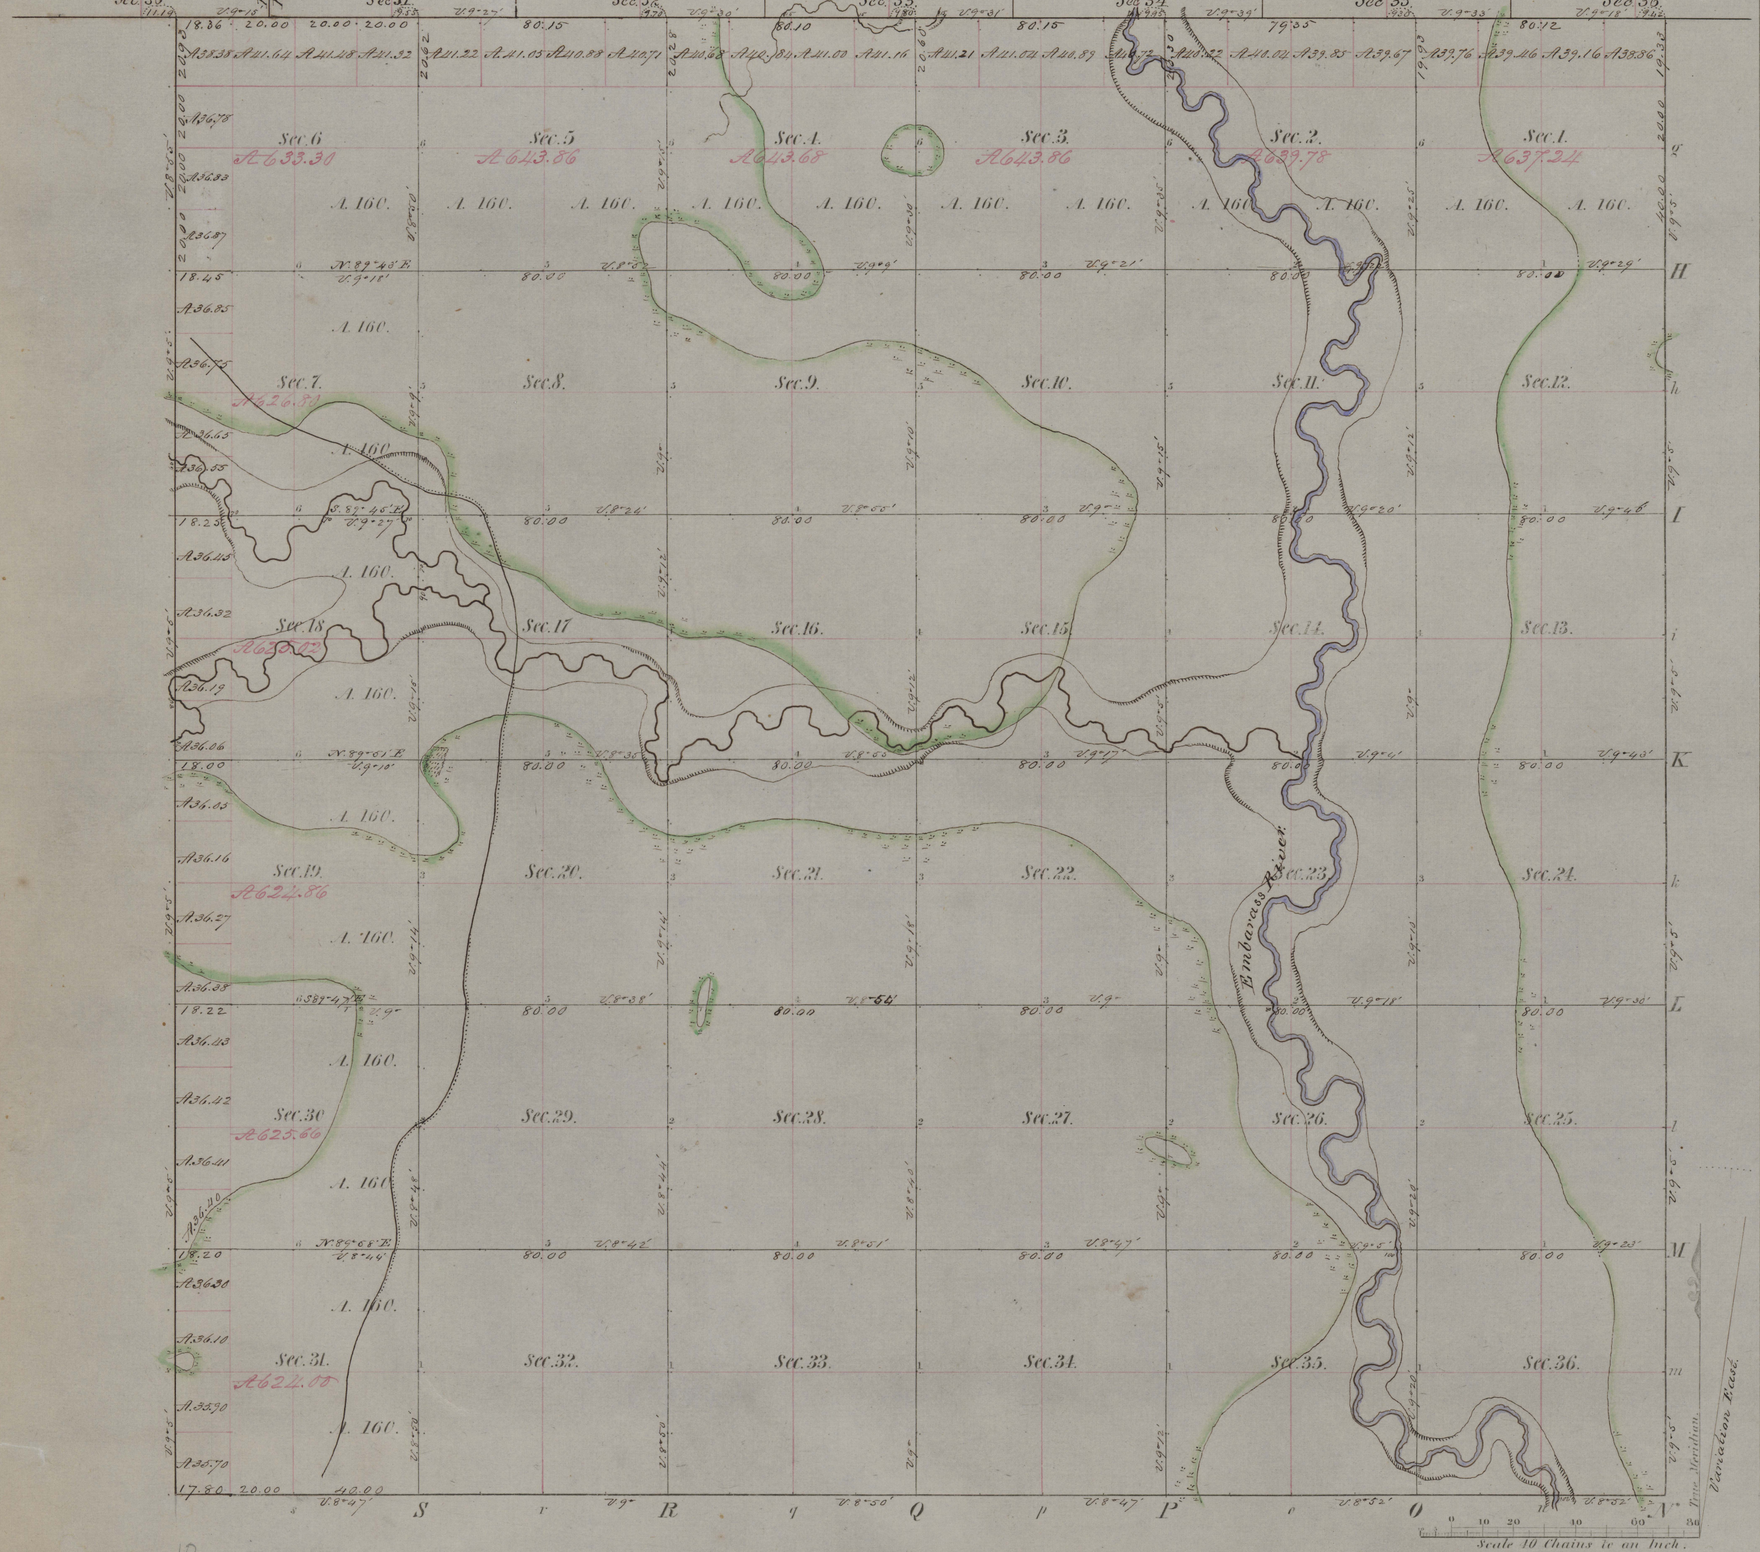

Meanders of								
Posts	Courses	Ch.s Lk.s	Posts	Courses	Ch.s Lk.s	Posts	Courses	Ch.s Lk.s

10

Total number of Acres. 22968.56

	Surveys Designated	By Whom Surveyed	Date of Contract	Amount of Surveys M. Ch.s Lks.	When Surveyed	When p.d for and ch.d in the Sur.r Gen.ls acc.t
E. S. & W.	Township lines	John Ball	August 12th 1853	17.78.66	October 1853	
	Subdivisions	M. G. Harrick	May 3.d 1854	59.72.85	June & July 1854	
N	Township lines	E. C. Norris	June 2.d 1853	5.78.23	Sept.r 1853	

The above Map of Township N.o 108 North of Range N.o 14 West of the 5th Principal Meridian Minnesota is strictly conformable to the field notes of the survey thereof on file in this Office, which have been examined and approved.

Surveyor Generals Office,
Dubuque 21st July 1854

Warren Lewis
Sur.r Gen.l