
Township No. 108 N., Range No. 15 West of the 5th Mer.

R. XVI — R. XIV.

Sec. 36 | Sec. 31 | Sec. 32 | Sec. 33 | Sec. 34 | Sec. 35 | Sec. 36

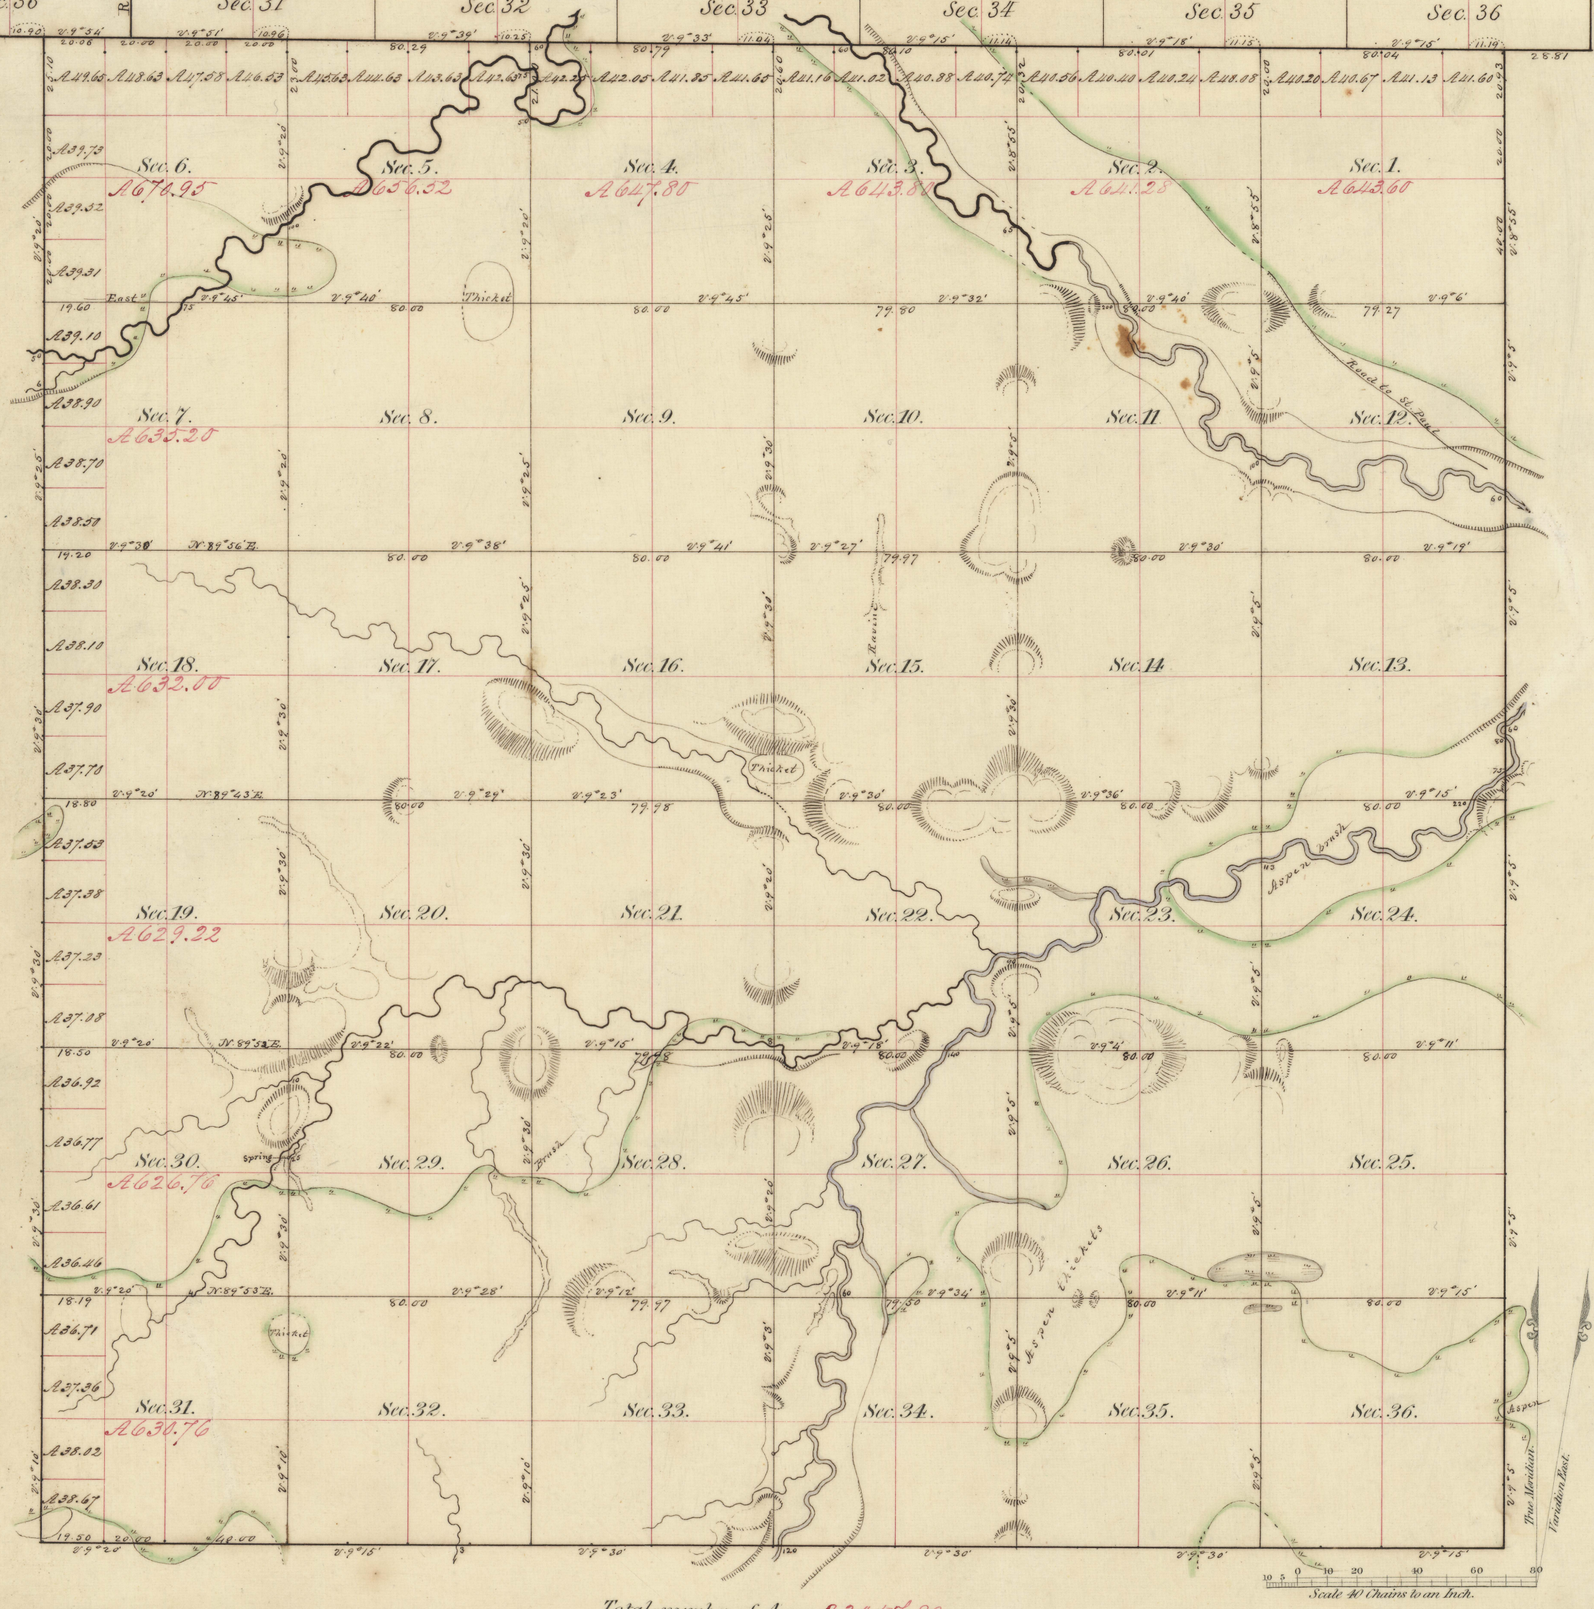

Meanders of

Posts	Courses	Ch.s Lk.s	Posts	Courses	Ch.s Lk.s	Posts	Courses	Ch.s Lk.s

Total number of Acres 23057.89

	Surveys Designated.	By Whom Surveyed	Date of Contract.	Amount of Surveys M. Ch.s Lk.s	When Surveyed.	When Charged in the Sur.r Gen.ls Acc.t
E. S. & W.	Township lines.	John Ball	Aug. 12th 1853	18 - 5 - 53	October, 1853	
North	" "	E. S. Norris	June 2nd 1853	6 - 00 - 29	September, 1853	
	Subdivisions.	J. M. Cushing	May 1st 1854	59 - 77 - 68	June & Aug. 1854	

The above Map of Township No. 108 N. of Range No. 15 West, 5th Principal Meridian Minnesota is strictly conformable to the field notes of the survey thereof on file in this Office which have been examined and approved.

Surveyor Generals Office
Dubuque, Febry 22d 1855

Warner Lewis
Sur.r Gen.l