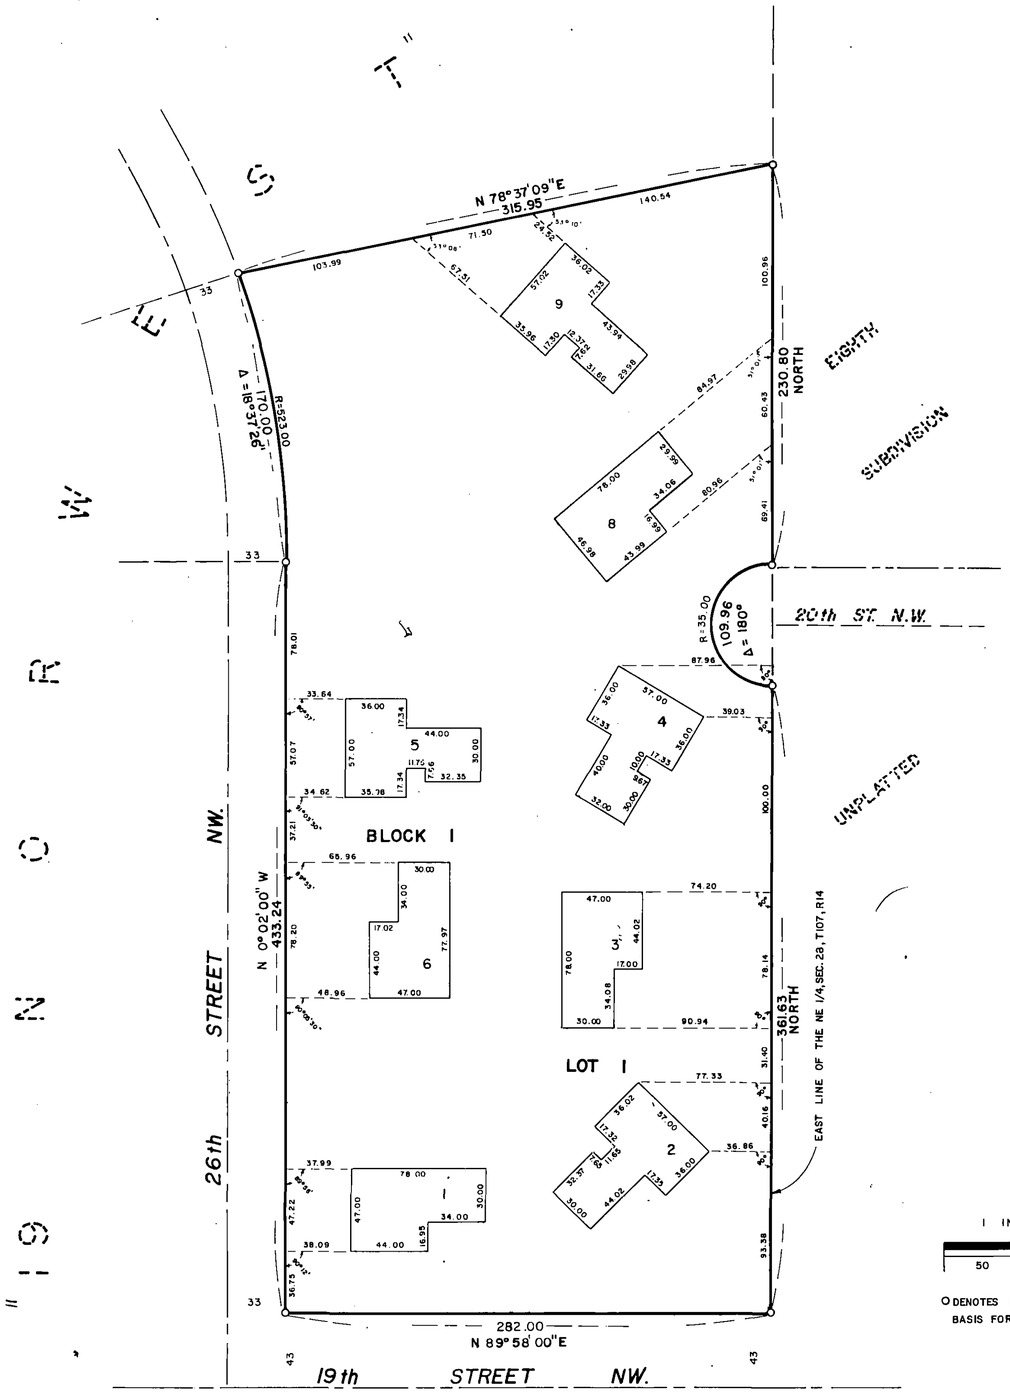


SCALE
1 INCH = 50 FEET
50 50 50

O DENOTES IRON MONUMENT
BASIS FOR BEARING IS ASSUMED

APARTMENT OWNERSHIP NUMBER 15

19 NORWEST CONDOMINIUM
THE CHARLES SECTION

CERTIFICATE:

The undersigned, being first duly sworn, under oath certifies and deposes that this plat of APARTMENT OWNERSHIP NUMBER 15, 19 NORWEST CONDOMINIUM, THE CHARLES SECTION, being located in Lot 1, Block 1, 19 Norwest, according to the recorded plat thereof, fully and accurately depicts the location and dimensions of buildings one (1), two (2), three (3), four (4), five (5), six (6), eight (8), and nine (9) as built, and that said buildings conform to the floor plans for 19 Norwest Condominium, The Charles Section, as recorded as document no. 352850.

James E. Boerhave
James E. Boerhave, Land Surveyor
Minnesota Reg. No. 7095

STATE OF MINNESOTA)
) ss.
COUNTY OF HENNEPIN)

Subscribed and sworn to before me a Notary Public this 8th day of FEBRUARY, 1974 A.D.

Lawrence J. Gardner
Notary Public

My Commission Expires: SEPT. 10, 1975

LAWRENCE J. GARDNER
Notary Public, Hennepin County, Minn.
My Commission Expires Sept. 10, 1975.


353851

PROOFED
GRANTOR
GRANTEE
TRACKED
PAID
CHG:

State of Minnesota } ss.
County of Hennepin }
I hereby certify that the within instrument was filed in this office for record on

FEB 8 - 1974

at 12 o'clock M
Book X-3 of Misc. on page 921
Harry G. Swanson, Register of Deeds
By Dan Smith

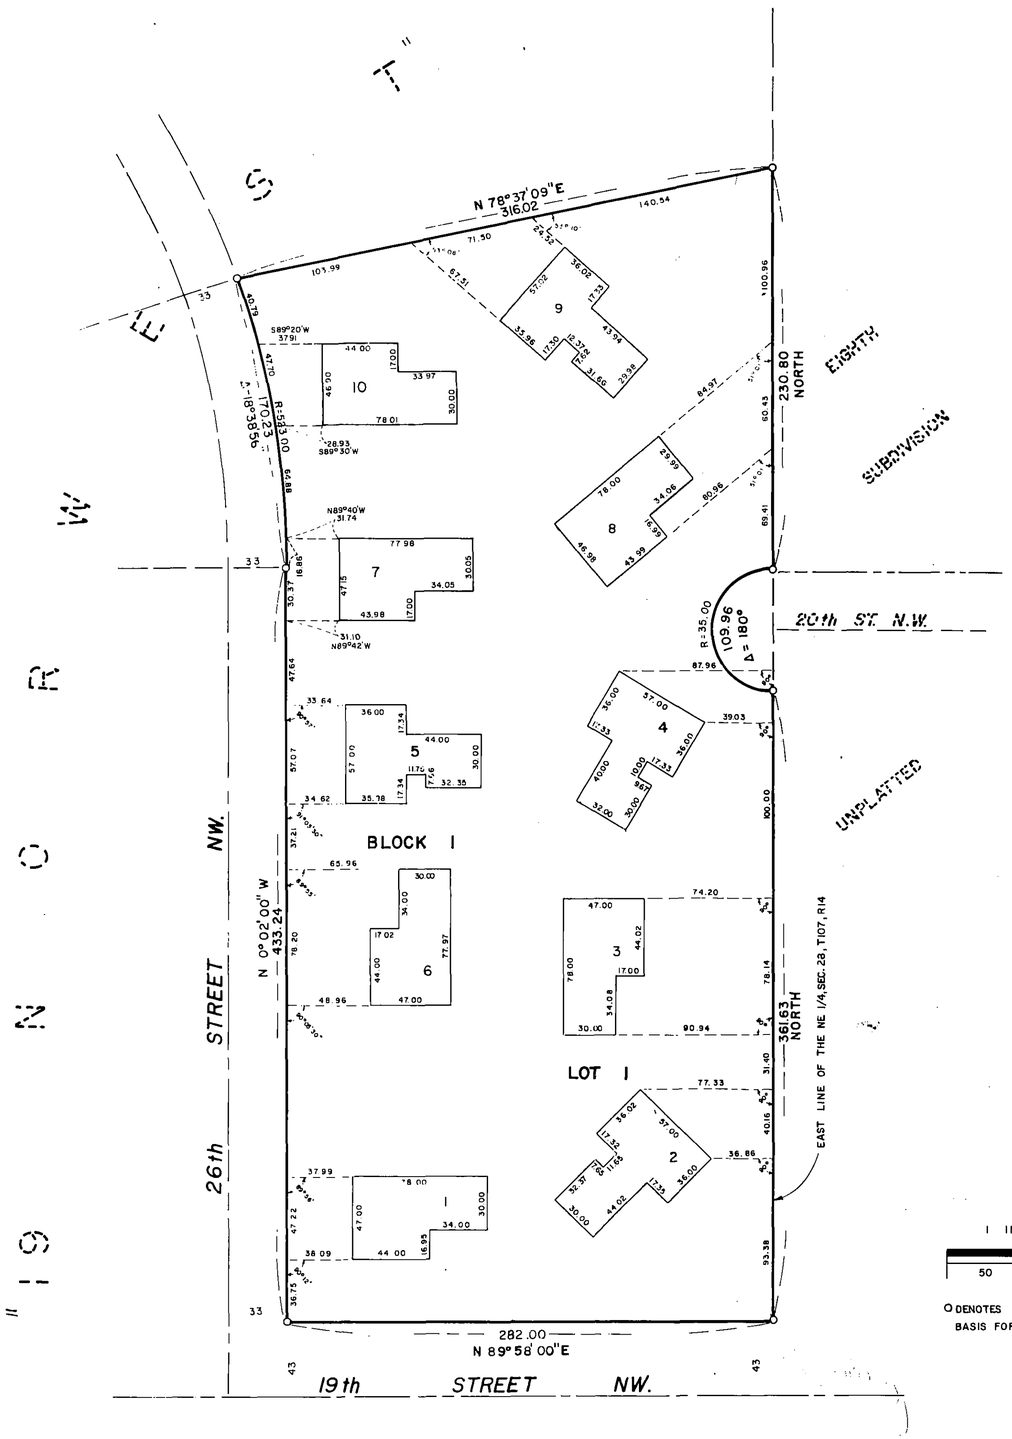

SCALE
1 INCH = 50 FEET
50 50 50

O DENOTES IRON MONUMENT
BASIS FOR BEARING IS ASSUMED

APARTMENT OWNERSHIP NUMBER 15

19 NORWEST CONDOMINIUM
THE CHARLES SECTION

CERTIFICATE:

The undersigned, being first duly sworn, under oath certifies and deposes that this plat of APARTMENT OWNERSHIP NUMBER 15, 19 NORWEST CONDOMINIUM, THE CHARLES SECTION, being located in Lot 1, Block 1, 19 Norwest, according to the recorded plat thereof, fully and accurately depicts the location and dimensions of buildings one (1), two (2), three (3), four (4), five (5), six (6), seven (7), eight (8), nine (9), and ten (10) as built, and that said buildings conform to the floor plans for 19 Norwest Condominium, The Charles Section, as recorded as document no. 352850.

James E. Boerhave

James E. Boerhave, Land Surveyor
Minnesota Reg. No. 7095

STATE OF MINNESOTA } ss.
COUNTY OF HENNEPIN }

Subscribed and sworn to before me a Notary Public this 1st day of NOVEMBER A.D.

William J. Gardner

Notary Public

My Commission Expires: SEPT. 10, 1975

LAWRENCE J. GARDNER
Notary Public, Hennepin County, Minn.
My Commission Expires Sept. 10, 1975

362024

5.00

PROOFED
GRANTOR
GRANTEE
TRACKED
PAID
CHG:

Retained

REGISTER OF DEEDS OFFICE } ss.
Olmsted County, Minn.
I hereby certify that the within instrument was filed in this office for record on

JAN 9 - 1975


at 12 o'clock P M
Book 233 of Misc. on page 312


Register of Deeds
By Deputy


BRW
PLANNING TRANSPORTATION ENGINEERING ARCHITECTURE

BARTHER RINGROSE, WOLSFELD INC

19 NORWEST CONDOMINIUM, THE CHARLES SECTION

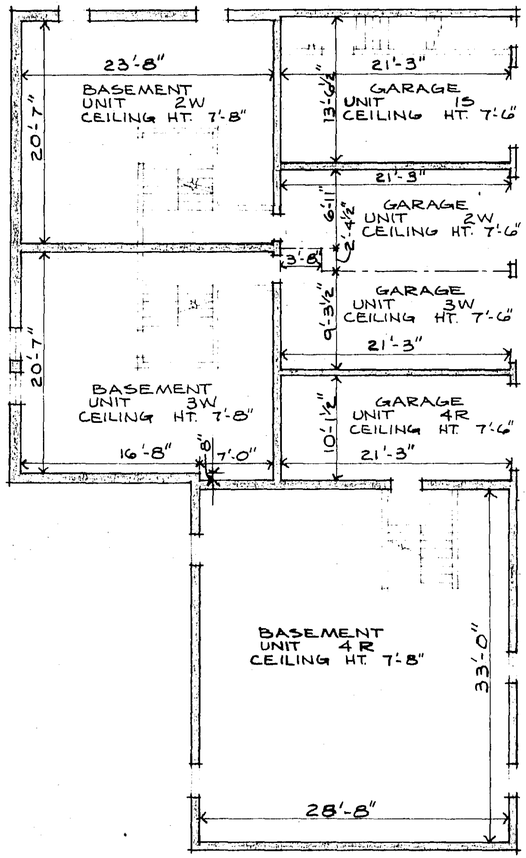

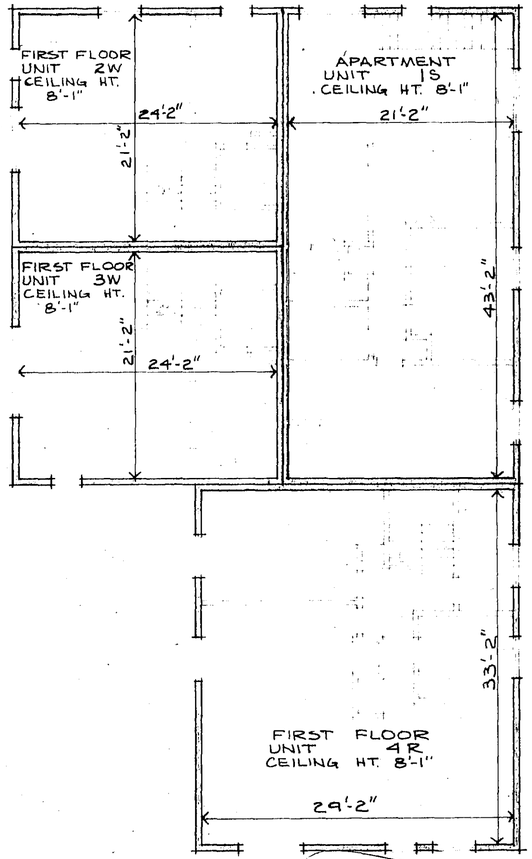

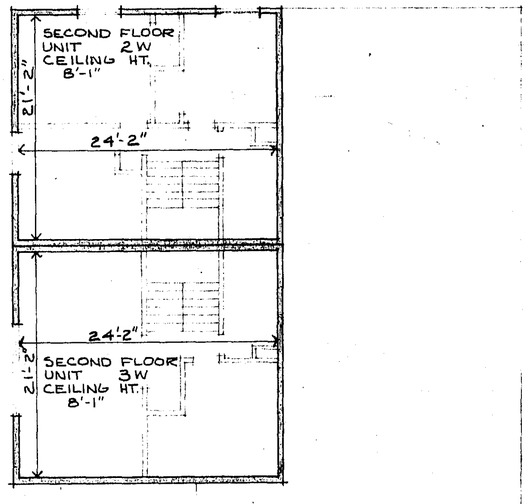

The undersigned being first duly sworn under oath certifies and deposes that the within set of floor plans of 19 Norwest Condominium, THE Charles Section, consisting of 17 pages numbered consecutively pages 1 through 17 represents an accurate copy of a portion of plans of the Building as filed with and approved by the Olmsted County, City of Rochester, Minnesota, and further that the same fully and accurately depicts the layout, location, apartment numbers and dimensions of the apartments as built.

Frank L. Reese

Frank L. Reese, Architect
Registration No. 7055


Subscribed and sworn to before me a Notary Public this 28 day of June, 1973 A.D.


Robert M. Anderson


My commission expires

ROBERT M. ANDERSON
Notary Public, Hennepin County, Minn.
My Commission Expires March 2, 1976.

19 NORWEST CONDOMINIUM NO. 1

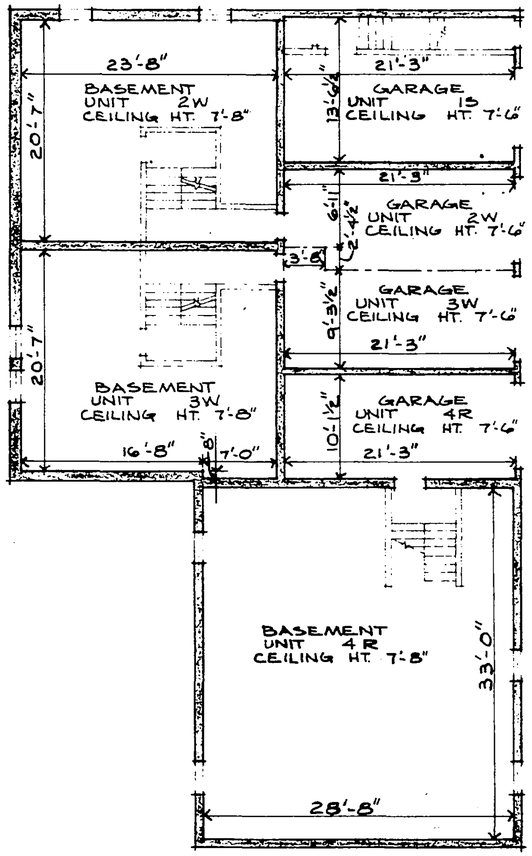

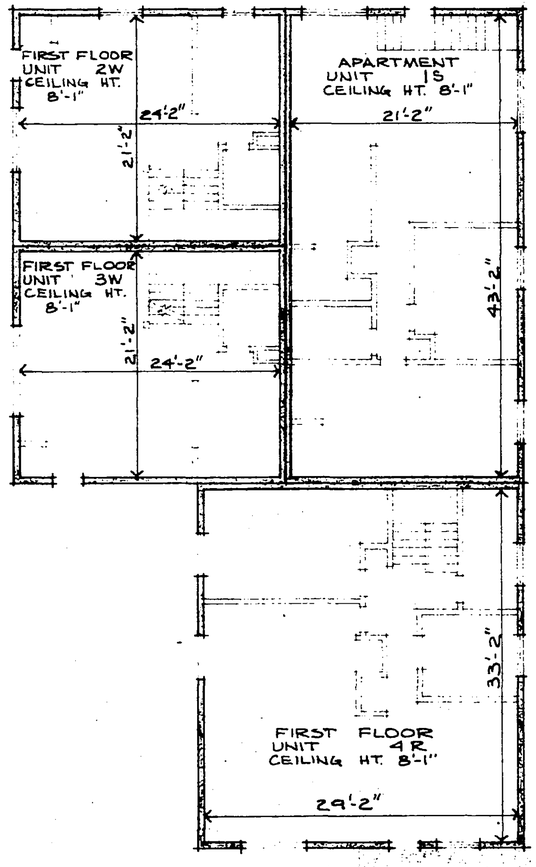

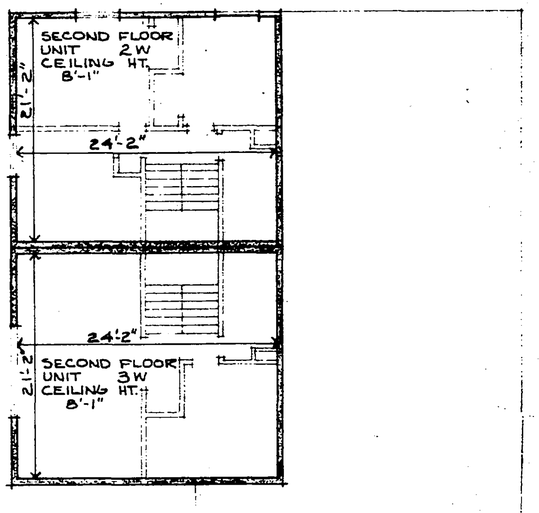


The undersigned being first duly sworn under oath certifies and deposes that the within set of floor plans of 19 Norwest Condominium No. 1 consisting of 17 pages numbered consecutively pages 1 through 17 represents an accurate copy of a portion of plans of the Building as filed with and approved by the Olmsted County, City of Rochester, Minnesota, and further that the same fully and accurately depicts the layout, location, apartment numbers and dimensions of the apartments as built.


_____
Frank L. Reese, Architect
Registration No. 7055

Subscribed and sworn to before me a Notary Public this 28 day of June, 1973 A.D.


_____, My commission expires _____.


19 NORWEST CONDOMINIUM NO. 1

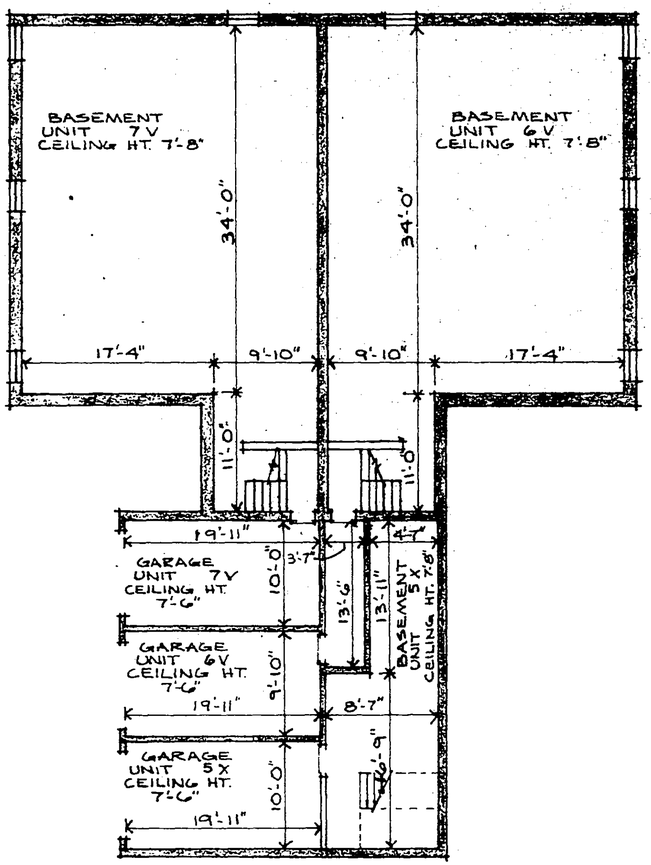


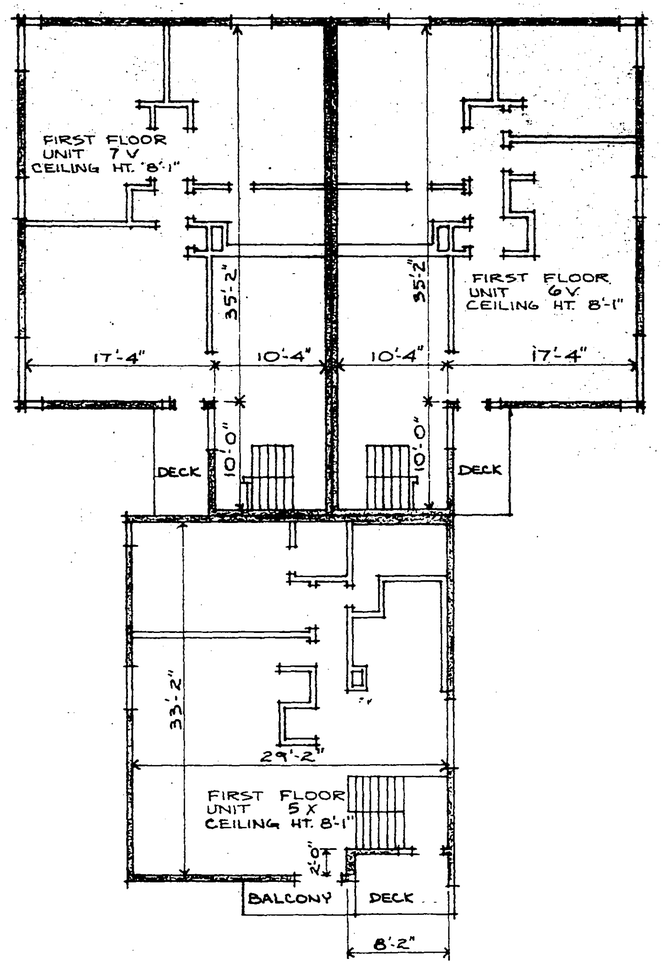


19 NORWEST CONDOMINIUM NO. 1

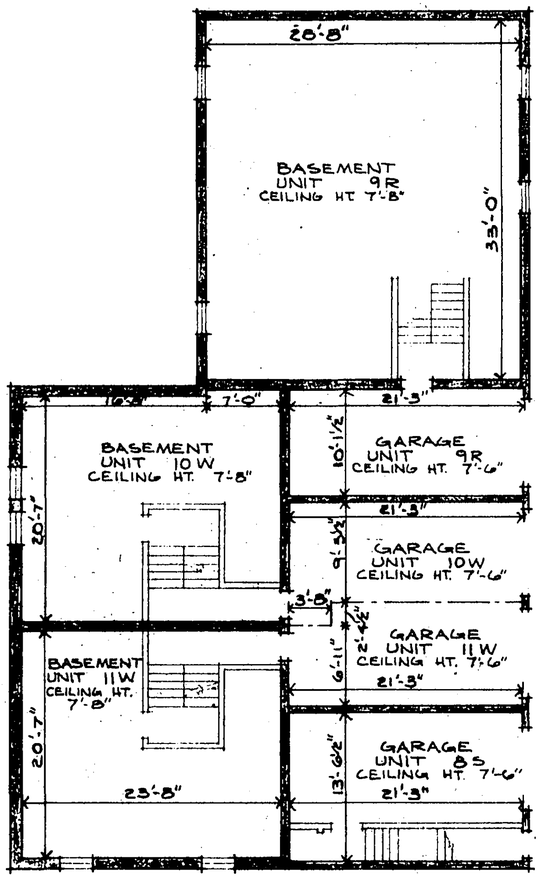


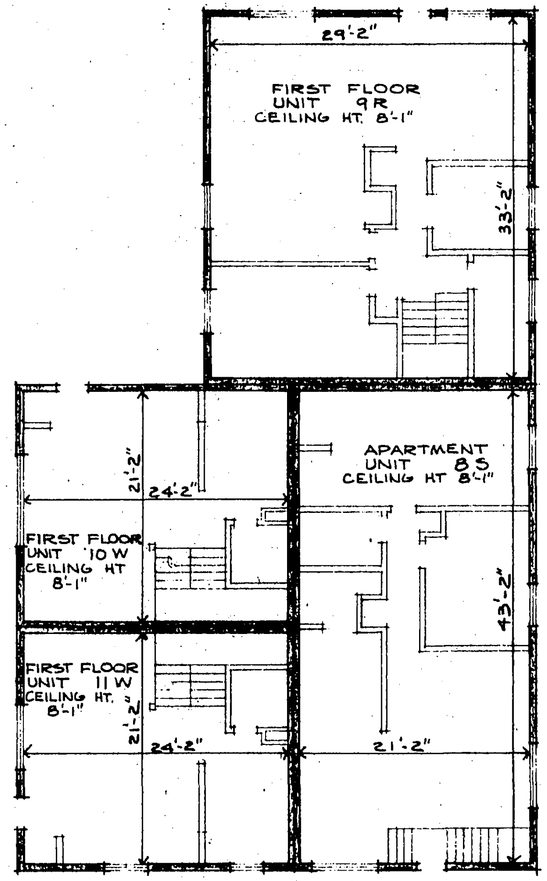

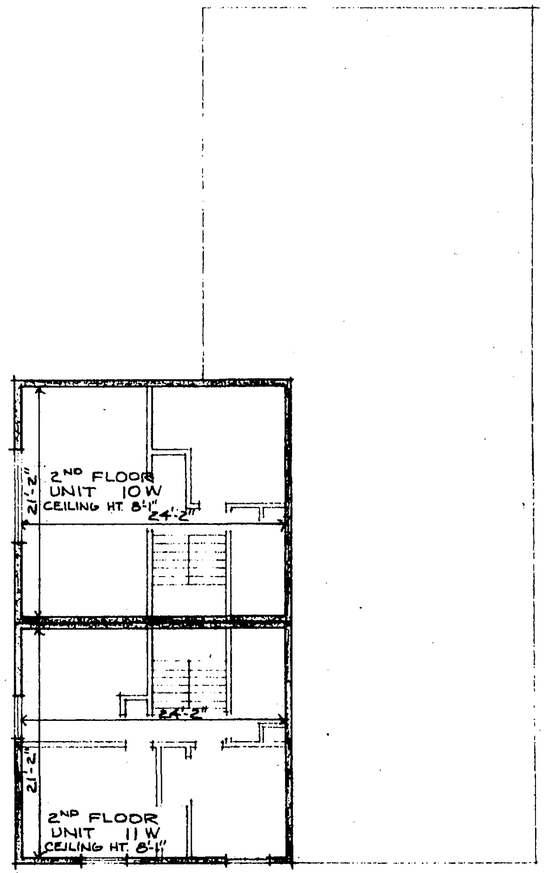



19 NORWEST CONDOMINIUM NO. 1

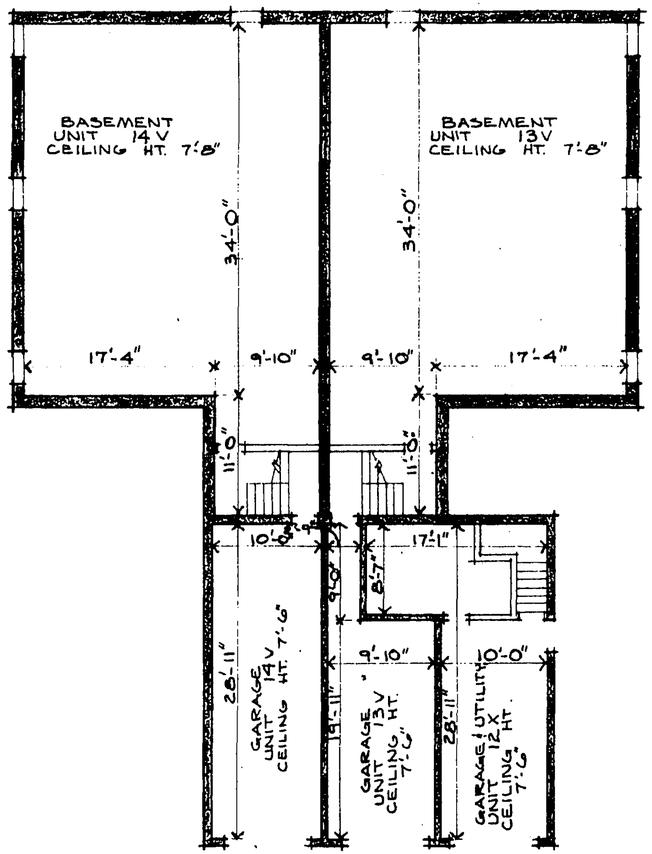

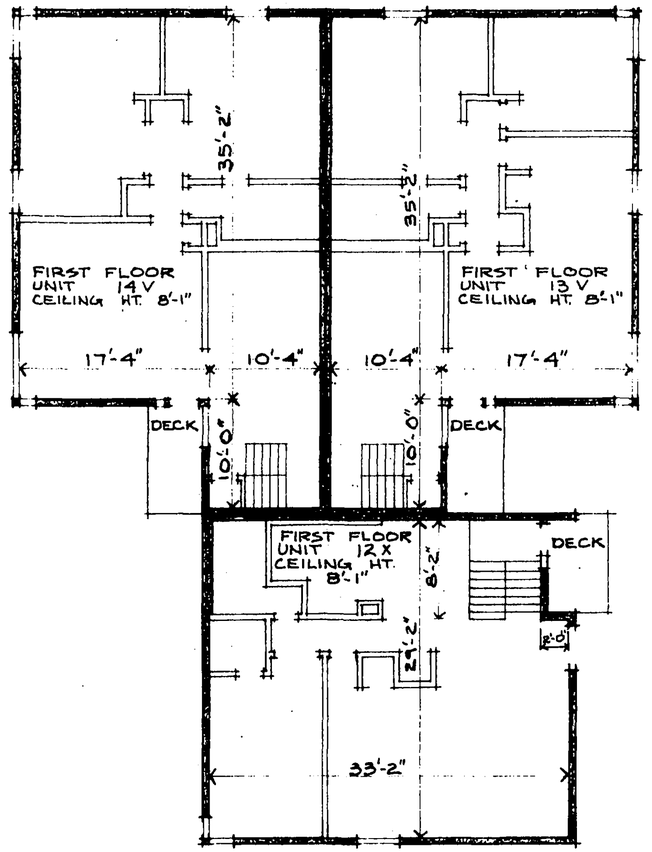



19 NORWEST CONDOMINIUM NO. 1

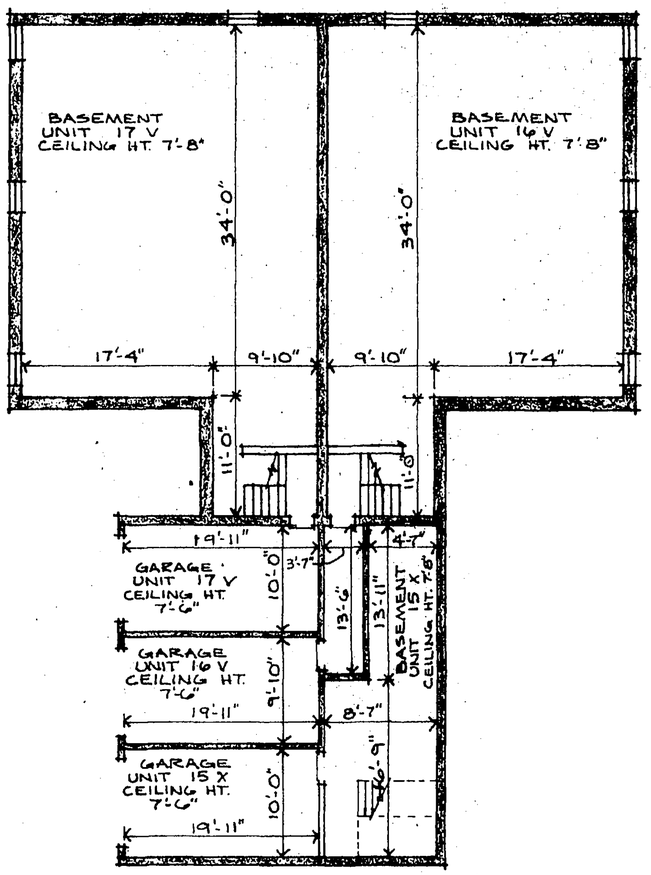


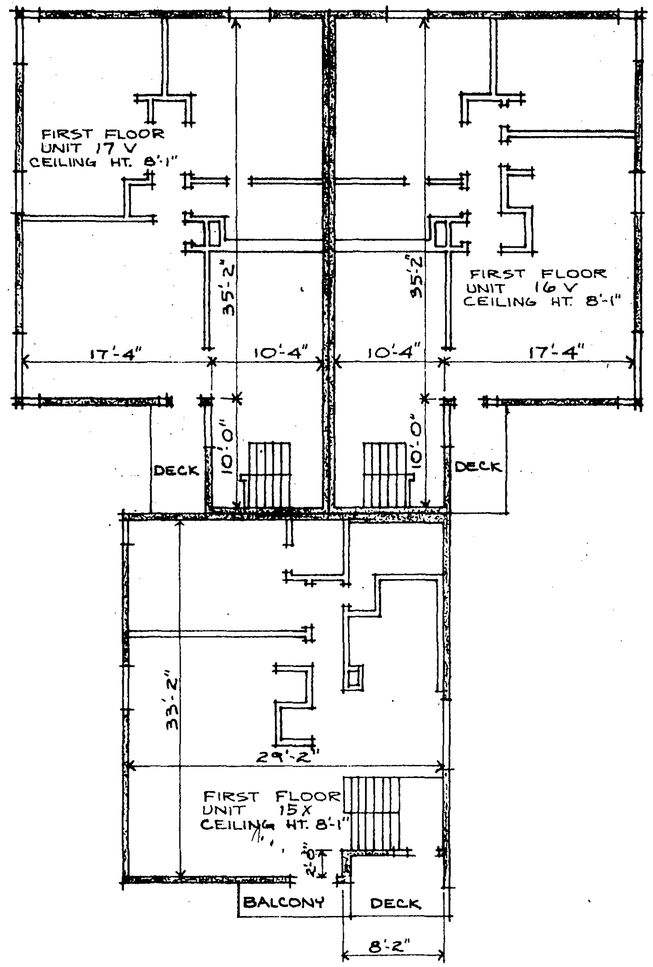


19 NORWEST CONDOMINIUM NO. 1

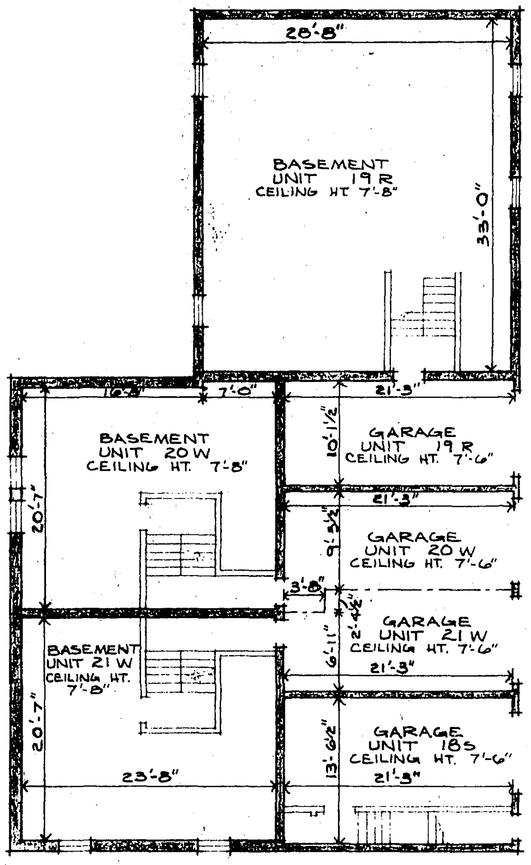


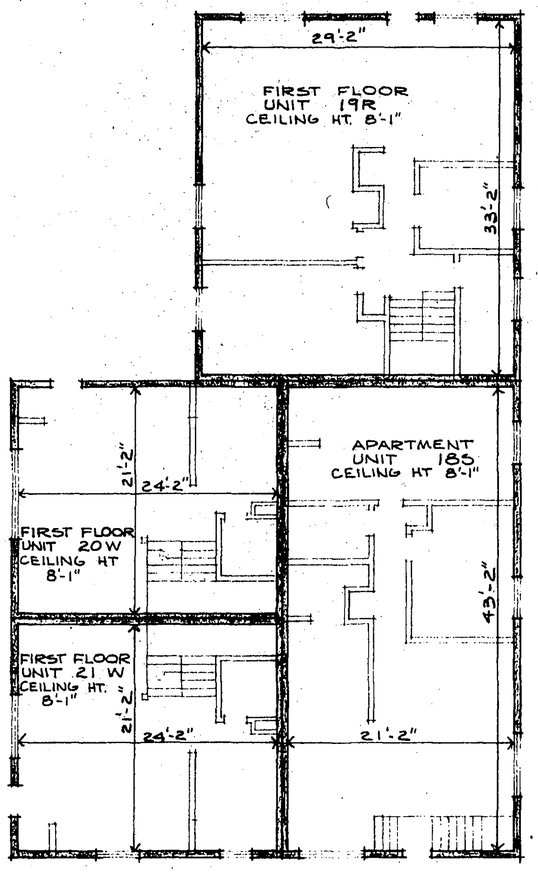


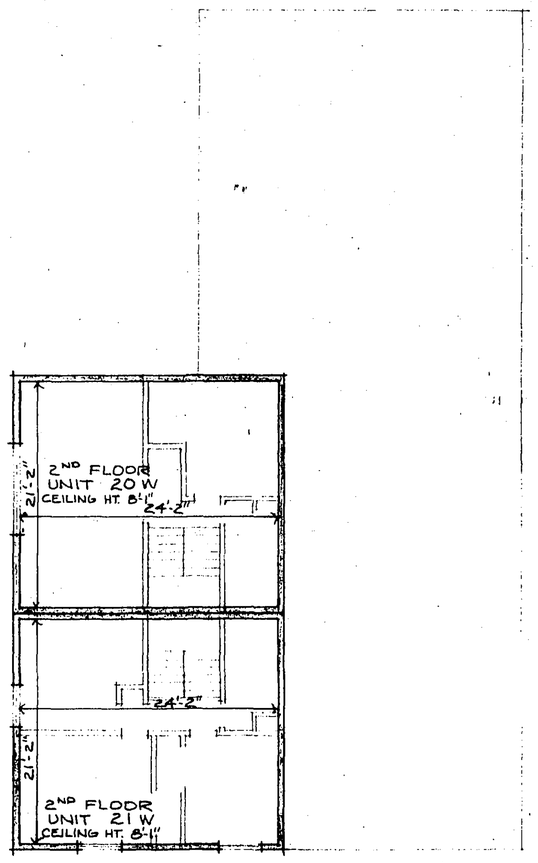


19 NORWEST CONDOMINIUM NO. 1

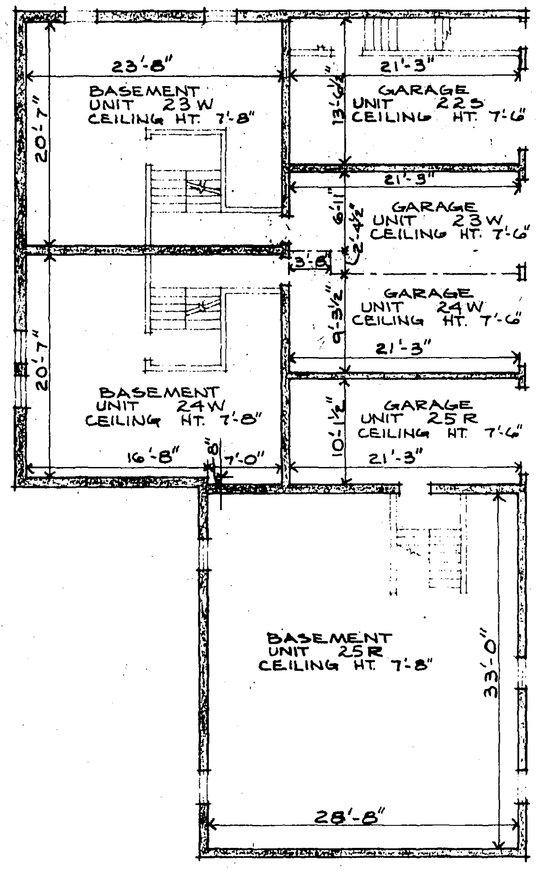


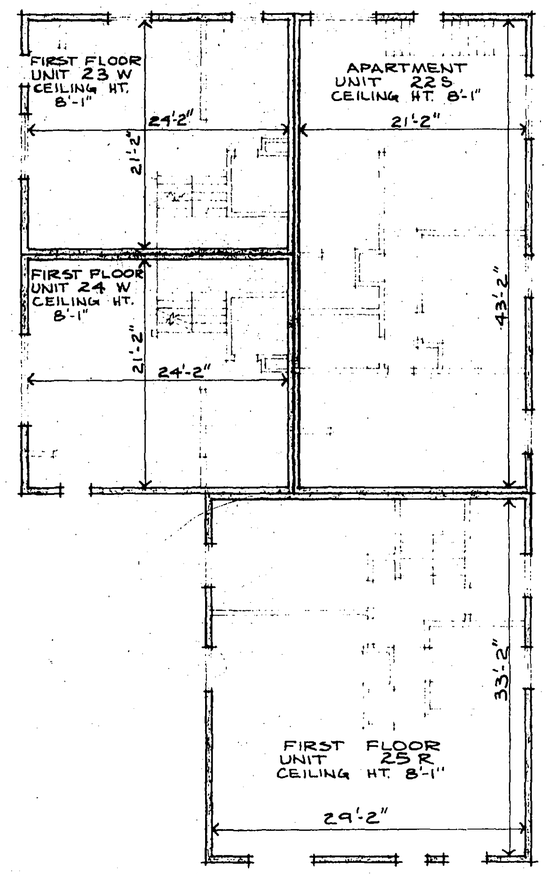


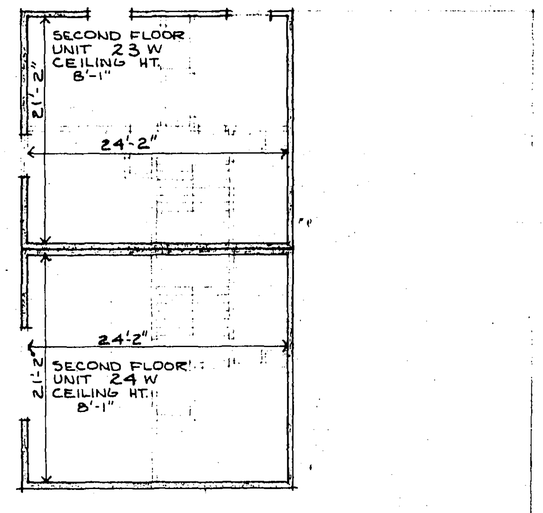


19 NORWEST CONDOMINIUM NO. 1

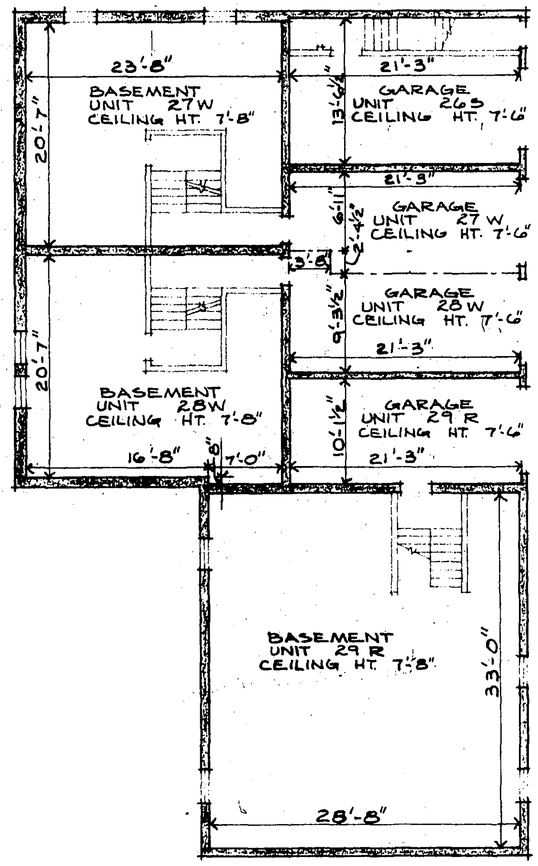


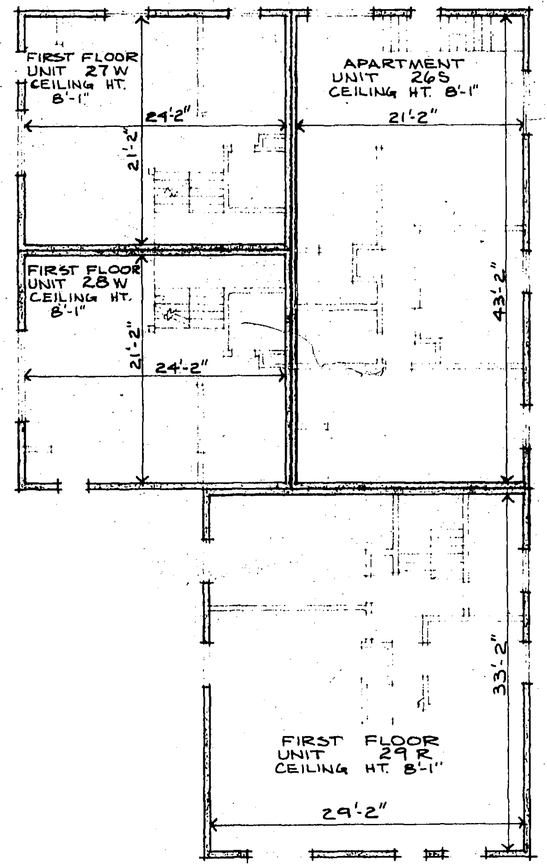

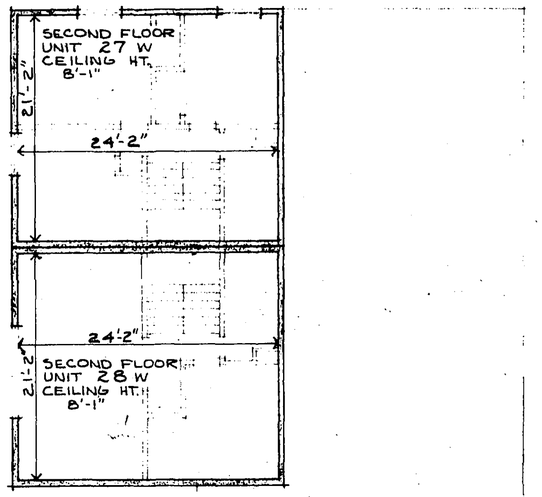



19 NORWEST CONDOMINIUM NO. 1

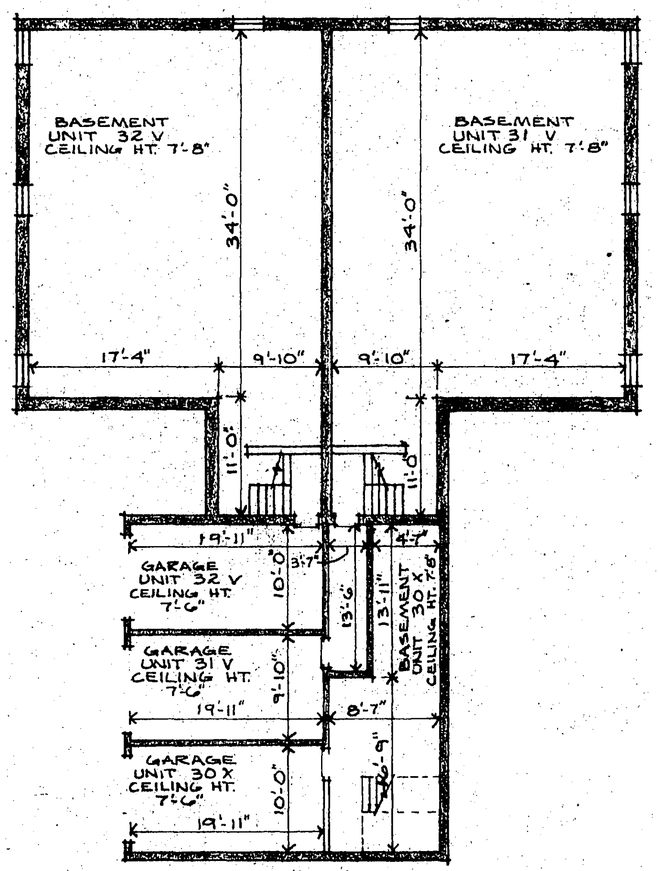


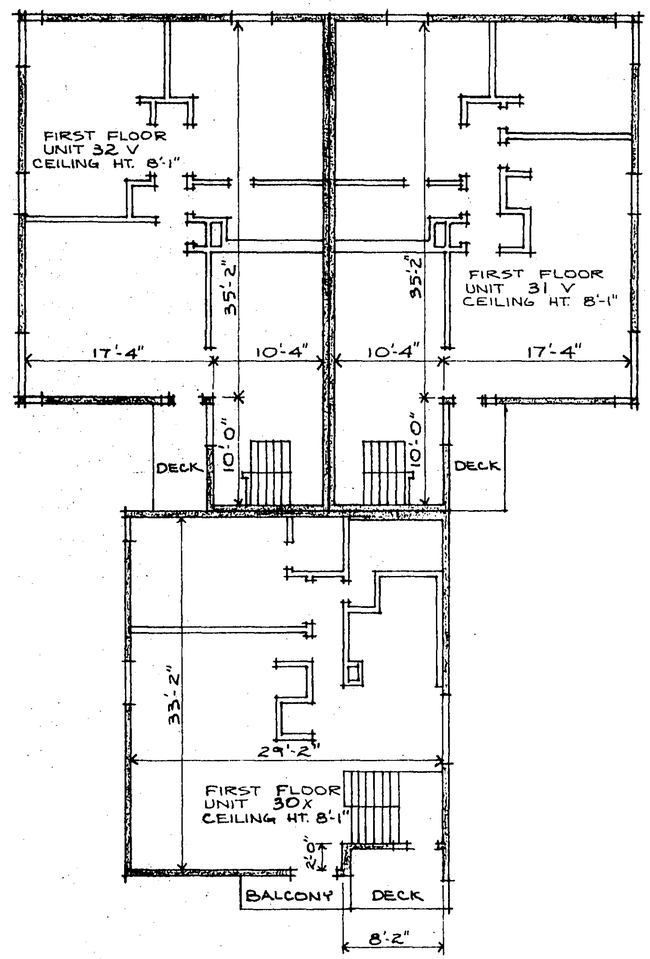


19 NORWEST CONDOMINIUM NO. 1

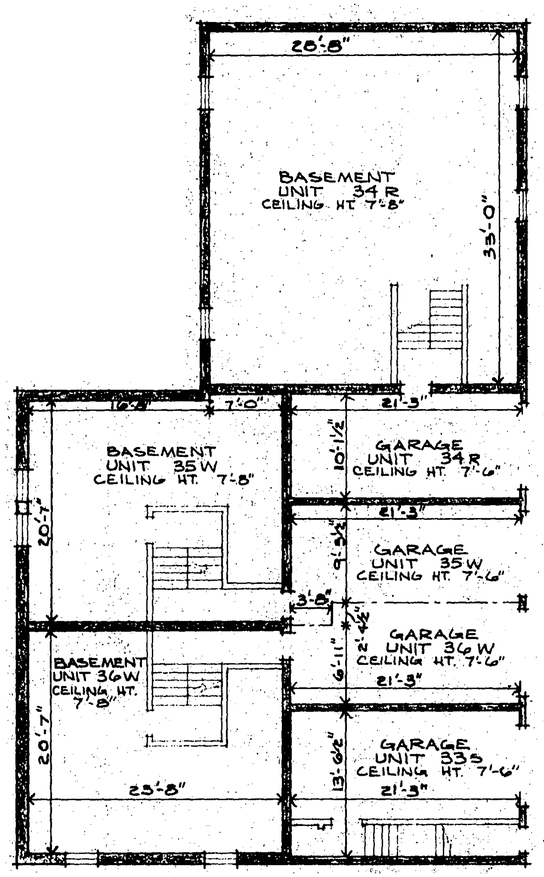


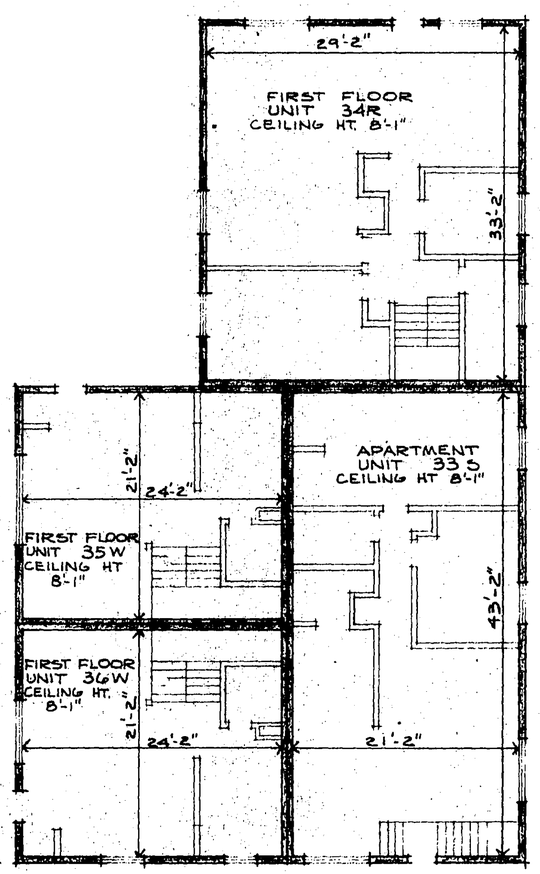

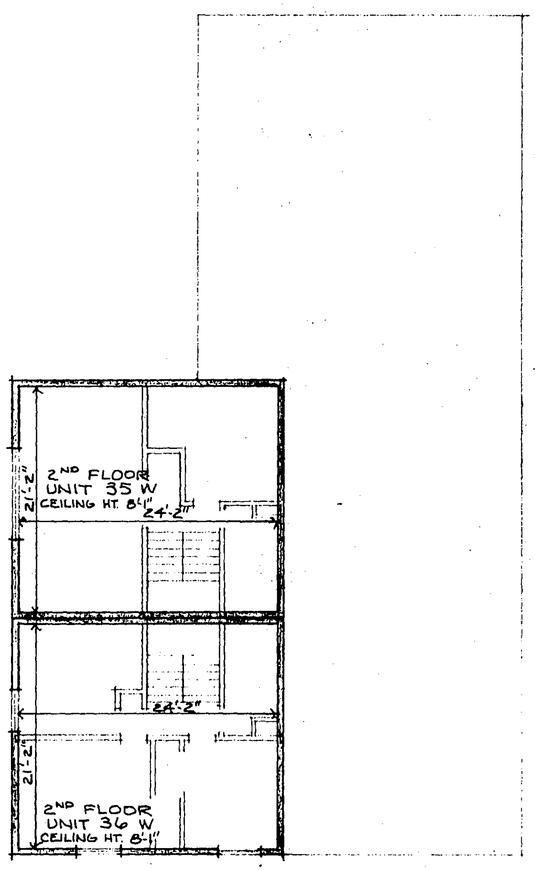



19 NORWEST CONDOMINIUM NO. 1

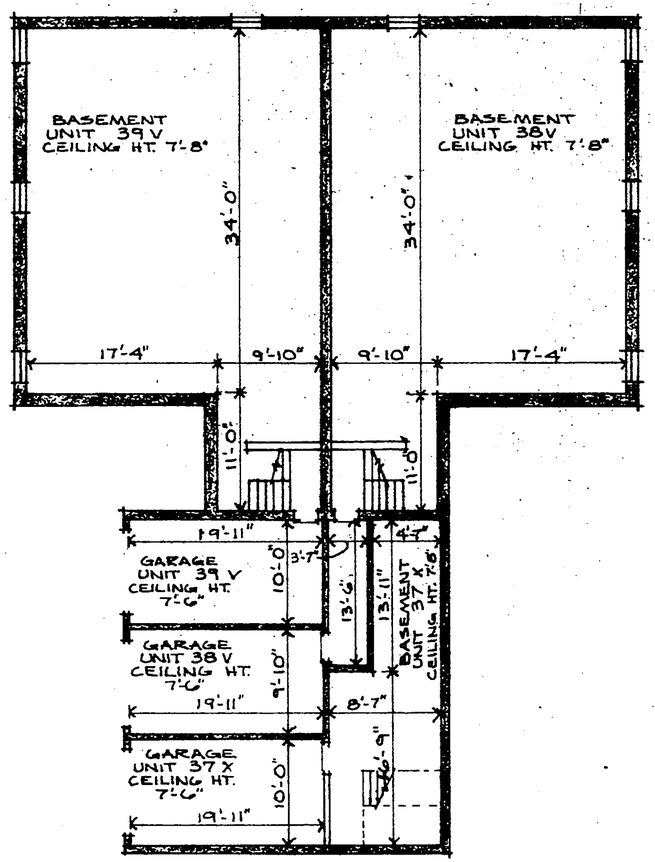

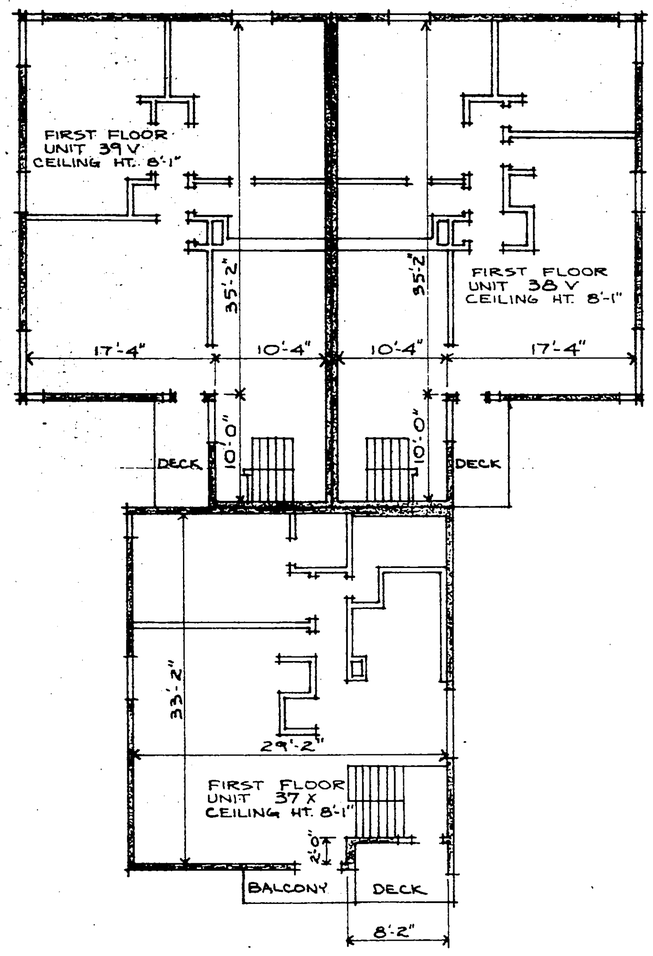



19 NORWEST CONDOMINIUM NO. 1

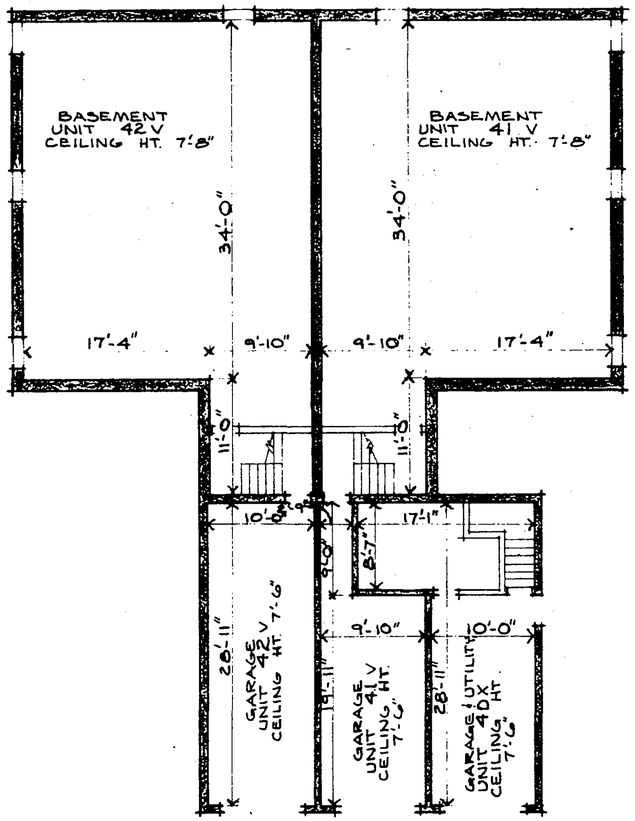

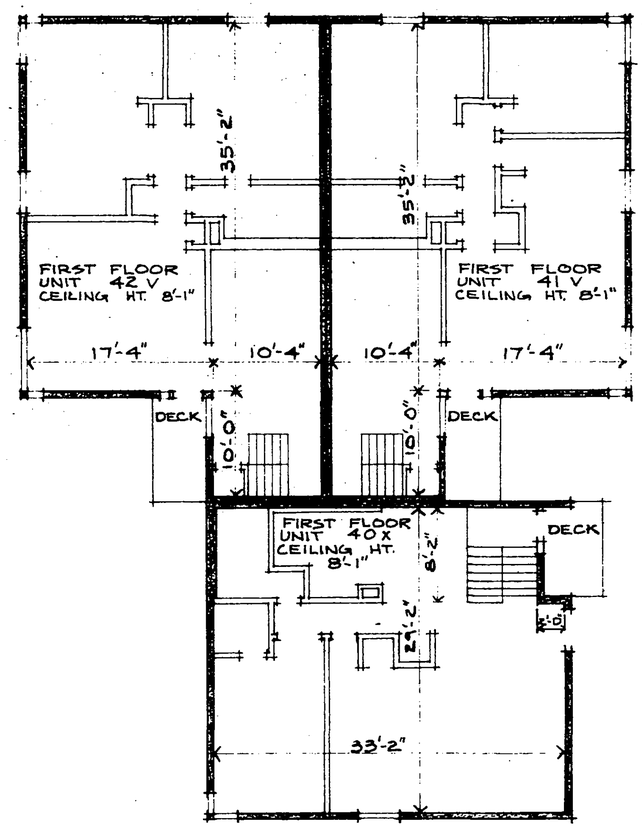



19 NORWEST CONDOMINIUM NO. 1

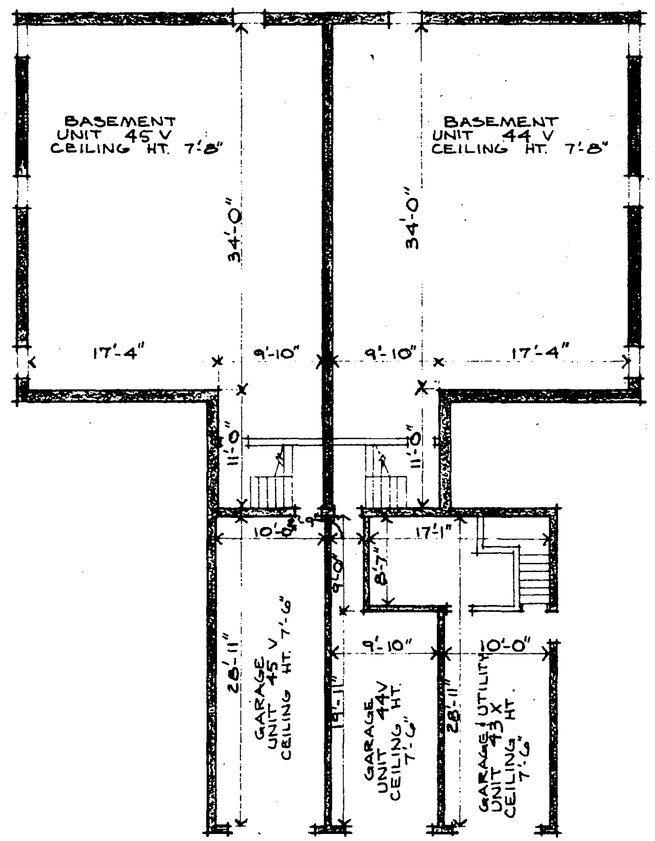


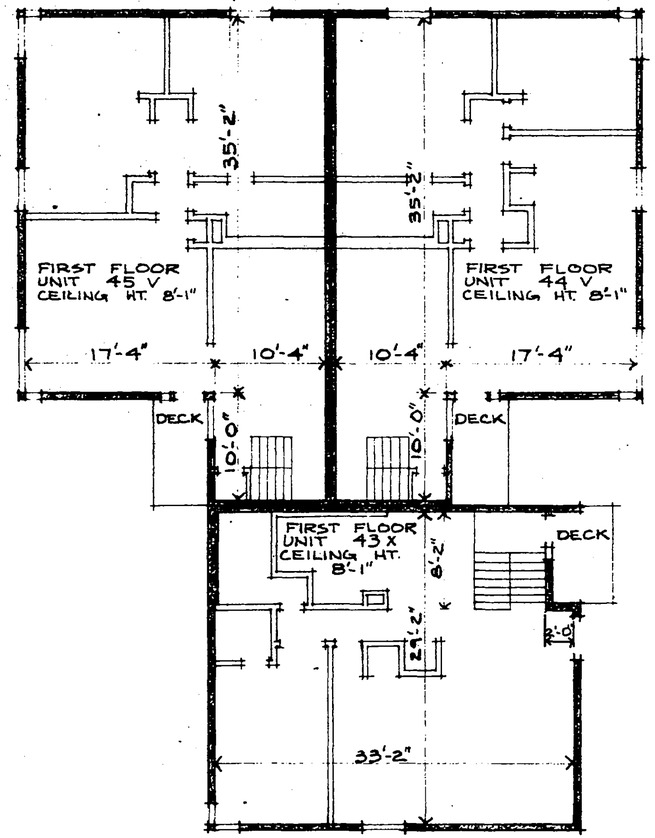


19 NORWEST CONDOMINIUM NO. 1

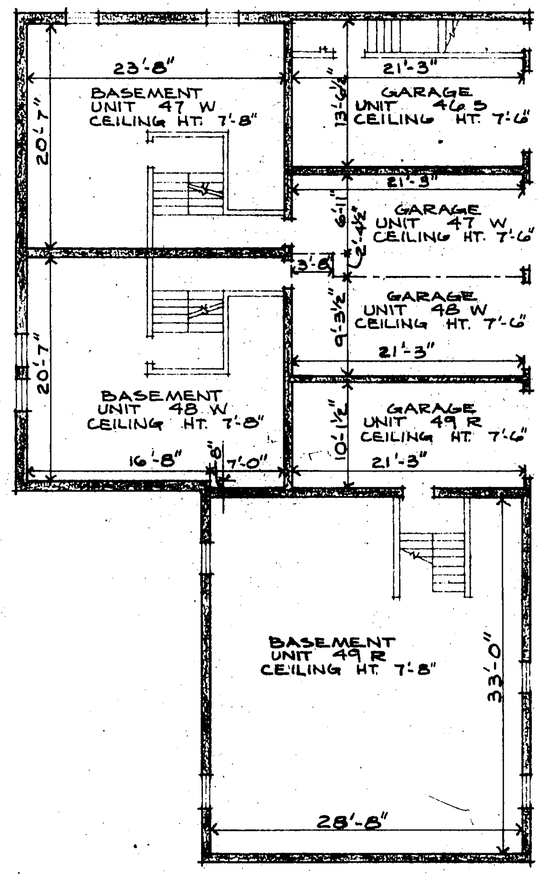


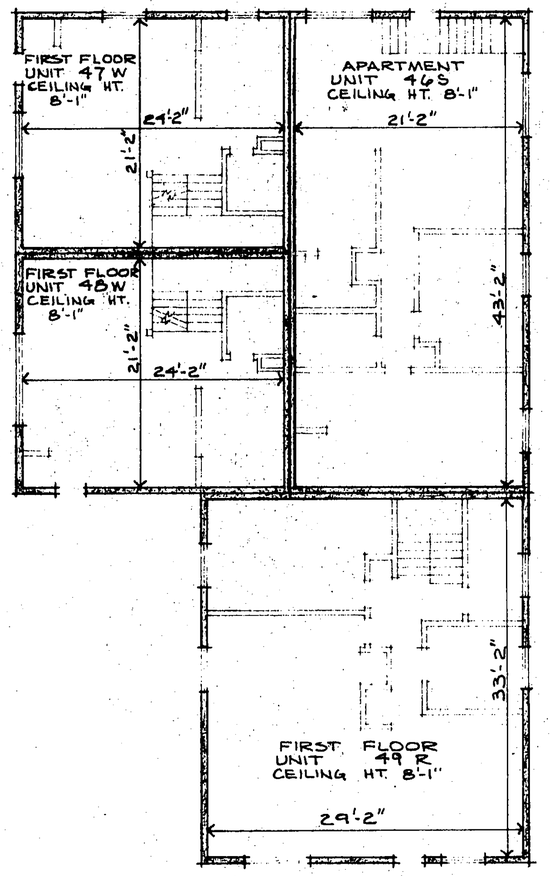

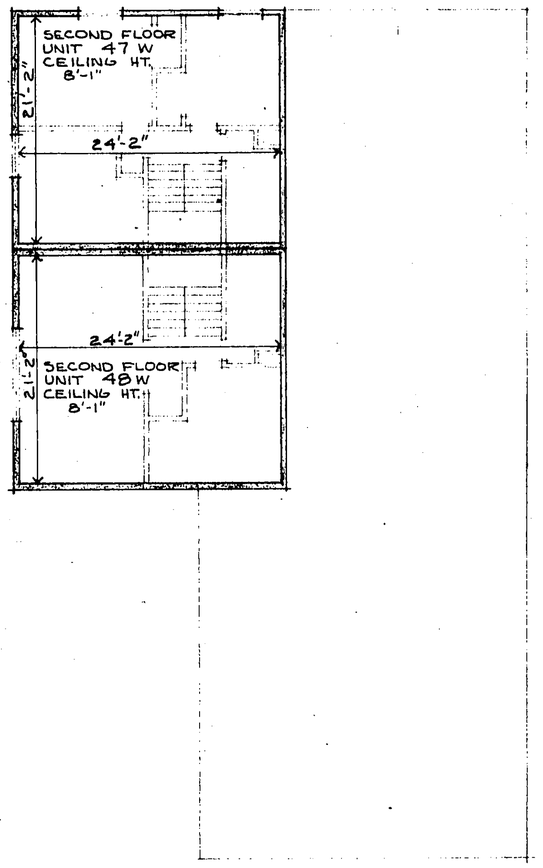



19 NORWEST CONDOMINIUM NO. 1

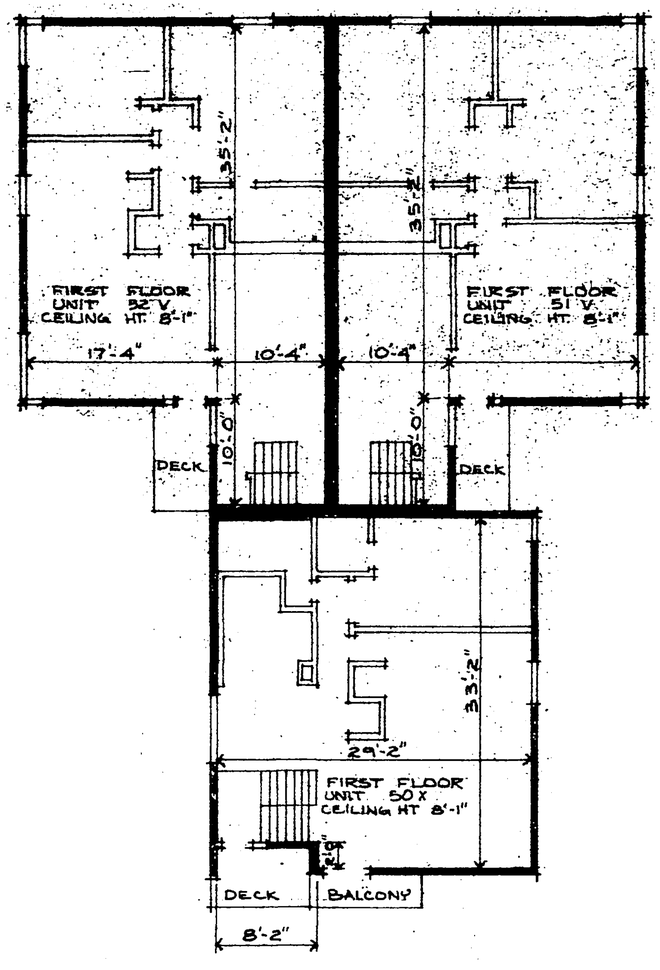


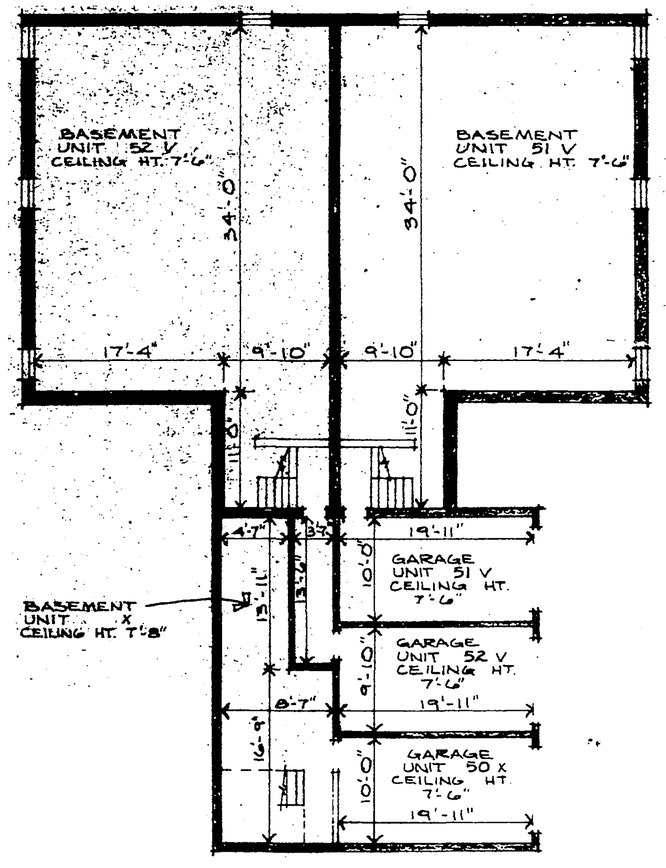

19 NORWEST CONDOMINIUM NO. 1

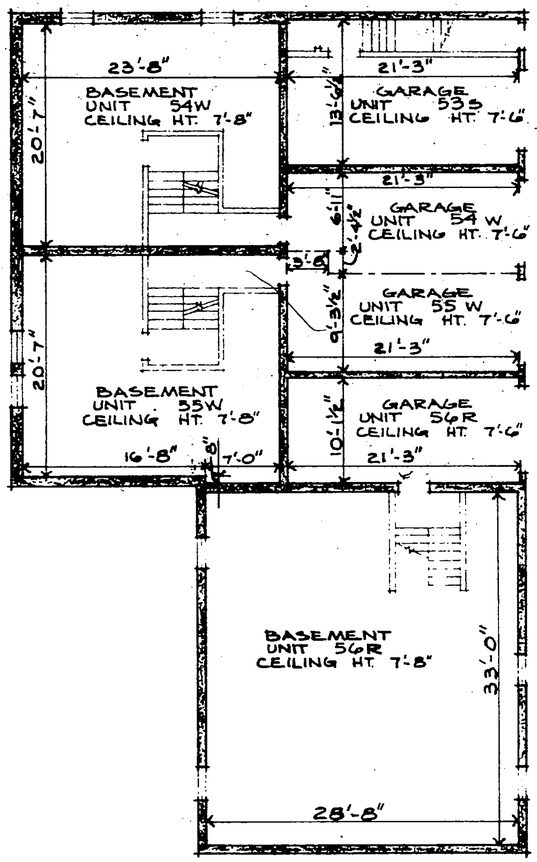

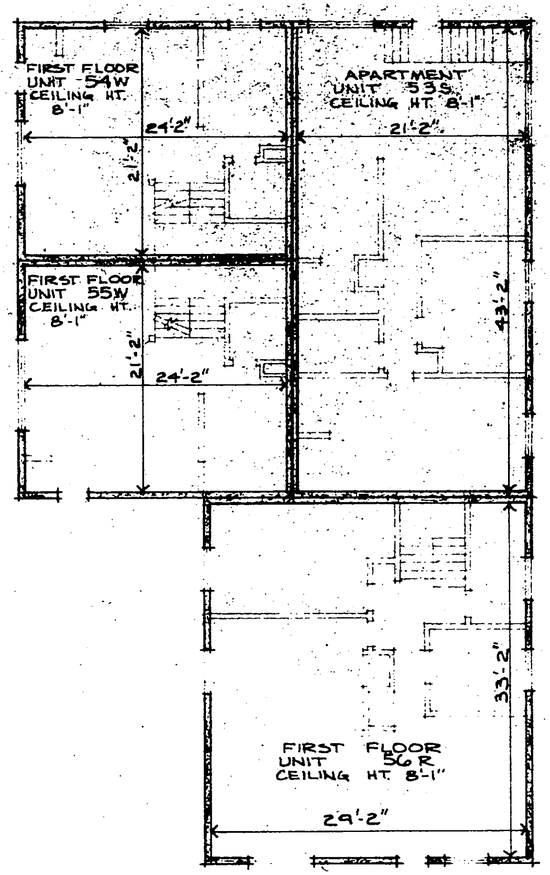

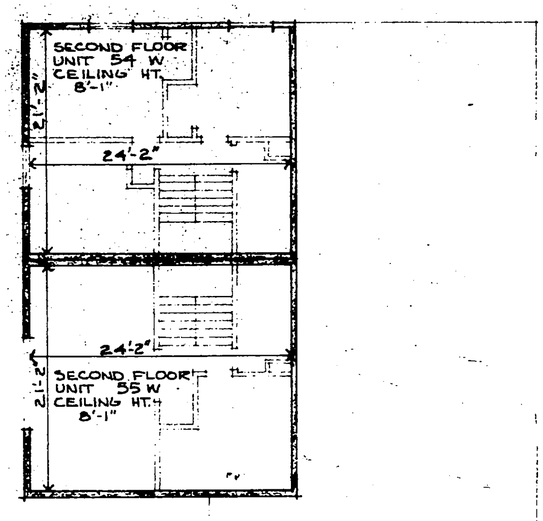

17.00

PROOFED
GRANTOR
GRANTEE
TRACKED
PAID ✓
CHG:

352850

19 NORWEST CONDOMINIUM NO. 1

REGISTER OF DEEDS OFFICE } ss.
Olmsted County, Minn.
I hereby certify that the within instrument was filed in this office for record on

DEC 17 1973
at 10 1/4 o'clock A.M.
Book X-3 of Misc. on page 720
Nancy D. Lange Register of Deeds
By Grace Gunderson Deputy

