
# OLMSTED COUNTY HIGHWAY RIGHT OF WAY PLAT NO. 30 AS AMENDED

C.S.A.H. NO. 12

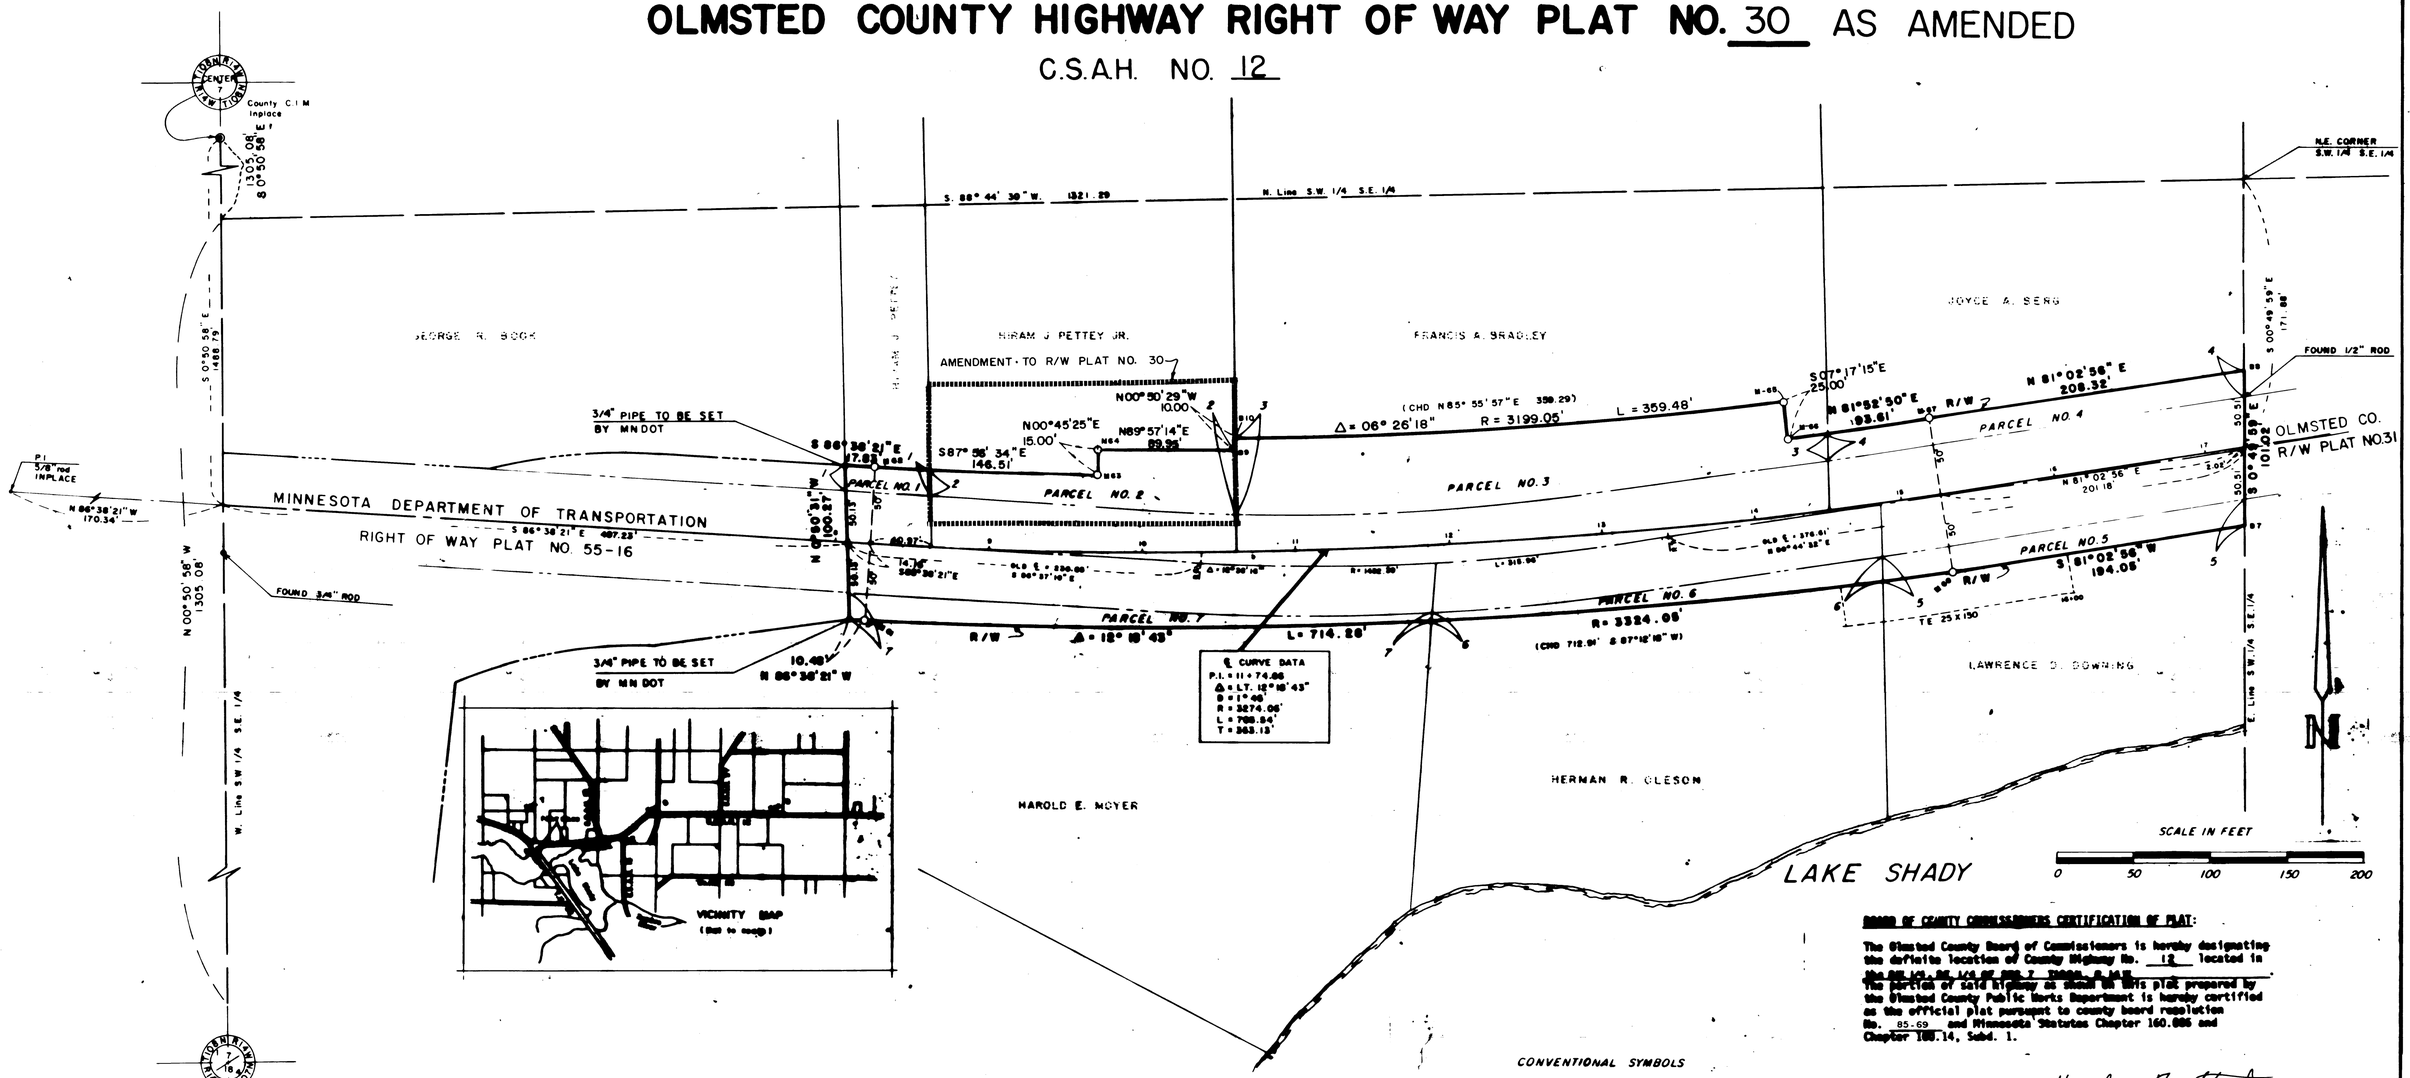


RIGHT OF WAY IN SECTION 7 T.108 N., R. 14 W.

| PARCEL | OWNER | LOCATION | EXISTING HIGHWAY R/W | NEW HIGHWAY R/W | TEMPORARY EASEMENTS | T.E. EXPIRES ON | R/W INTEREST |
|---|---|---|---|---|---|---|---|
| 2. | Alice A. Knappe<br>Hiram J. Pettey Jr. | SW¼ SE ¼ | 0.15 ac. | 0.13 ac. | none | | easement |

CONVENTIONAL SYMBOLS

LAND SUBDIVISION LINE
PROPERTY LINE
RIGHT-OF-WAY BOUNDARY
EXISTING C.H.D. R/W LINE
OTHER ROAD R/W'S
RAILROAD R/W
TEMPORARY EASEMENTS
NEW R/W PARCEL NUMBER
ACCESS CONTROL
ACCESS OPENING
R/W MONUMENT
MONUMENTS FOUND
MONUMENTS SET (1" Square iron with cap no. 8952)
R/W BOUNDARY CORNER

DISTANCES TO FEET (66', 100'etc) ARE EXTRINSIC VALUES

COUNTY RECORDER 487173
DOCUMENT NUMBER
BOOK T-4 OF Misc PAGE 270

I HEREBY CERTIFY THAT THIS INSTRUMENT WAS FILED IN THE OFFICE OF THE COUNTY RECORDER FOR RECORD ON THIS 22 DAY OF May, 1985 A.D., AT 1:12 O'CLOCK P M. IN BOOK T-4 ON PAGE 270 AND WAS DULY RECORDED IN THE OLMSTED COUNTY RECORDS.

BY LOIS FINSTUEN
COUNTY RECORDER

Jerald M. Ferries
DEPUTY

BOARD OF COUNTY COMMISSIONERS CERTIFICATION OF PLAT:

The Olmsted County Board of Commissioners is hereby designating the definite location of County Highway No. 12 located in the SW 1/4, SE 1/4 OF SEC. 7 T108N., R.14W.
The portion of said highway as shown on this plat prepared by the Olmsted County Public Works Department is hereby certified as the official plat pursuant to county board resolution No. 85-69 and Minnesota Statutes Chapter 160.085 and Chapter 160.14, Subd. 1.

Harley Boettcher
Chairperson

I hereby certify that this plat prepared by the Olmsted County Public Works Department is a true and correct representation of the highway location and that the right-of-way is correctly designated on the plat.

J K Oberg
Public Works Director
Registration No. 10219 Date 5-21-85

I hereby certify that this plat was prepared by me or under my direct supervision and that I am a duly Registered Land Surveyor under the Laws of the State of Minnesota; that this plat meets requirements of Minnesota Statutes Chapter 160.085 and Chapter 160.14, Subd. 1; that parcel ownerships are delineated on the plat; that the monuments for the guidance of future surveys will be correctly placed in the ground as shown after completion of construction; that all measurements are correctly shown on this plat; and that the outside boundary lines are correctly designated on this plat.

Roger W. Brand
Olmsted County Surveyor
Registration No. 8952 Date May 13, 1985