
OFFICIAL

AMENDED OLMSTED COUNTY HIGHWAY RIGHT OF WAY PLAT NO. 236
COUNTY ROAD NO. 101

*THIS PLAT AMENDS OLMSTED COUNTY HIGHWAY RIGHT OF WAY PLAT NO. 236 AS TO THE FOLLOWING:
- ADDED AN ACCESS OPENING FOR PARCEL 1

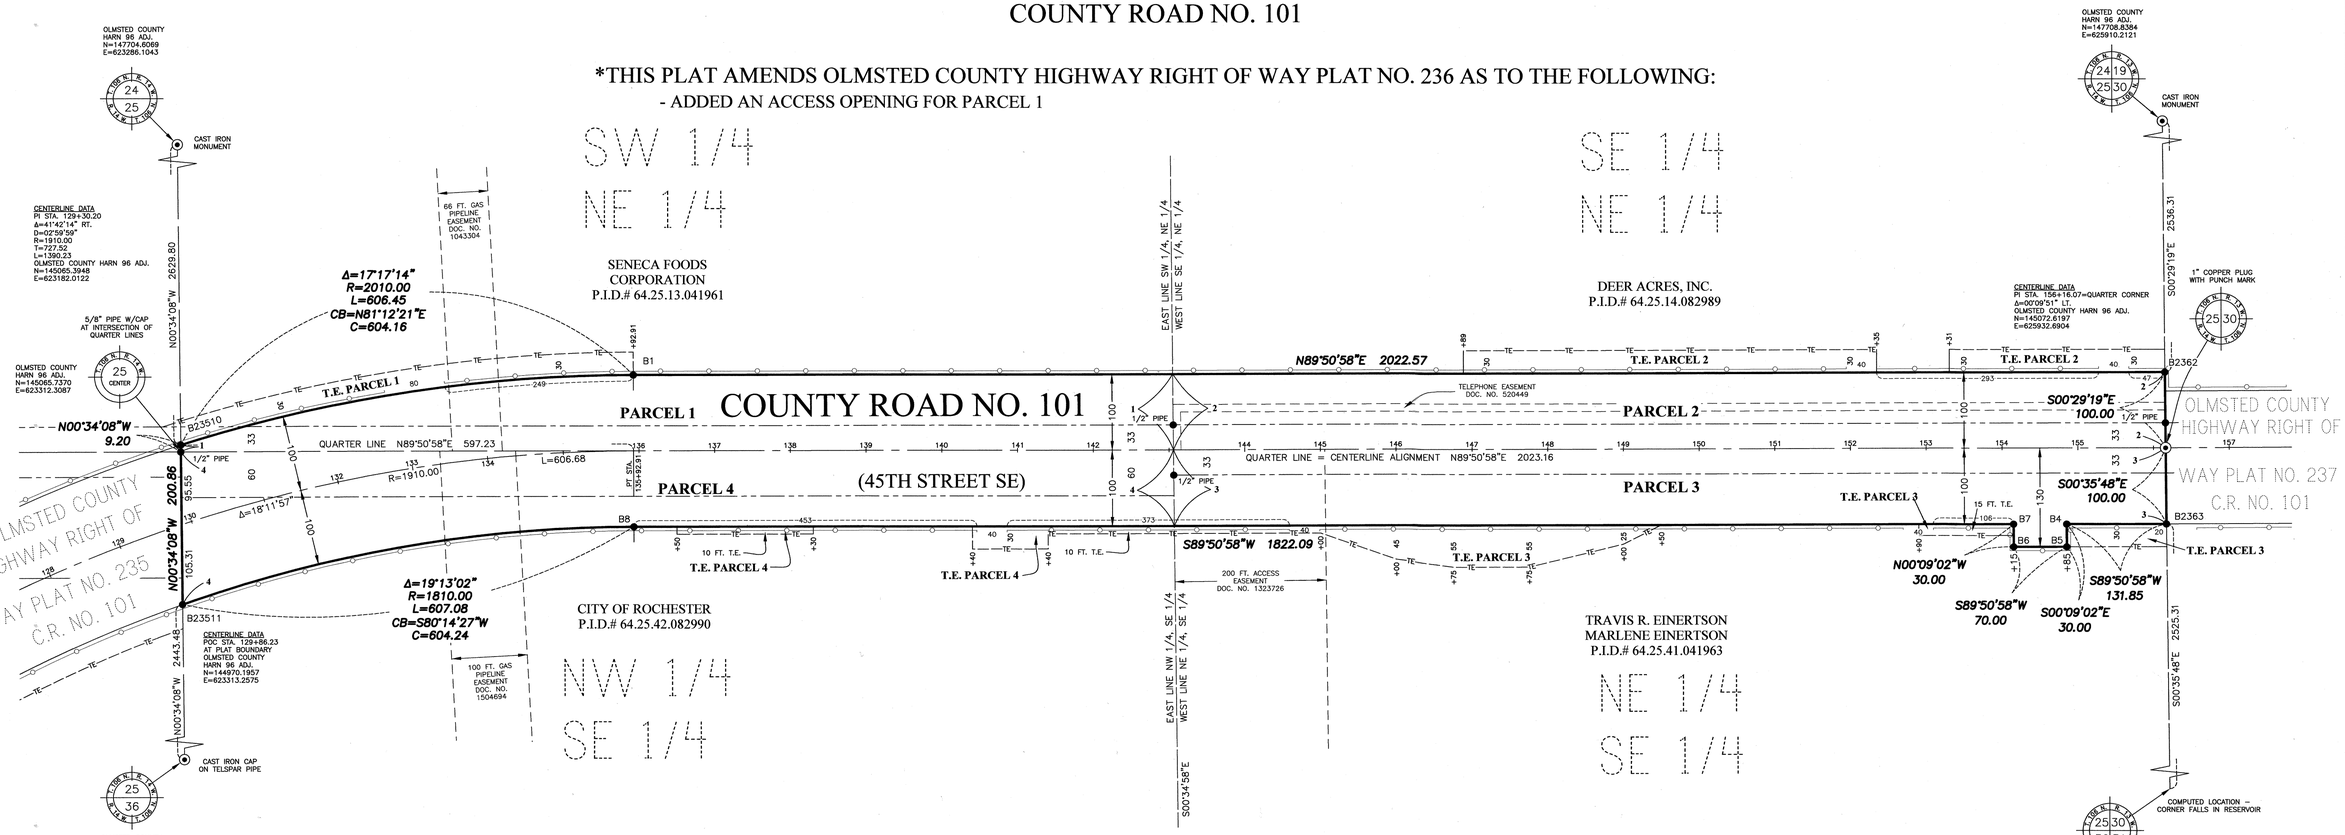

The Board of County Commissioners for Olmsted County, Minnesota, pursuant to County Board Resolution Number 22–177, dated December 1, 2022, is hereby designating the definite location of County Road No. 101, located in Section 25, Township 106 North, Range 14, Olmsted County, Minnesota.

COUNTY ENGINEER
I hereby certify that this plat prepared by the Olmsted County Public Works Department is a true and correct representation of the highway location and that the right–of–way is correctly designated on the plat.

B. T. J. Date 12/7/2022
Benjamin T. Johnson, Olmsted County Engineer
Minnesota License No. 44588

COUNTY SURVEYOR
I hereby certify that this plat was prepared by me or under my direct supervision and that I am a duly Licensed Land Surveyor under the laws of the State of Minnesota; that the monuments for the guidance of future surveys will be correctly placed in the ground as shown after completion of construction; that all measurements are correctly shown on this plat; and the proposed right–of–way boundary lines are correctly designated on this plat.

Eric C. Stennes Date 12/7/2022
Eric C. Stennes, Olmsted County Surveyor
Minnesota License No. 57072

PROPERTY RECORDS AND LICENSING

DOCUMENT NUMBER A-1578389

I hereby certify that this instrument was filed in the Office of the Property Records and Licensing for the record on this 8th day of December, 2022, at 11 12 o'clock AM. and was duly recorded in the Olmsted County records.

Mary Blair-Hoeft
Olmsted County Director of Property Records and Licensing
By Wendy von Wald Deputy

NOTES:

1. Distances are shown in U.S. Survey Feet.
2. Boundary monuments will be set following substantial completion of the project.
3. Owners' names are for reference only and are subject to change.
4. All parcels shown on this plat may or may not have been acquired by the County of Olmsted. Check pertinent documents for each parcel to verify.

PARCEL NUMBER	OWNER	LOCATION	RECORD DEED DOC. NO.	EXISTING R/W	NEW R/W	TOTAL R/W	R/W INTEREST	TEMPORARY EASEMENT
1	SENECA FOODS CORPORATION	W 1/2, NE 1/4 SEC. 25, T106N R14W	807263	0.97 AC.	1.63 AC.	2.60 AC.	FEE	0.40 AC.

NOTE: TEMPORARY EASEMENT WILL EXPIRE ON DECEMBER 31, 2023

LEGEND


- O – SET 1/2" ROD W/CAP #57072
- ⊙ – PUBLIC LAND SURVEY CORNER
- ● – DENOTES FOUND 1/2" ROD UNLESS NOTED OTHERWISE
- Δ = CENTRAL ANGLE
- R = RADIUS DISTANCE
- L = ARC DISTANCE
- CB = CHORD BEARING
- C = CHORD DISTANCE
- R/W = RIGHT OF WAY
- B1 = OLMSTED COUNTY R/W BOUNDARY CORNER
- (B2) = MnDOT R/W BOUNDARY CORNER
- SECTION LINE
- SIXTEENTH LINE
- PROPERTY LINE
- RIGHT OF WAY BOUNDARY
- EXISTING ROAD RIGHT OF WAY
- EXISTING ROAD CENTERLINE
- EXISTING EASEMENT LINE
- PARCEL 1 PARCEL IDENTIFICATION
- 1-1-2 PARCEL BOUNDARY LIMITS
- 140 NEW CENTERLINE/ACQUISITION LINE
- CONTROLLED ACCESS
- 30 CONTROLLED ACCESS OPENING
- TE TEMPORARY EASEMENT LINE

DISTANCES SHOWN IN FEET (33, 50, ETC.) ARE EXACT VALUES

N

50 0 100 200
SCALE IN FEET

ORIENTATION OF THIS BEARING SYSTEM IS BASED ON HARN 96 OLMSTED COUNTY COORDINATE SYSTEM

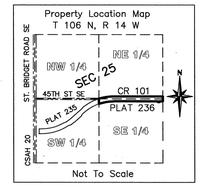

\\co.olmsted.mn.us\data\ERPW\PW_Highway_Engineering\Projects\CR 101\C-20-101\Right of Way\Plats\Plat 236 Amended.dwg